


34  
22  
17  
11  
8.5  
11  
8.5  
17  
22

34  
22  
17  
11  
8.5  
11  
8.5  
17  
22

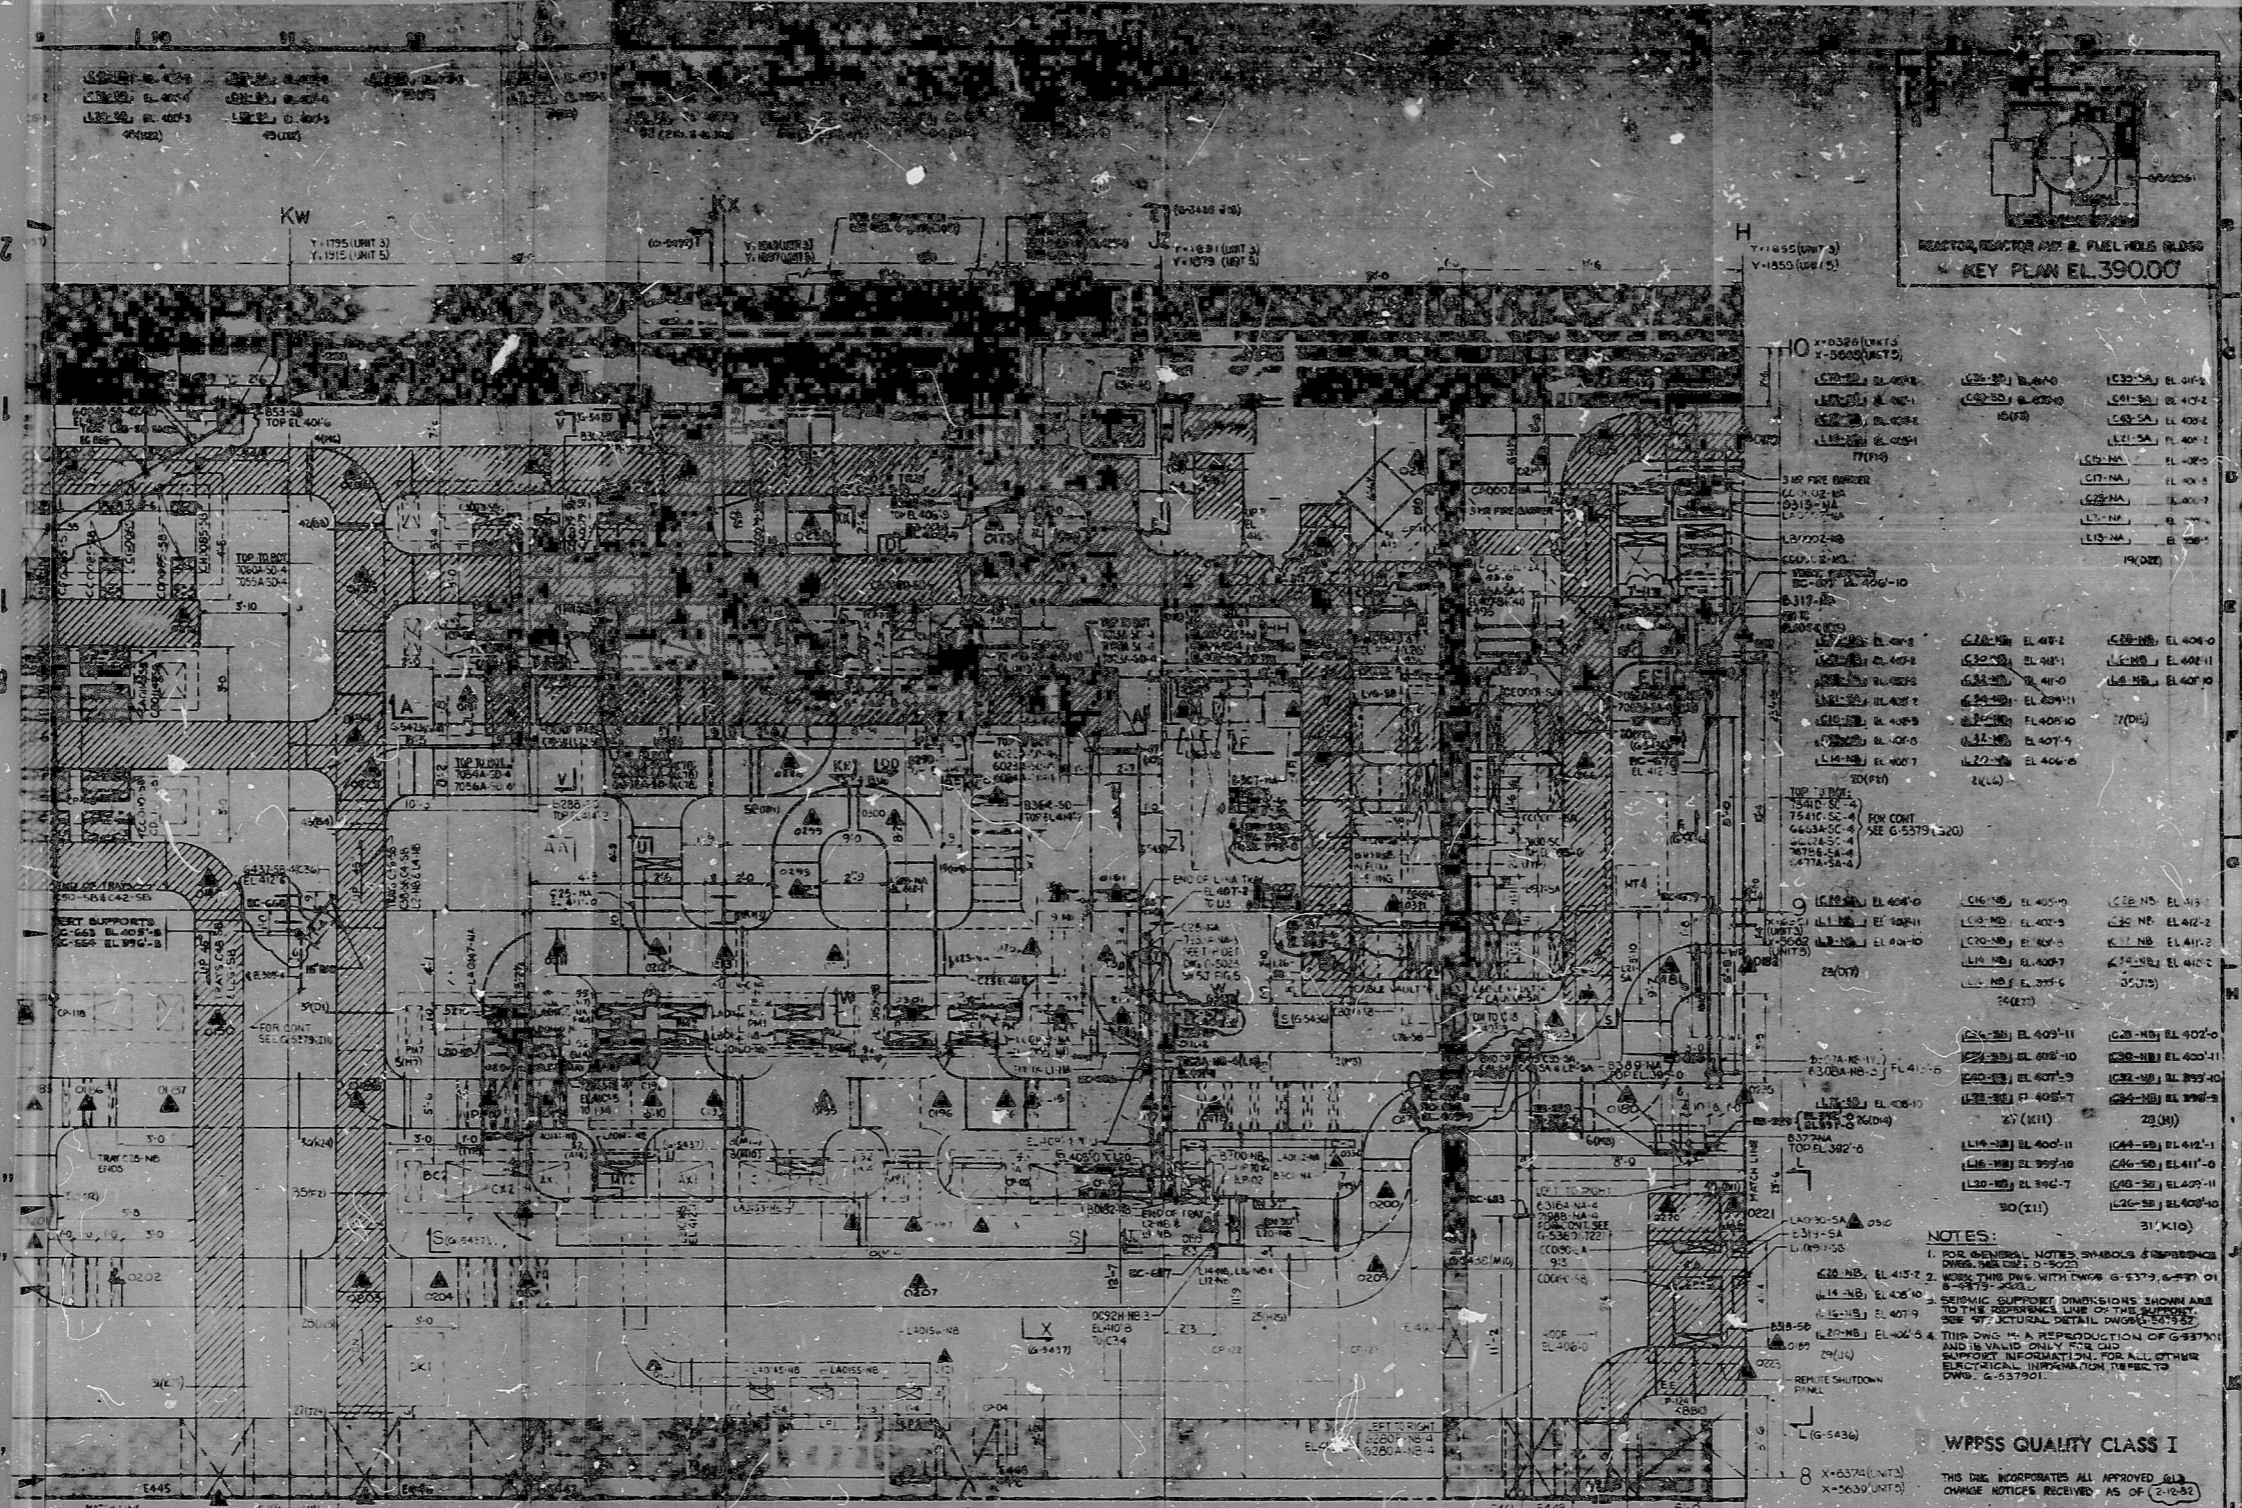

C20-NA	EL 400-0	C21-NA	EL 400-0

**NOTES:**

- FOR GENERAL NOTES SYMBOLS & DIMENSIONS SEE DRAWING SHEET D-3022
- THIS DRAWING IS A REPRODUCTION OF G-5379(1) AND IS VALID ONLY FOR THE SCOPE OF THE ORIGINAL DRAWING. FOR ALL OTHER ELECTRICAL INFORMATION REFER TO DWG. G-5379(1).

**WPPSS QUALITY CLASS I**

THIS DRAWING INCORPORATES ALL APPROVED CHANGE NOTICES RECEIVED AS OF 2-10-82


**APPROVED FOR CONSTRUCTION**

INCORPORATED REVISIONS TO THIS DRAWING:

1. CERTIFIED VENDORS DRAWING FOR CONTROL PANELS.

ALL DETAILS SHOWN ON THIS DRAWING WITHIN THE SCOPE OF THE CONTRACT SHALL BE INCLUDED IN THE CONTRACTOR'S BASE / PROPOSAL PRICE. THE USE OF TERMS SUCH AS "NOT RELEASED" SHALL NOT BE INTERPRETED AS BEING OUTSIDE THE CONTRACTOR'S SCOPE OF WORK.

**POOR ORIGINAL**

INCORPORATED: QPCC-550-REV. 10-56

1 02-52

EL AL

**PRO APERTURE CARD**

**NUCLEAR SAFETY RELATED**

EBASCO  
APR 22 1981

REACTOR BUILDING NO. 3  
COMPLET. SEISMIC SUPPORTS SH4

WPPSS-3240  
G-5450-60

RIDS

8303290644

