


DETAIL 1A


NTS

FOR BOX TYPE I & IV - WALL OR CEILING MOUNTED IN RAB OR FHB, ZONES I & II *

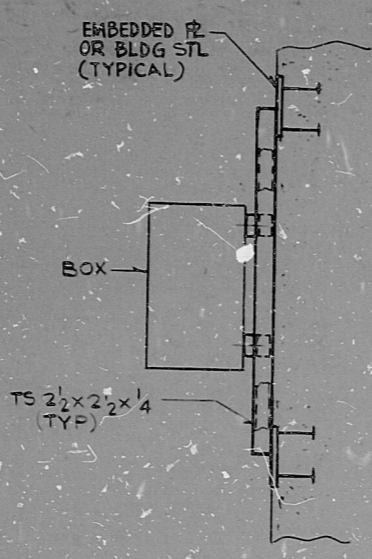

SECTION A-A


NTS

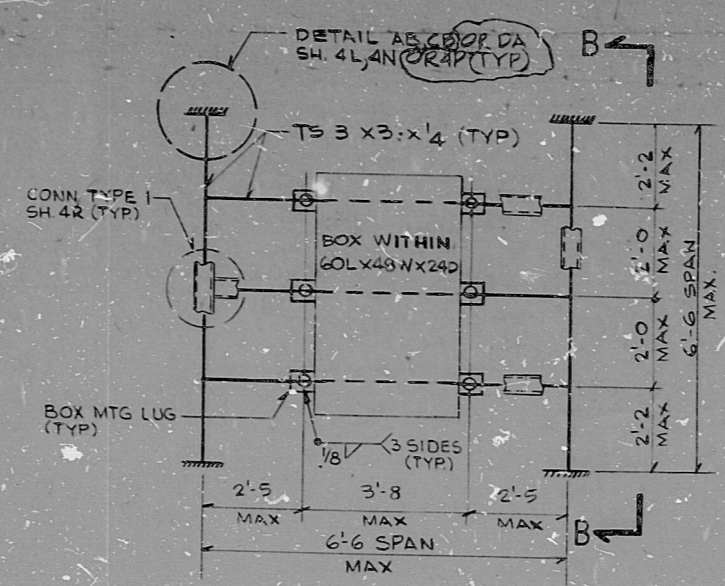

DETAIL 1B


NTS

FOR BOX TYPE I & IV - WALL OR CEILING MOUNTED IN RAB OR FHB, ZONES I & II *

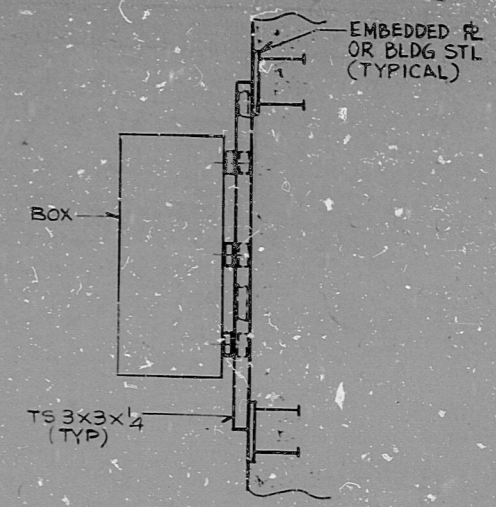

SECTION B-B


NTS

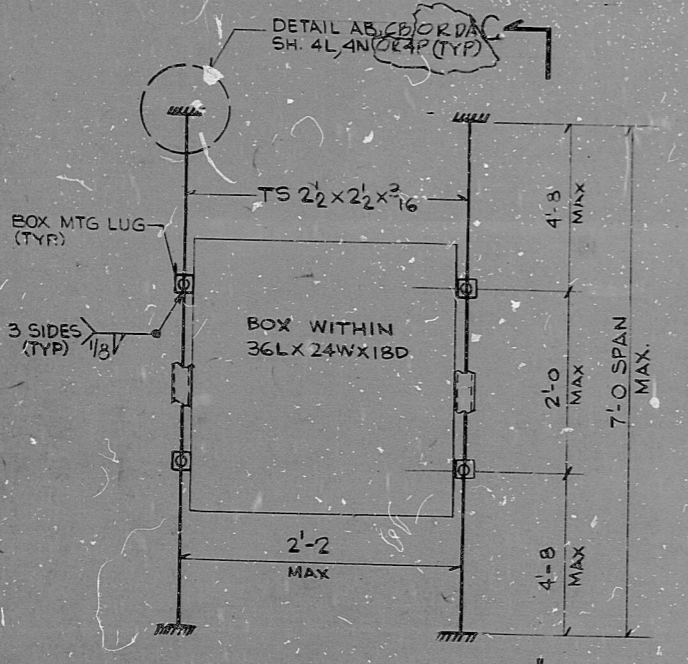

DETAIL 2A


NTS

FOR BOX TYPE I & IV - WALL OR CEILING MOUNTED IN RAB OR FHB, ZONES I & II *

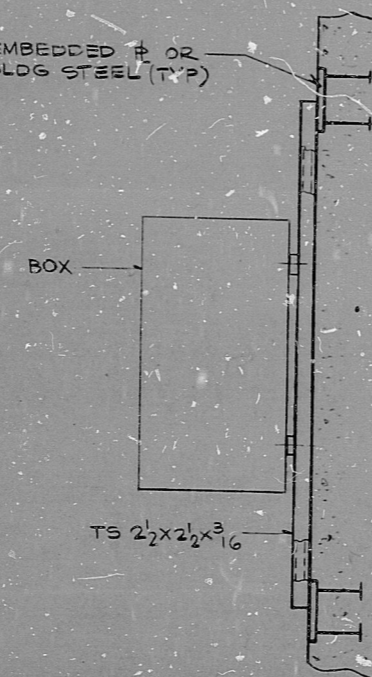

SECTION C-C

NTS

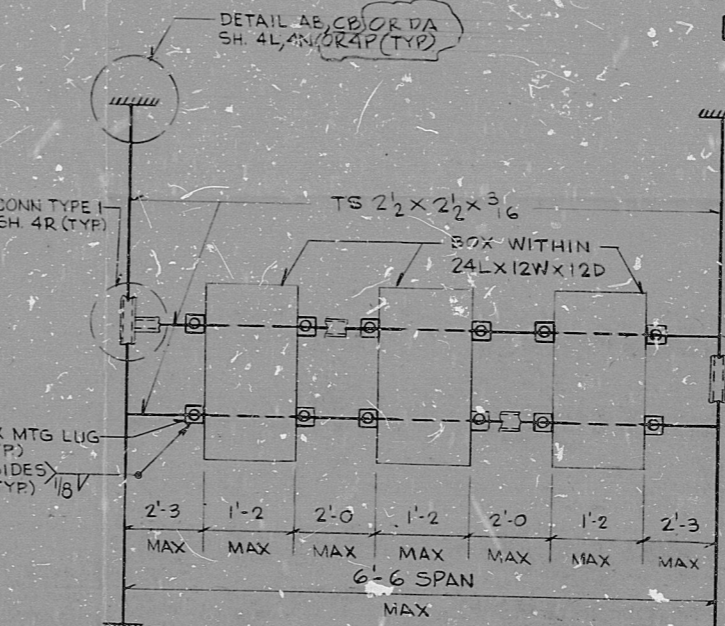

DETAIL 3A

NTS

FOR BOX TYPE I & IV - WALL OR CEILING MOUNTED IN RAB OR FHB, ZONES I & II *



SECTION D-D

NTS

NOTE:
* FOR DEFINITION OF SEISMIC SUPPORT ZONES I & II SEE DWG P-5023, FIG 3 SH 58-2 (GEN NOTES, SYM & REF DWGS)

THIS SHEET IS FOR SEISMIC APPLICATIONS IN RAB AND FHB ONLY.

REVISION 2 DWG REDRAWN

REV.	DATE	BY	APPROVED
4			
3	7-31-81	JSA	[Signature]
2	12-1-80	LM	[Signature]
1	4/10/79	FDB	LM

EBASCO SERVICES INCORPORATED
DIV. ELECT. DR. L.G.D.
CH. F. D. BEANE
DATE JULY 3, 1978

NUCLEAR SAFETY RELATED

WPPSS QUALITY CLASS II & G

WASHINGTON PUBLIC POWER SUPPLY SYSTEM
NUCLEAR PROJECTS NO. 3 & 5
BOX DETAILS
SEISMIC MOUNTING DETAILS

WPPS-3240
D-5033
SHEET 4

RIDS

8303290702

