



DETAIL 4A NTS
SECTION A-A NTS

FOR BOX TYPE I & IV - WALL OR CEILING MOUNTED IN RAB OR FHB, ZONES I & II *

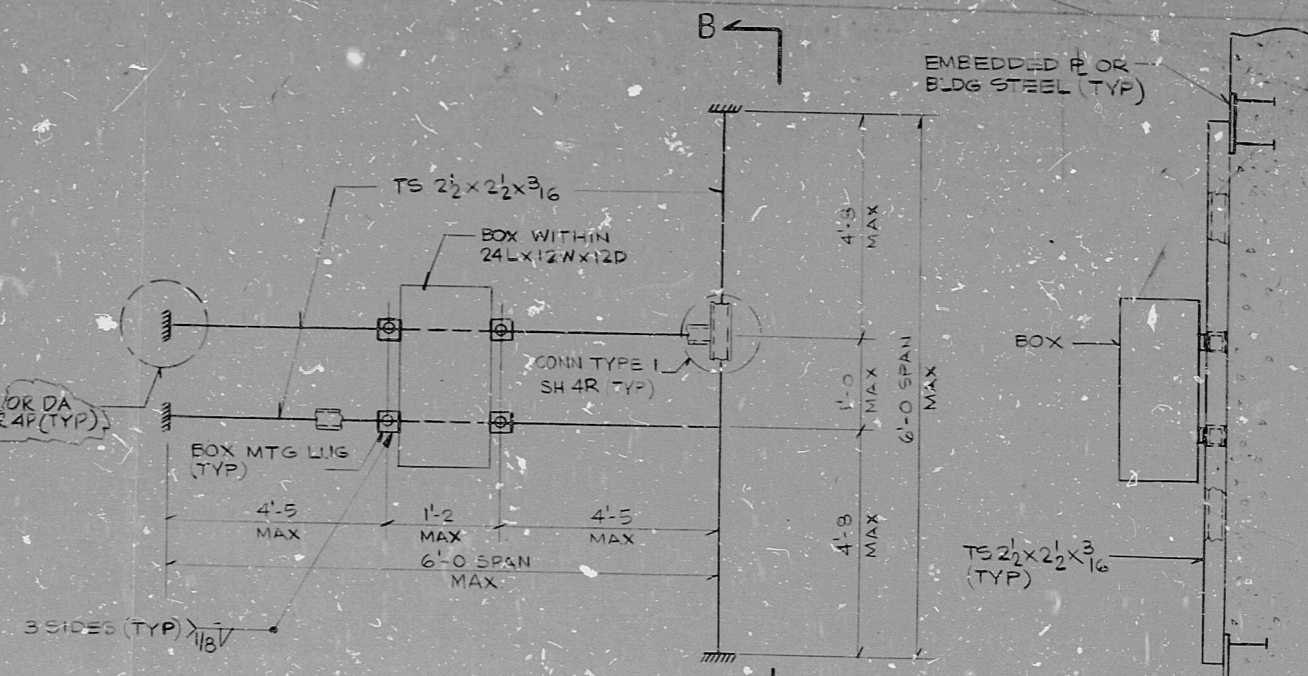


DETAIL 5A NTS
SECTION B-B NTS

FOR BOX TYPE I & IV - WALL OR CEILING MOUNTED IN RAB OR FHB, ZONES I & II *

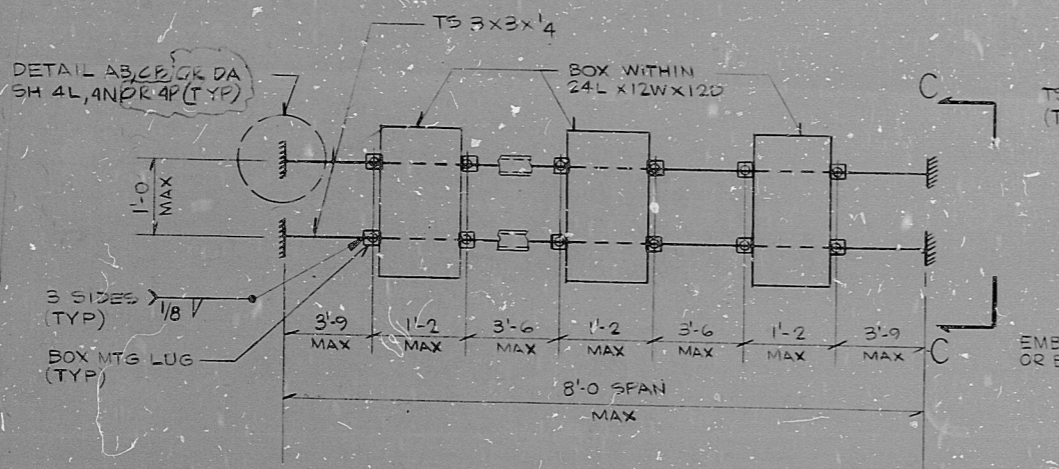

DETAIL 6A NTS
SECTION C-C NTS

FOR BOX TYPE I & IV - WALL OR CEILING MOUNTED IN RAB OR FHB, ZONES I & II *

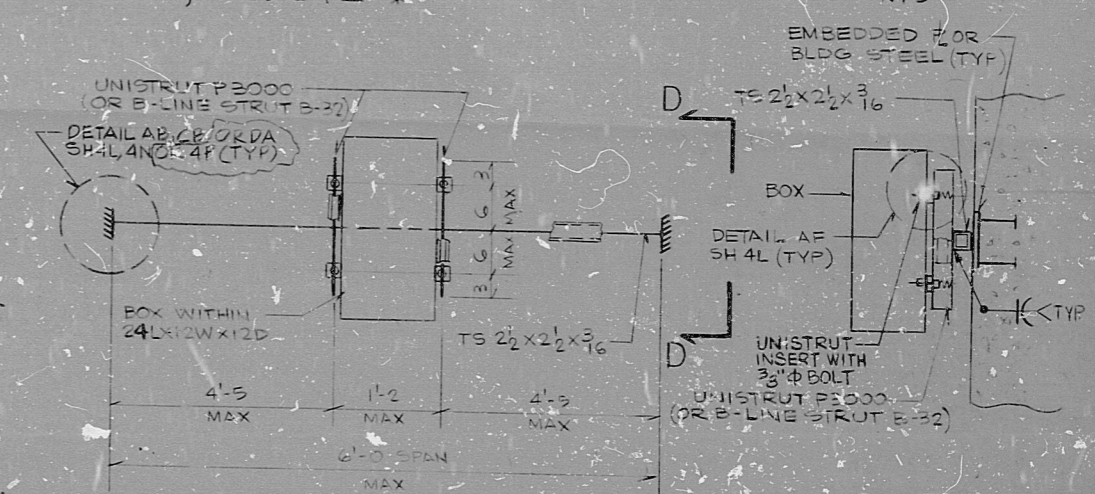

DETAIL 7A NTS
SECTION D-D NTS

FOR BOX TYPE I & IV - WALL OR CEILING MOUNTED IN RAB OR FHB, ZONES I & II *

NOTE:
* FOR DEFINITION OF SEISMIC SUPPORT ZONES I & II SEE DWG D-5023 FIG 3 SH 55-2 (GEN NOTES, SYM & REF DWGS)

THIS SHEET IS FOR SEISMIC APPLICATIONS IN RAB AND FHB ONLY.

REVISION 1 DWG REDRAWN

REV.	DATE	BY	APPROVED
5			
4			
3	7-31-81	JSA	L.M.H.C.
2	3-6-81	SP	RE 11/16
1	12-1-50	WD	L.M.H.C.

EDASCO SERVICES INCORPORATED
DIV. ELEC. DR. JDG.
CH. F.D. BEANE
DATE APR 11, 1979

APPROVED
[Signature]
WPPSS QUALITY CLASS I, II & G
WASHINGTON PUBLIC POWER SUPPLY SYSTEM
NUCLEAR PROJECTS NO. 3 & 5
BOX DETAILS
SEISMIC MOUNTING DETAILS

WPPS-3240
D-5033
SHEET 4A

PRC APERTURE CARD

RIDS

8303290718

