



FIG. 10 1000 C-77 410000

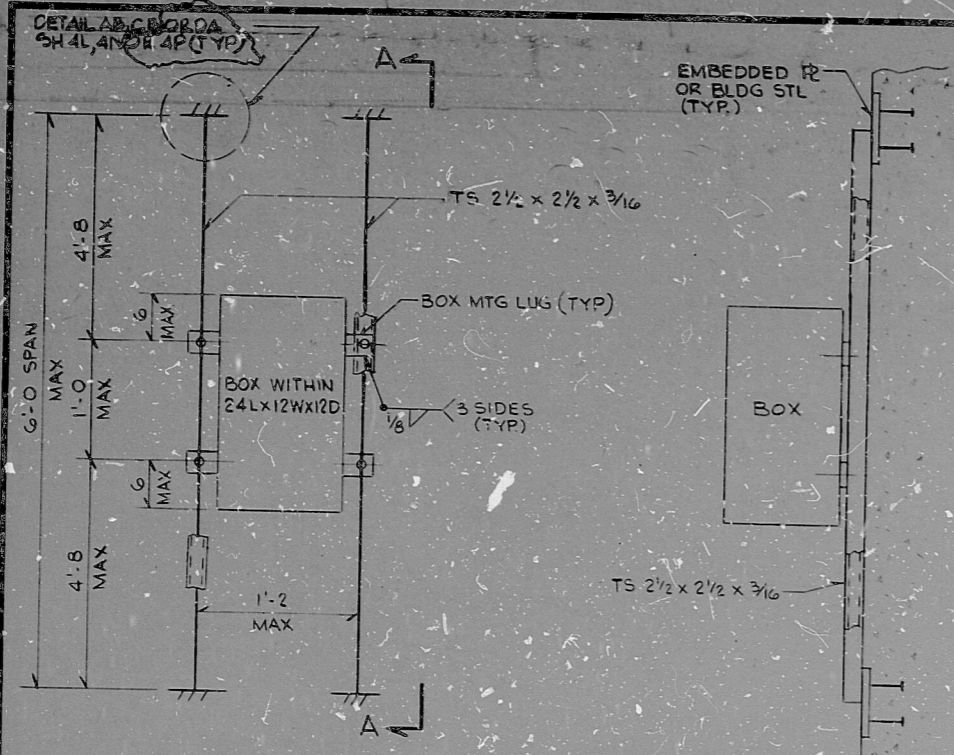

DETAIL 8A
N.T.S.

SECTION A-A
N.T.S.


FOR BOX TYPE I & IV - WALL OR CEILING MOUNTED IN RAB OR FHB, ZONES I & II *

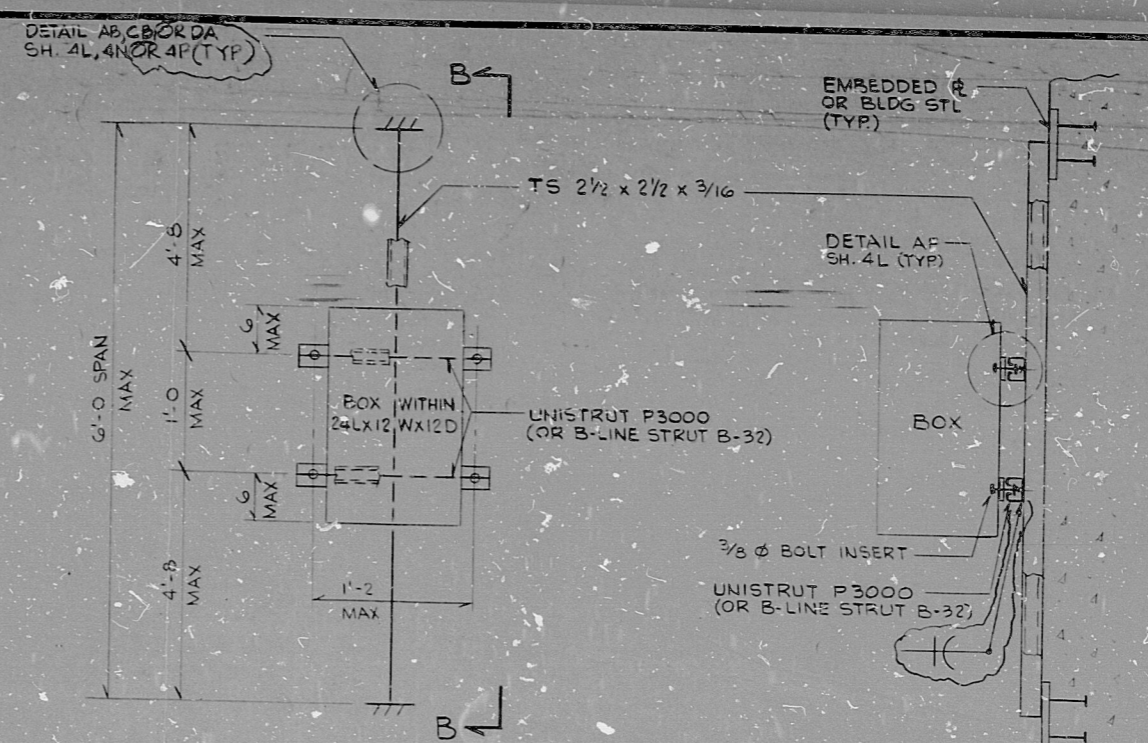

DETAIL 8A (ALTERNATE)
N.T.S.

SECTION B-B
N.T.S.


FOR BOX TYPE I & IV - WALL OR CEILING MOUNTED IN RAB OR FHB, ZONES I & II *

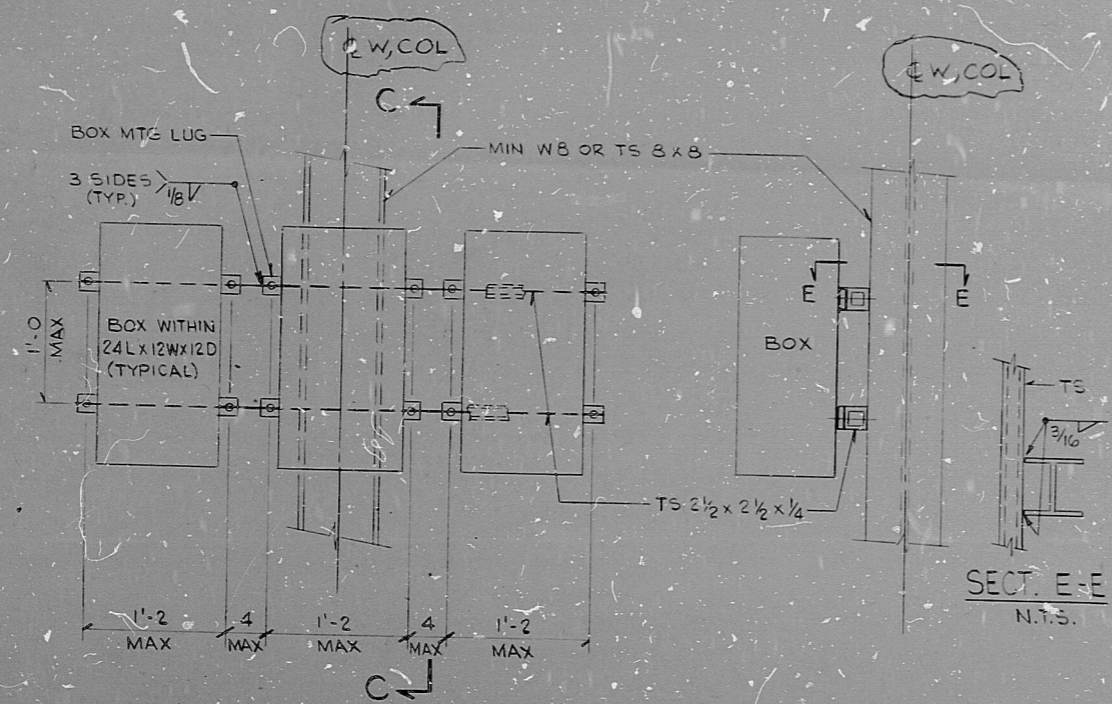

DETAIL 9A
N.T.S.

SECTION C-C
N.T.S.

FOR BOX TYPE I & IV - COLUMN MOUNTED IN RAB OR FHB, ZONE I *

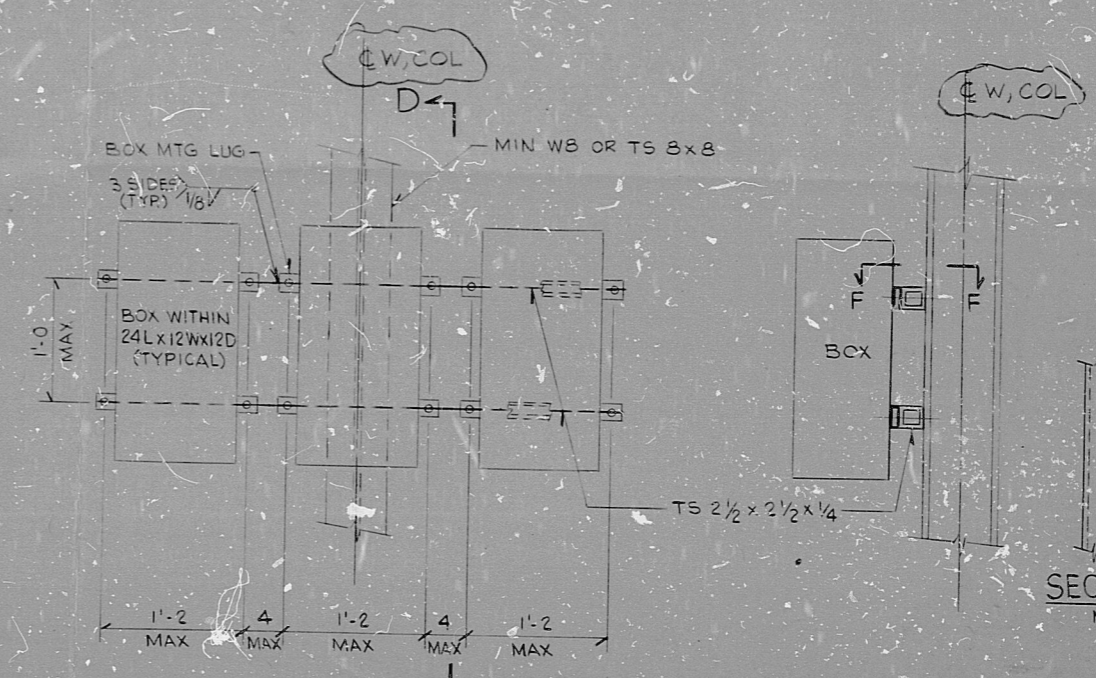

DETAIL 10A
N.T.S.

SECTION D-D
N.T.S.

FOR BOX TYPE I & IV - COLUMN MOUNTED IN RAB OR FHB, ZONE I *

PRC APERTURE CARD

NOTE:
* FOR DEFINITION OF SEISMIC SUPPORT ZONES I & II SEE DWG D-5023, FIG. 3, SH 55-2 (GEN NOTES, SYM. & REF. DWGS)

REVISION 1 DWG REDRAWN

5			
4			
3	7-31-81	JSA	LMH/DFK
2	3-6-81	SP	KE/ML
1	12-1-80	WD	LM/ML
REV	DATE	BY	APPROVED

EBASCO SERVICES INCORPORATED	
DIV. ELECT. DR. J.D.G.	APPROVED
CHK. F.D. BEANE	<i>[Signature]</i>
DATE APR 11, 1979	<i>[Signature]</i>

NUCLEAR SAFETY RELATED		WPPSS QUALITY CLASS I, II & G	
WASHINGTON PUBLIC POWER SUPPLY SYSTEM			
NUCLEAR PROJECTS NO. 3 & 5			
BOX DETAILS		WPPS-3240	
SEISMIC MOUNTING DETAILS		D-5033	
		SHEET 4B	

8.5"
11"
11"

11
8.5"
11"
11"

RIDS

8303290720

