


K&E 10 1223 6-77 416086

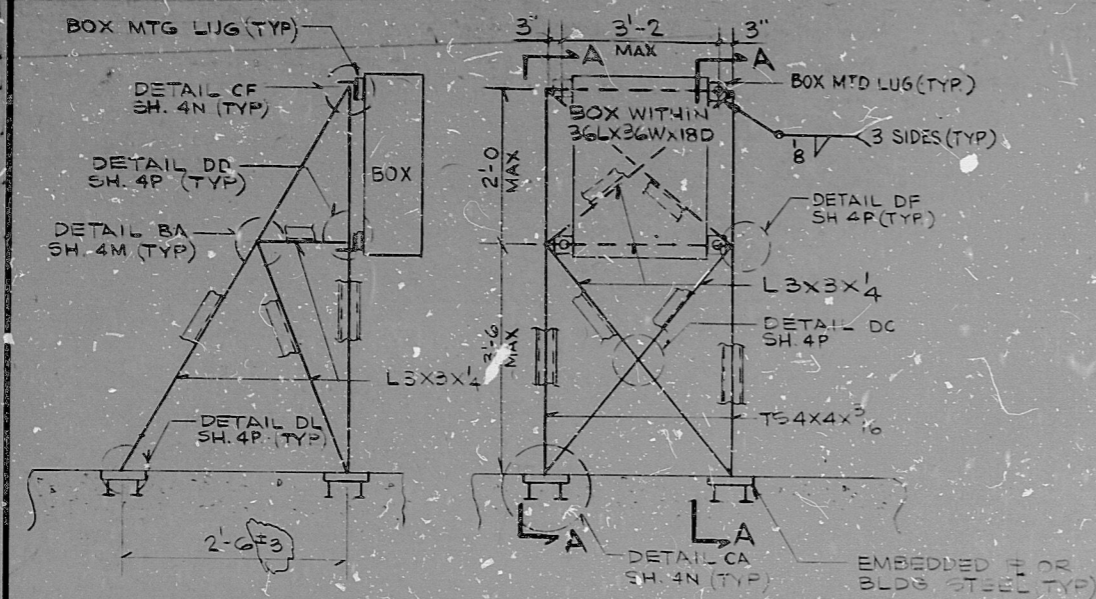


SECTION A-A
(BOTH SIDES)
NTS

FRONT

DETAIL 14-A
NTS

FOR BOX TYPES I AND IV FLOOR
MOUNTED IN RAB OR FHB ZONES I & II *

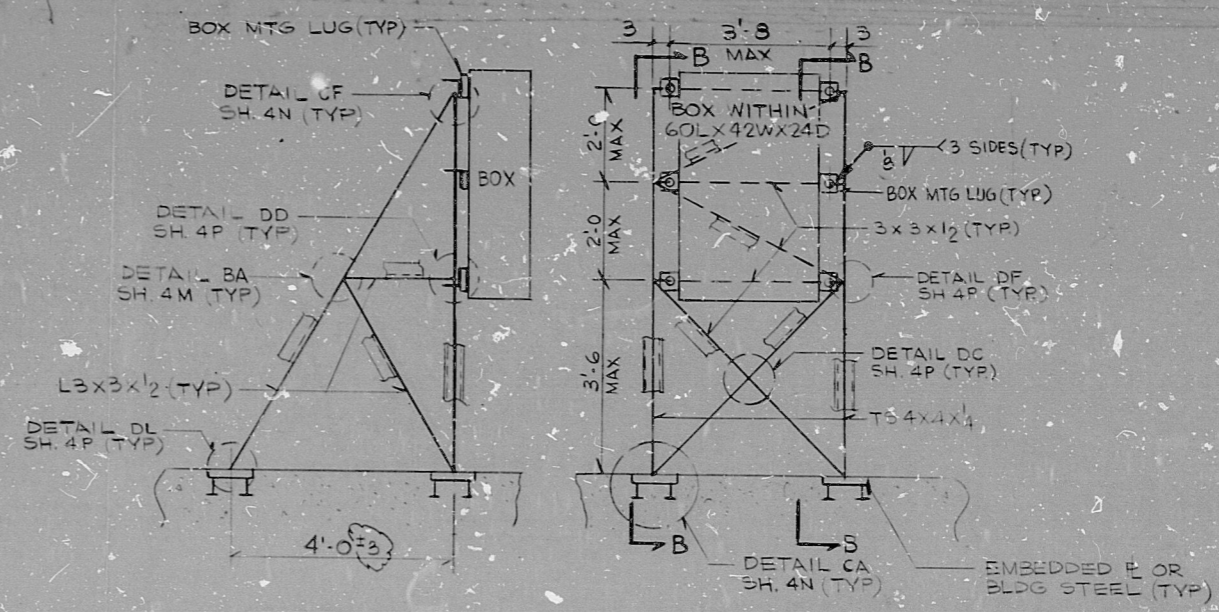

SECTION B-B
(BOTH SIDES)
NTS

FRONT

DETAIL 14-B
NTS

FOR BOX TYPES I AND IV FLOOR
MOUNTED IN RAB OR FHB ZONES I & II *

PRC
APERTURE
CARD

NOTE
* FOR DEFINITION OF SEISMIC SUPPORT ZONES I & II
SEE DWG D-5023 FIG 3 SH 55-2 (GEN NOTES SYM & REF DWGS)

THIS SHEET IS FOR SEISMIC APPLICATIONS IN RAB AND FHB ONLY.

REVISION 1 DWG REDRAWN

EBASCO SERVICES INCORPORATED				NUCLEAR SAFETY RELATED		WPPSS QUALITY CLASS II & G	
5							
4	7-31-81	JSA	LMAY	CIV. ELECT. DR. JDG	APPROVED	WASHINGTON PUBLIC POWER SUPPLY SYSTEM	WPPS-3240
3	3-6-81	SP	K3416	CH. F. D. BEANE	<i>[Signature]</i>	NUCLEAR PROJECTS NO. 3 & 5	D-5033
2						BOX DETAILS	
1	12-1-80	LM	JK	DATE APR 11, 1979	<i>[Signature]</i>	SEISMIC MOUNTING DETAILS	SHEET 4E
REV	DATE	BY	APPROVED	DATE			

11
11
58
88
117
177

11
11
58
88
117
177

RLS

803290726

