
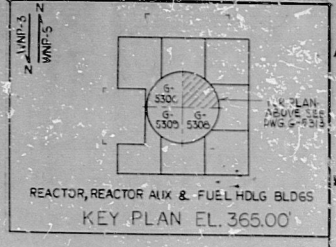


WPPSS-3240-G-5307

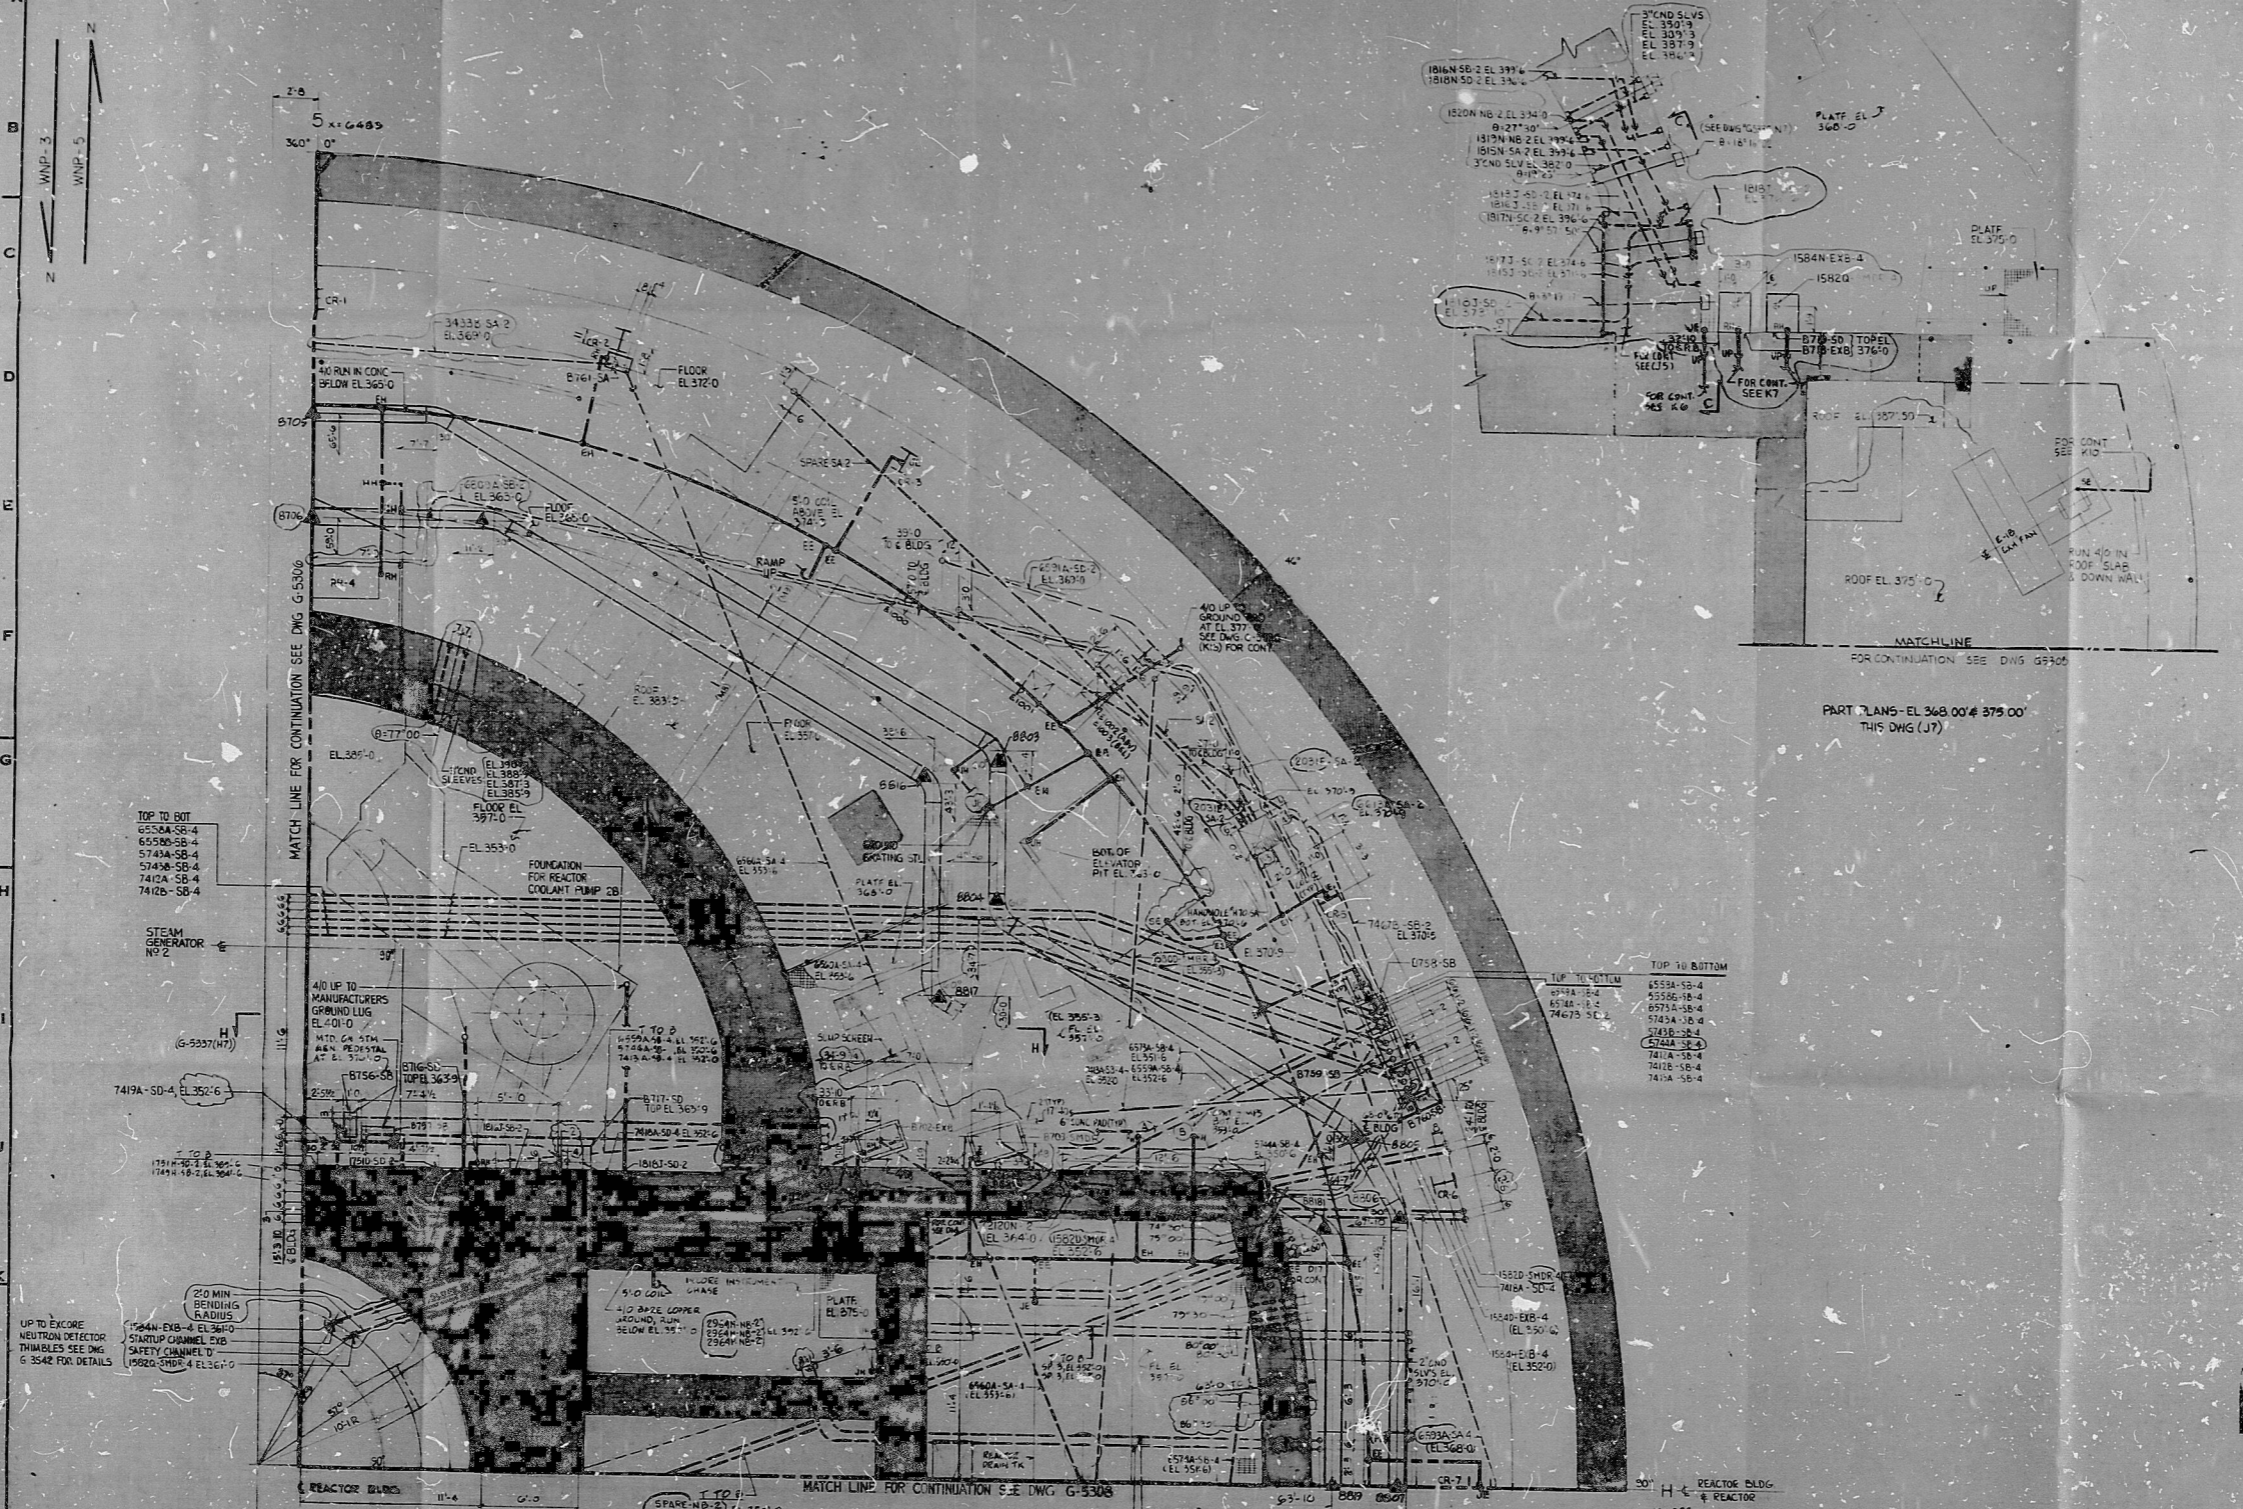

- NOTES:
1. FOR GENERAL NOTES, SYMBOLS & REFERENCE DWGS SEE DWG. D-5005
 2. TRAY DIMENSIONS ARE TO 4 OF REACTOR BUILDINGS UNLESS OTHERWISE NOTED
 3. TRAYS ARE 12" WIDE UNLESS NOTED

THIS DRAWING CONTAINS:
 CONSTRUCTION CONTRACT NO. 265
 CONSTRUCTION CONTRACT NO. 265

THE SCOPE OF THE 265 CONTRACT INCLUDES ALL EMBEDDED ELECTRICAL WORK IN REACTOR BUILDINGS. THE SCOPE OF THE 265 CONTRACT INCLUDES THE INSTALLATION OF ELECTRICAL EQUIPMENT, BOXES, CABLE TRAYS, EXPOSED EQUIPMENT, GROUNDING TERMINATIONS AND EXPOSED CONDUITS. FOR FURTHER DETAILS, SEE CONSTR. SPECIFICATIONS.

APPROVED FOR CONSTRUCTION

THIS DWG. INCORPORATES ALL G.I.S. CHANGE NOTICES RECEIVED AS OF 9-30-81

WPPSS QUALITY CLASS I, II, III

P.R.C. APERTURE CARD



NUCLEAR SAFETY RELATED

WASHINGTON PUBLIC POWER SUPPLY SYSTEM
 NUCLEAR PROJECTS NO. 30.5
 1921-1900 MW INSTALLATION
 1921-1900 MW INSTALLATION
 REACTOR BLDG. EL. 365.00'
 CONDUIT TRAYS & GRDG. SH. 2

| GENERAL REVISION | | NO. | DATE | BY | CHKD. | APP'D. |
|------------------|---------|-----|---------|------|-------|--------|
| 1 | 4-15-80 | 1 | 4-15-80 | WD | MS | MS |
| 2 | 5-15-80 | 2 | 5-15-80 | WD | MS | MS |
| 3 | 11-2-81 | 3 | 11-2-81 | S.F. | R.H. | MS |

ALL DETAILS SHOWN ON THIS DRAWING WITHIN THE SCOPE OF THE CONTRACT SHALL BE INCLUDED IN THE CONTRACTOR'S BASE PROPOSAL PRICE. THE USE OF THESE DWGS AS "NOT RELEASED" SHALL NOT BE INTERPRETED AS DENYING OUTSIDE THE CONTRACTOR'S SCOPE OF WORK.


WPPSS-3240-G-5307

RIDS

8303290860

