


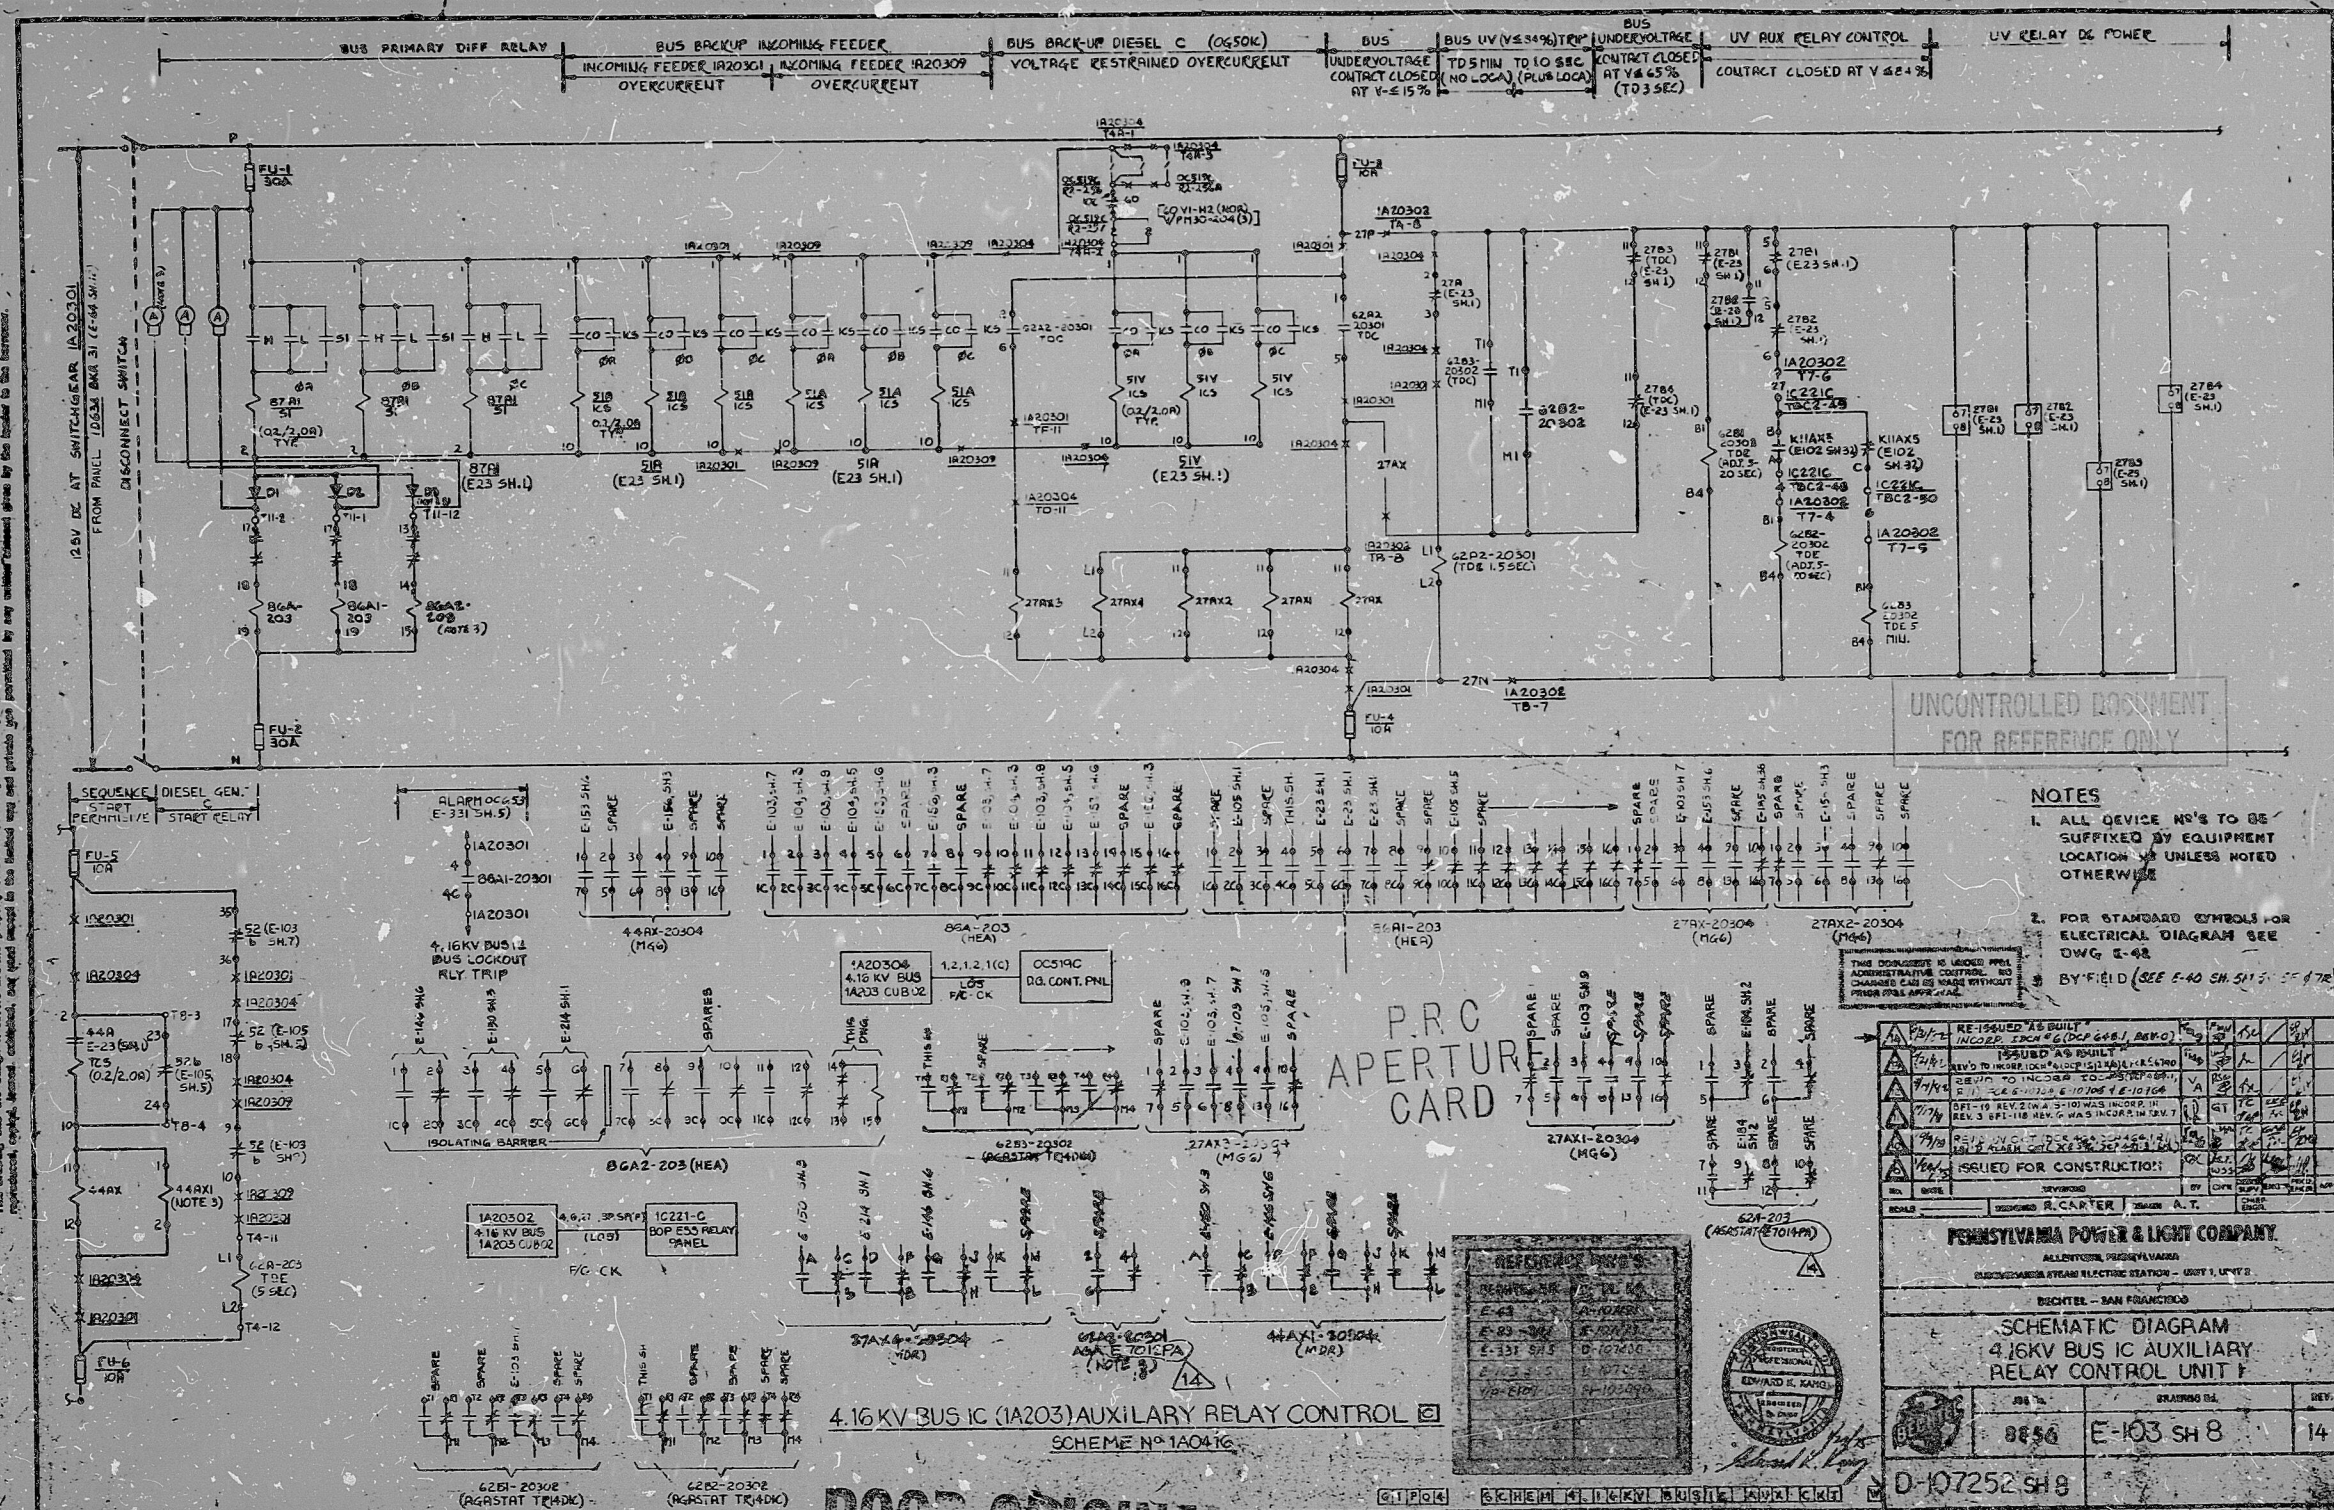

24 X



8303300093

RIDS

