


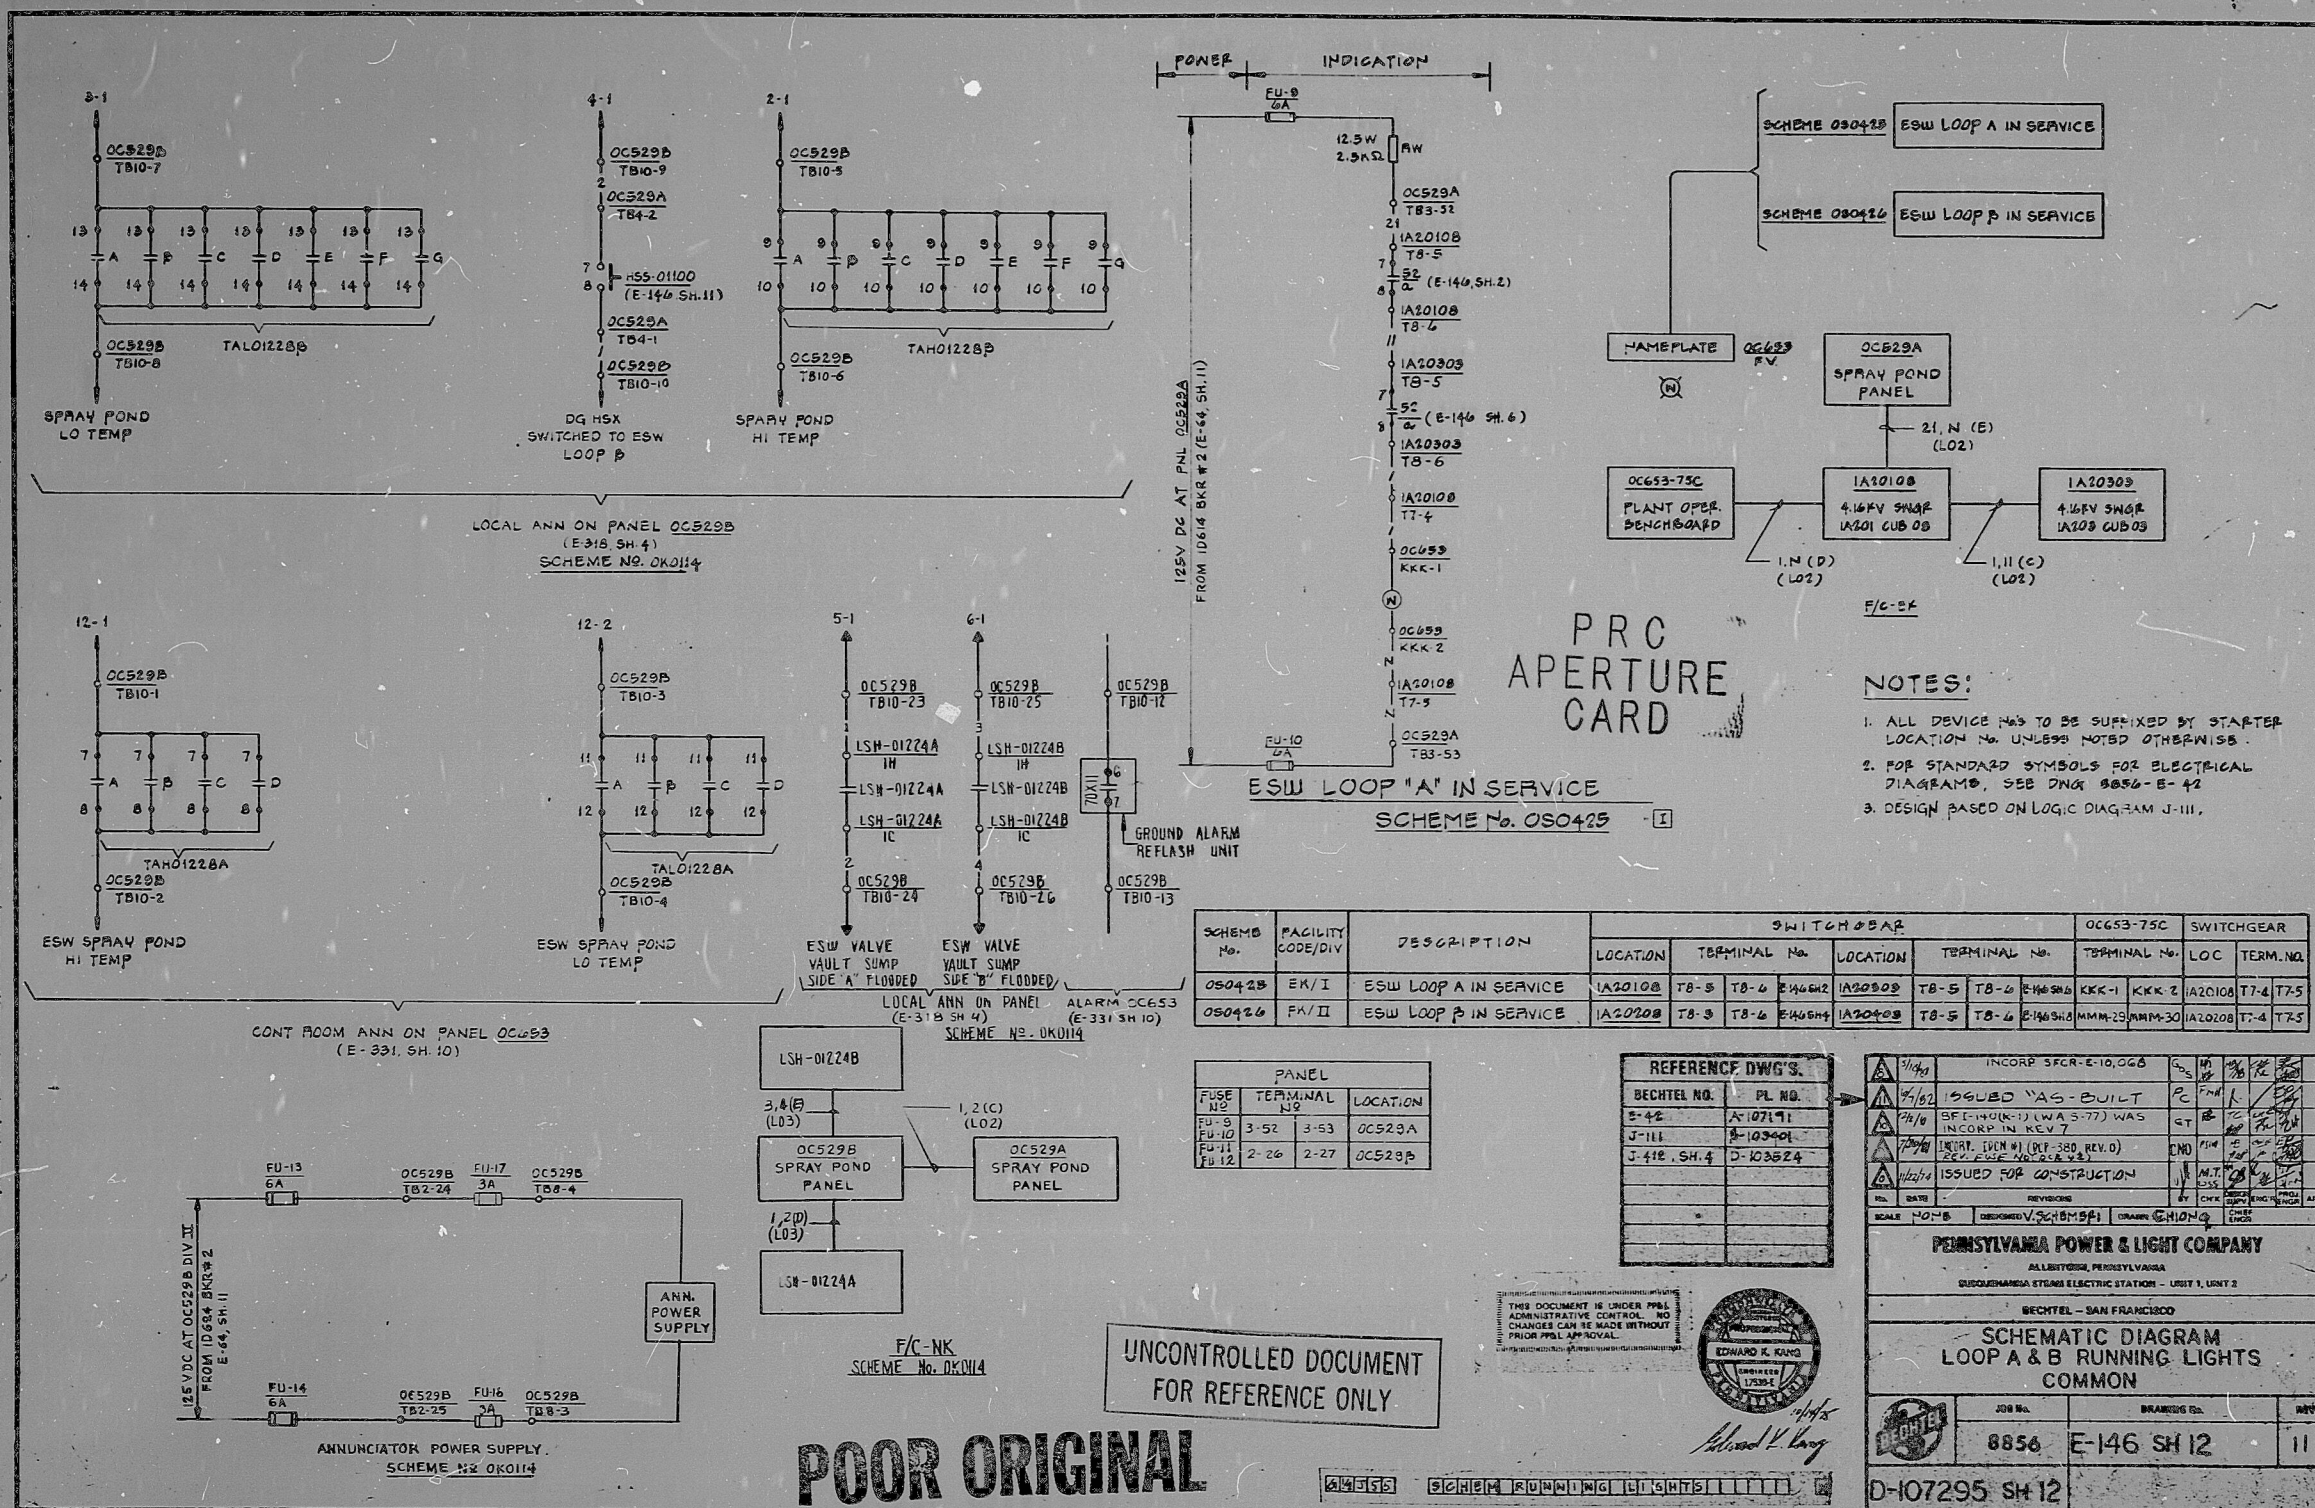

UNCONTROLLED DOCUMENT
FOR REFERENCE ONLY

POOR ORIGINAL

I certify that the microfilmed image contained on this microform were made in the normal and regular course of business. This is a true, full, correct and complete reproduction and replacement for and/or in lieu of original documents generated by the Bechtel group of companies.

Signed JACINFO Date 6-14-82 Camera Operator _____ Camera Type MRU I

	3/9/63	INCORP SEC'R-E-10,368	CND	H	%		
	5/6/63	ISSUED 'AS-BUILT'	P	F	N		
	7/10/63	SF-FINISH (LWA-577) WAS INCORP IN REV 7	E	L			
	10/1/63	INTER. ITEM #1 (REF-350 REV.D) REV. CORR. AS-BUILT	CND	F	N		
	11/15/63	ISSUED FOR CONSTRUCTION	M.T.				
	DATE	REVISIONS	BY	CHKD	DATE	REVISION	APPROV.
SCALE	"O"=8'	DISCREPANCY V.C.H.S.F.A.	CHANGED E-10,368				

PENNSYLVANIA POWER & LIGHT COMPANY


BECHTEL - SAN FRANCISCO

**- SCHEMATIC DIAGRAM
LOOP A & B RUNNING LIGHTS
COMMON**

JOB NO.
8856

DRAWINGS NO.
E-146 SH 12

SHEET
11

D-107295 SH 12

8303300336

KIDS

