


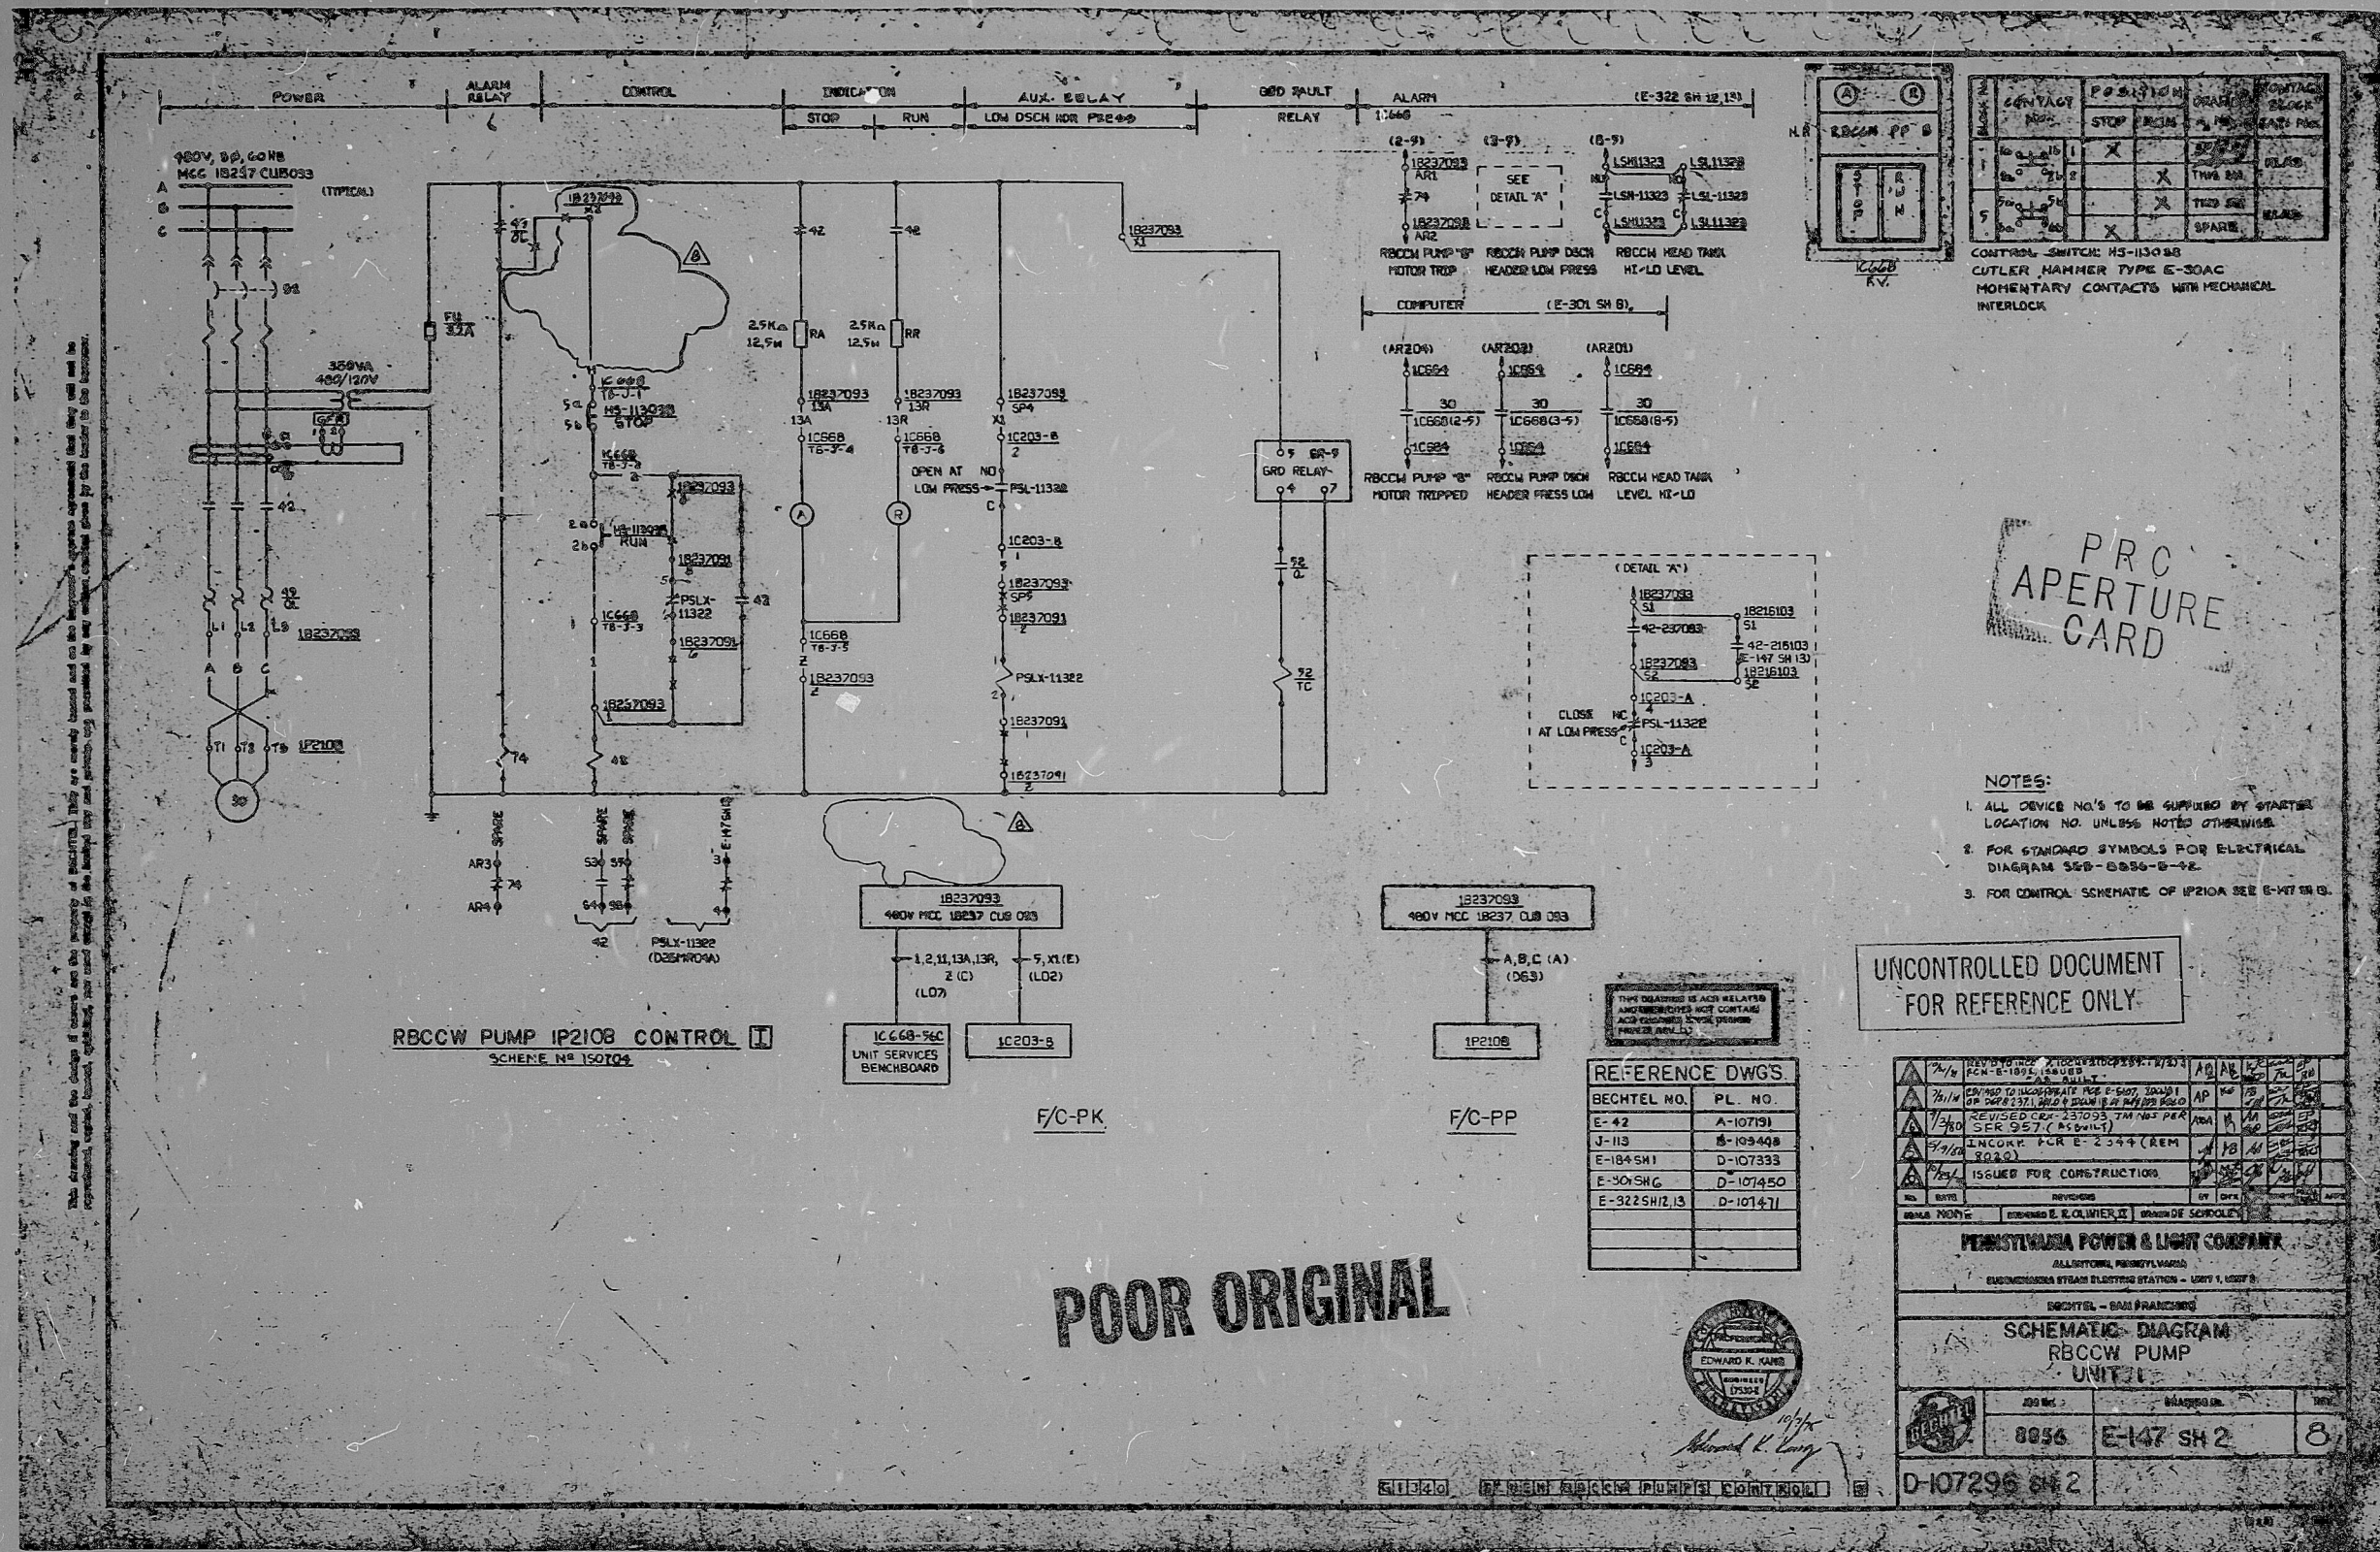

CONTACT	POSITION	OPERATION	CONTACT

CONTROL SWITCH MS-113038
CUTLER HAMMER TYPE E-30AC
MOMENTARY CONTACTS WITH MECHANICAL
INTERLOCK

PRC
APERTURE
CARD

- NOTES:
1. ALL DEVICE NO.'S TO BE SUPPLIED BY STARTER LOCATION NO. UNLESS NOTED OTHERWISE.
 2. FOR STANDARD SYMBOLS FOR ELECTRICAL DIAGRAM SEE E-6056-B-92.
 3. FOR CONTROL SCHEMATIC OF IP2108 SEE E-147 SH 13.

UNCONTROLLED DOCUMENT
FOR REFERENCE ONLY

BECHTEL NO.	PL. NO.
E-42	A-107191
J-113	B-109408
E-1845H	D-107333
E-305HC	D-107450
E-322SH12,13	D-107471

NO.	REV.	REVISION	BY	CHK.	DATE

SCHEMATIC DIAGRAM
RBCCW PUMP
UNIT 1


24X

I certify that the microfilm image contained on this microfilm was made in the normal and regular course of business. This is a true, full, correct and complete reproduction and replacement for and/or in lieu of original documents generated by the Bechtel group of companies.

Sign: Danny Date: 10-1-74 Camera Type: 1000

8303300355

RIDS

