


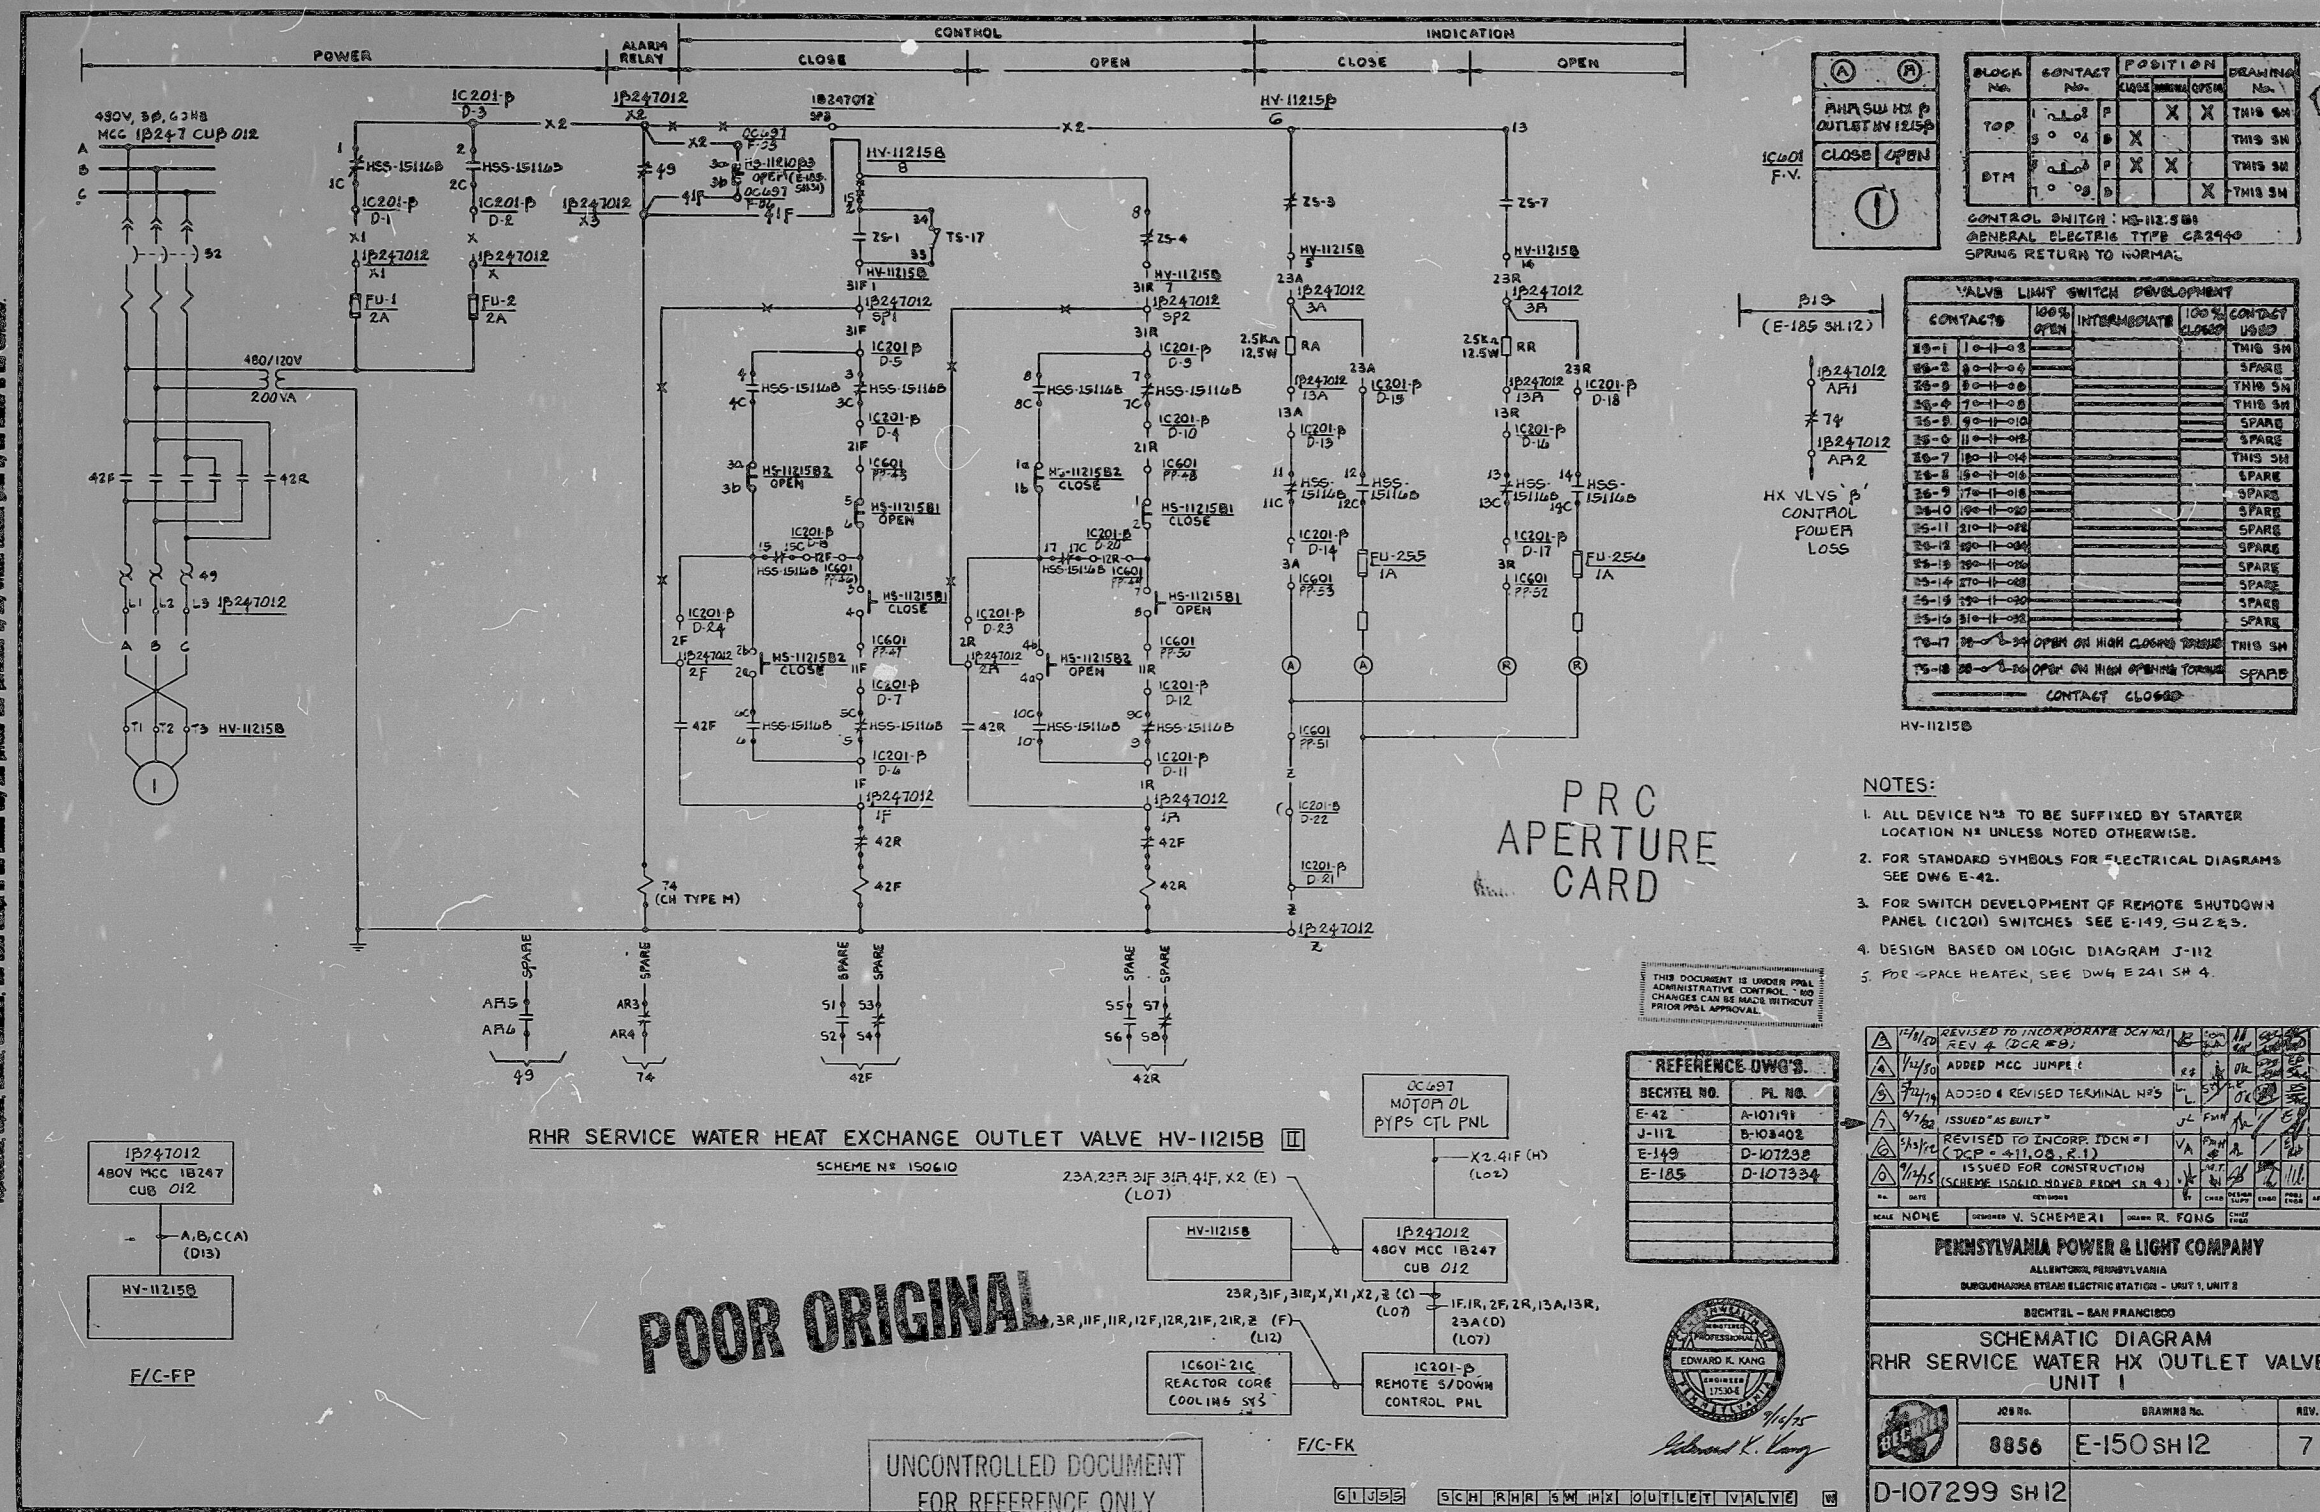

UNCONTROLLED DOCUMENT
FOR REFERENCE ONLY

G	I	J	S	S																
S	C	H	R	H	R	S	W	H	X	O	U	T	L	E	T	V	A	L	V	E

D-107299 SH 12

8303300483

RIDS

