





















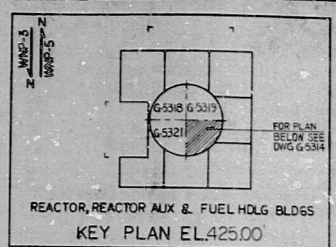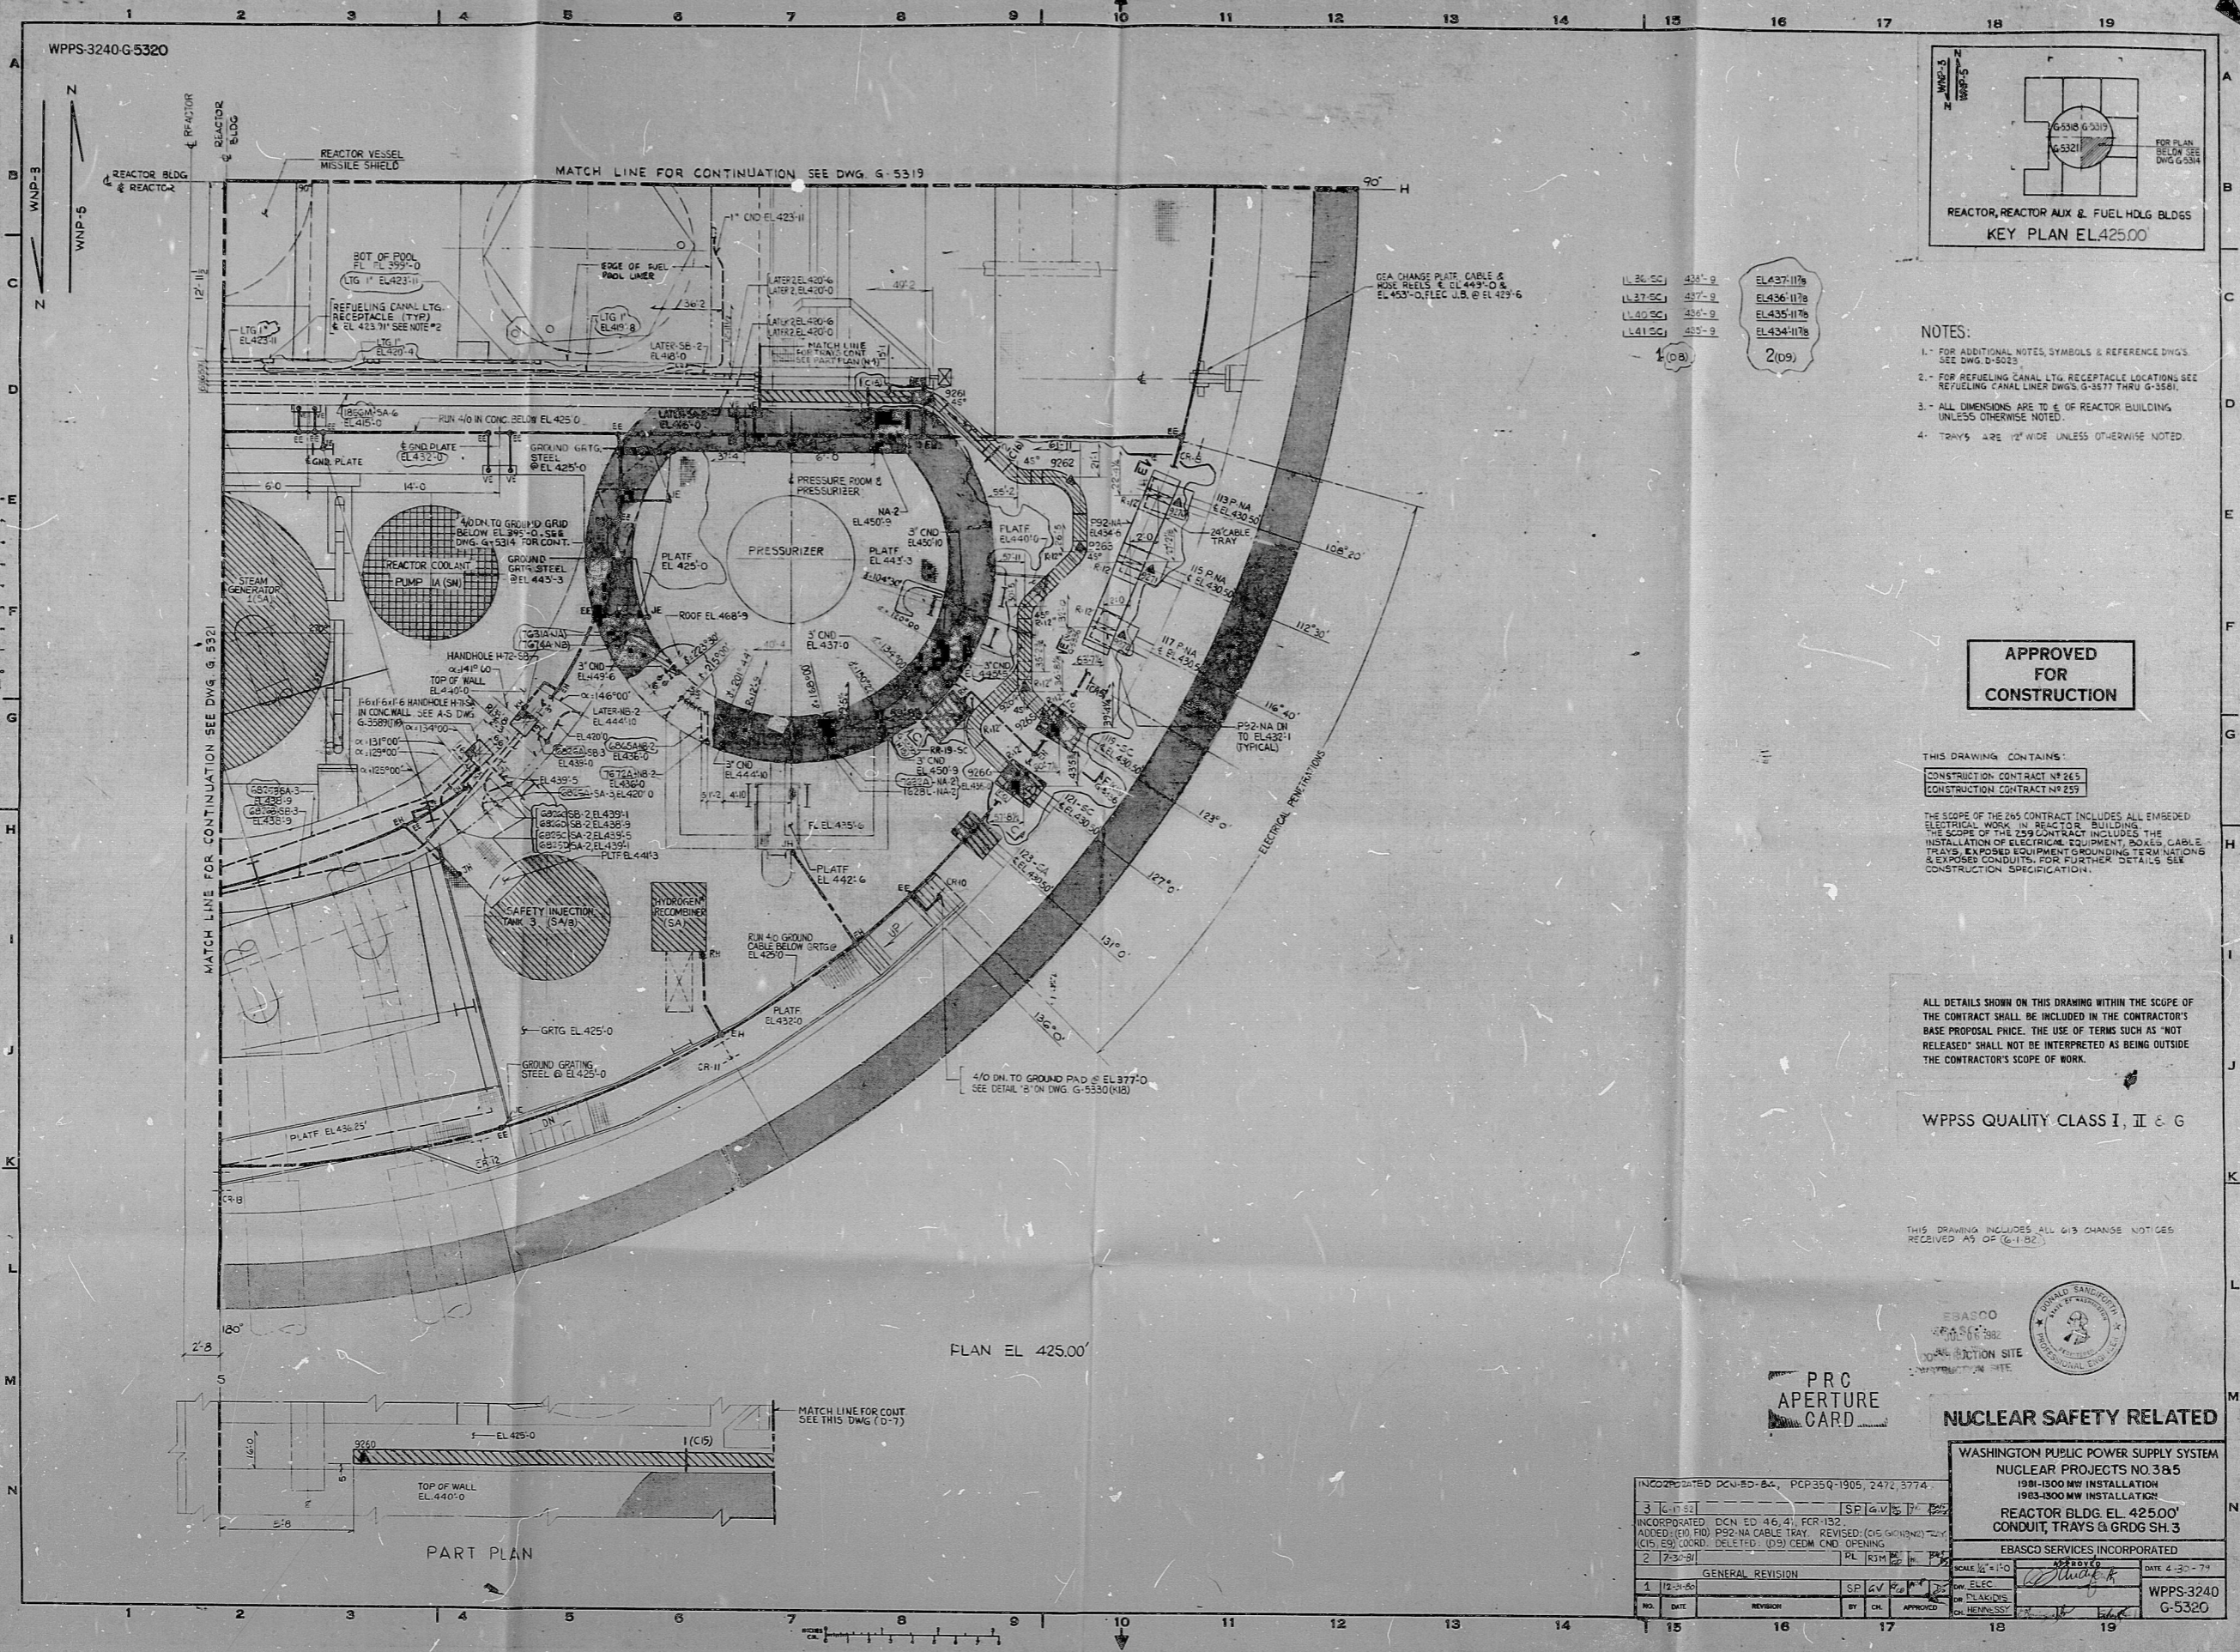

- NOTES:
- FOR ADDITIONAL NOTES, SYMBOLS & REFERENCE DWGS. SEE DWG. D-5025.
 - FOR REFUELING CANAL LTG. RECEPTACLE LOCATIONS SEE REFUELING CANAL LINER DWGS. G-3677 THRU G-3681.
 - ALL DIMENSIONS ARE TO E OF REACTOR BUILDING UNLESS OTHERWISE NOTED.
 - TRAYS ARE 12" WIDE UNLESS OTHERWISE NOTED.

APPROVED FOR CONSTRUCTION

THIS DRAWING CONTAINS:
 CONSTRUCTION CONTRACT NO. 265
 CONSTRUCTION CONTRACT NO. 259

THE SCOPE OF THE 265 CONTRACT INCLUDES ALL EMBEDDED ELECTRICAL WORK IN REACTOR BUILDINGS. THE SCOPE OF THE 259 CONTRACT INCLUDES THE INSTALLATION OF ELECTRICAL EQUIPMENT, BOARDS, CABLE TRAYS, EXPOSED EQUIPMENT GROUNDING TERMINALS & EXPOSED CONDUITS FOR FURTHER DETAILS SEE CONSTRUCTION SPECIFICATION.

ALL DETAILS SHOWN ON THIS DRAWING WITHIN THE SCOPE OF THE CONTRACT SHALL BE INCLUDED IN THE CONTRACTOR'S BASE PROPOSAL PRICE. THE USE OF TERMS SUCH AS "NOT RELEASED" SHALL NOT BE INTERPRETED AS BEING OUTSIDE THE CONTRACTOR'S SCOPE OF WORK.

WPPSS QUALITY CLASS I, II & G

THIS DRAWING INCLUDES ALL G13 CHANGE NOTICES RECEIVED AS OF 6-1-82.



PRC APERTURE CARD

NUCLEAR SAFETY RELATED

NO.	DATE	REVISION	BY	CHK	APPROVED	DATE	BY	CHK	APPROVED

WASHINGTON PUBLIC POWER SUPPLY SYSTEM
 NUCLEAR PROJECTS NO. 3 & 5
 REACTOR BLDG. EL. 425.00
 CONDUIT, TRAYS & GROG SH. 3

EBASCO SERVICES (INCORPORATED)
 SCALE 1/2" = 1'-0"
 DATE 6-20-79
 WPPSS-3240
 G-5320

RIDS

8303300513

