
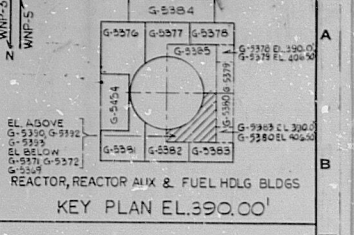


WPPSS 3240 G-5386

Table of electrical callouts and elevations, organized by grid lines. Includes callouts such as (P15-SA) EL 418-1, (C41-SA) EL 409-11, (L23-SA) EL 404-6, etc.

NOTES: 4. 1/4\"

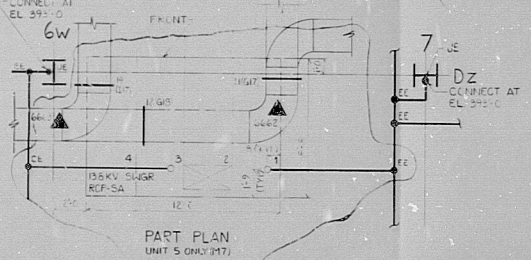

APPROVED FOR CONSTRUCTION

- FOR GENERAL NOTES, SYMBOLS & REFERENCE... 2. ALL TRAY FITTINGS ON THIS DRAWING SHALL HAVE 12\"

WPPSS QUALITY CLASS I II G

POOR ORIGINAL

NUCLEAR SAFETY RELATED WASHINGTON PUBLIC POWER SUPPLY SYSTEM NUCLEAR PROJECTS NO. 385

Revision table with columns for NO., DATE, REVISION, BY, CH, APPROVED. Includes a table for INCORPORATED PCH-EE-314-RP-150-1865-2075-2556-DCH-EO-86.



RIDS

8303300533

