

34

34

22

22

17

17

11

11

8.5

8.5

8.5

8.5

11



11

17

17

22

22

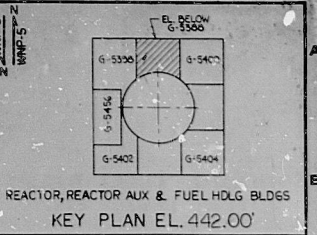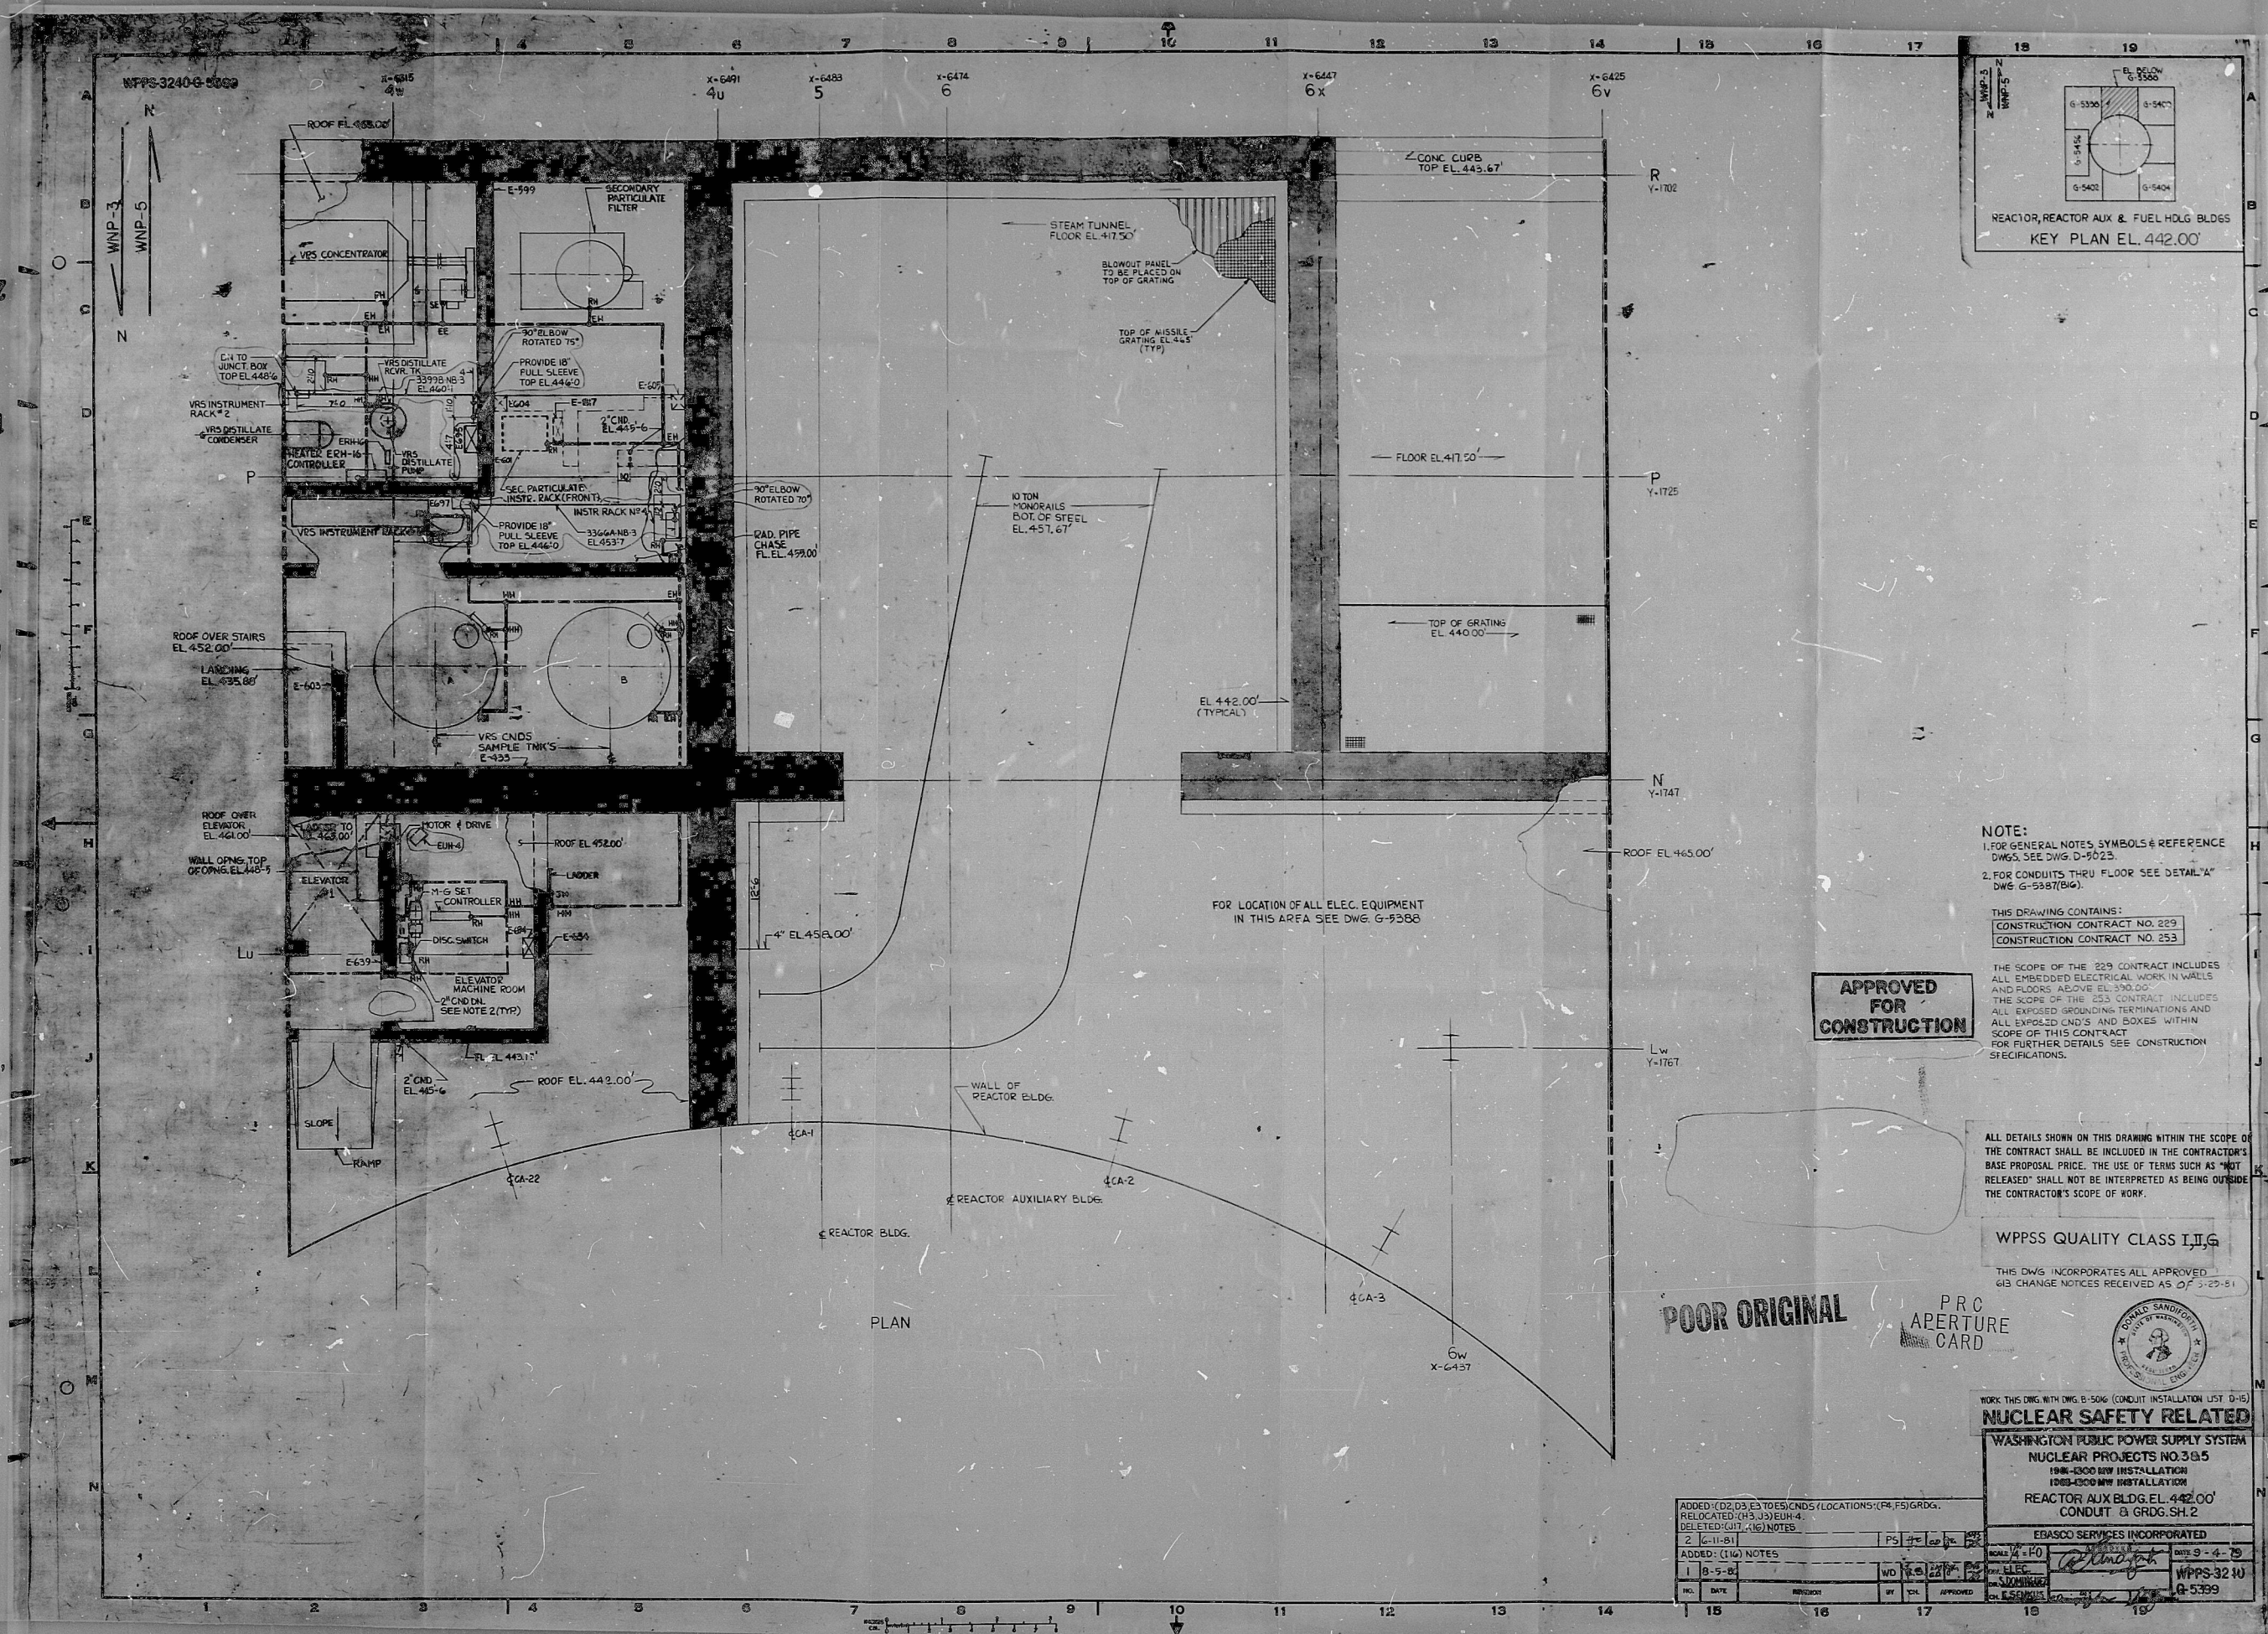

**APPROVED FOR CONSTRUCTION**

**NOTE:**  
1. FOR GENERAL NOTES, SYMBOLS & REFERENCE DWGS. SEE DWG. D-9023.  
2. FOR CONDUITS "THRU FLOOR" SEE DETAIL "A" DWG. G-5387(B4).

THIS DRAWING CONTAINS:  
CONSTRUCTION CONTRACT NO. 229  
CONSTRUCTION CONTRACT NO. 253

THE SCOPE OF THE 229 CONTRACT INCLUDES ALL EMBEDDED ELECTRICAL WORK IN WALLS AND FLOORS ABOVE EL. 390.00'. THE SCOPE OF THE 253 CONTRACT INCLUDES ALL EXPOSED GROUNDING TERMINATIONS AND ALL EXPOSED CND'S AND BOXES WITHIN SCOPE OF THIS CONTRACT. FOR FURTHER DETAILS SEE CONSTRUCTION SPECIFICATIONS.

ALL DETAILS SHOWN ON THIS DRAWING WITHIN THE SCOPE OF THE CONTRACT SHALL BE INCLUDED IN THE CONTRACTOR'S BASE PROPOSAL PRICE. THE USE OF TERMS SUCH AS "NOT RELEASED" SHALL NOT BE INTERPRETED AS BEING OUTSIDE THE CONTRACTOR'S SCOPE OF WORK.

**WPPSS QUALITY CLASS II, G**

THIS DWG. INCORPORATES ALL APPROVED 613 CHANGE NOTICES RECEIVED AS OF 3-29-81

**POOR ORIGINAL**

PROC APERTURE CARD




**NUCLEAR SAFETY RELATED**

WASHINGTON PUBLIC POWER SUPPLY SYSTEM  
NUCLEAR PROJECTS NO. 395  
1963-1300 MW INSTALLATION  
1063-1300 MW INSTALLATION  
REACTOR AUX BLDG. EL. 442.00'  
CONDUIT & GRDG. SH. 2

WPPSS 32 10  
8-5399

ADDED (02, 03, E) TO 53/CNDS (LOCATIONS: (R4, F5) GRDG., RELOCATED (H5, J3) EUM-4, DELETED (U1, (U) NOTES	
ADDED: (116) NOTES	DATE: 9-4-79
1 8-5-81	WPPSS 32 10
2 10-1-81	8-5399

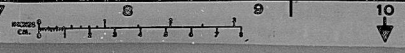

RIDS

8303300550

