

32

32

22

22

17

17

11

11

8.5

8.5

8.5

8.5

11


11

17

17

22

22

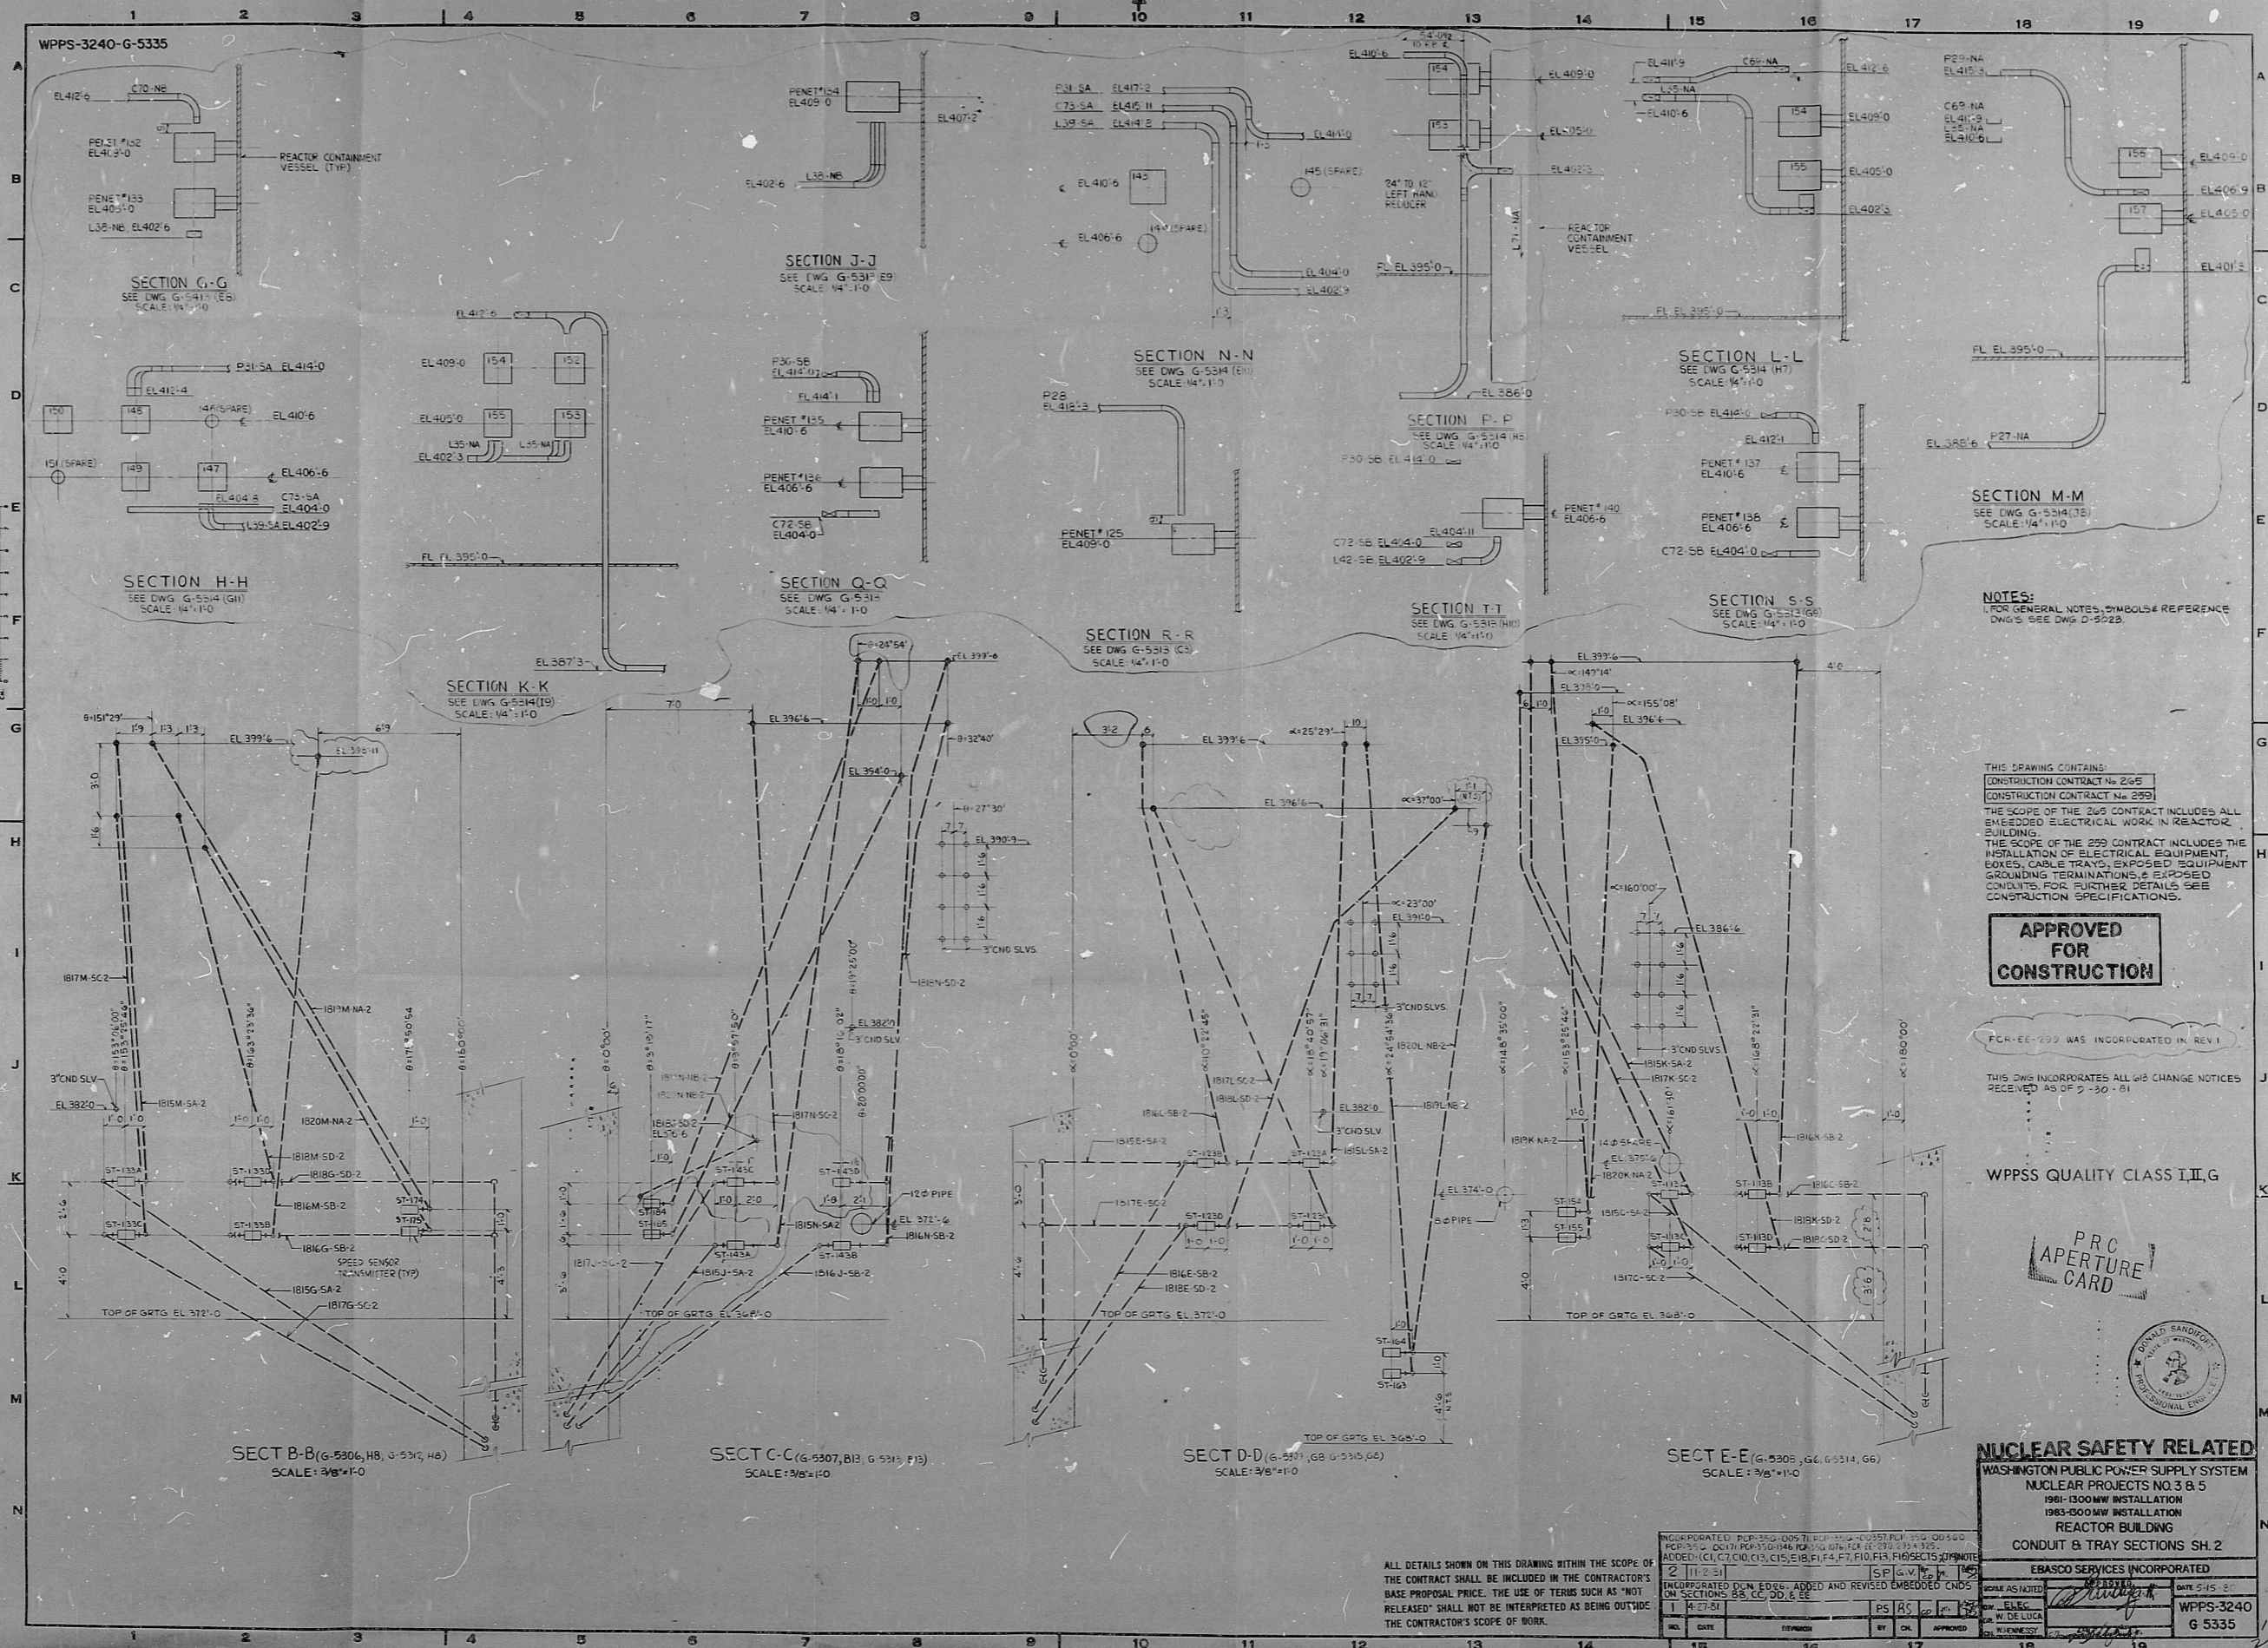

RIDS

8303300560

