
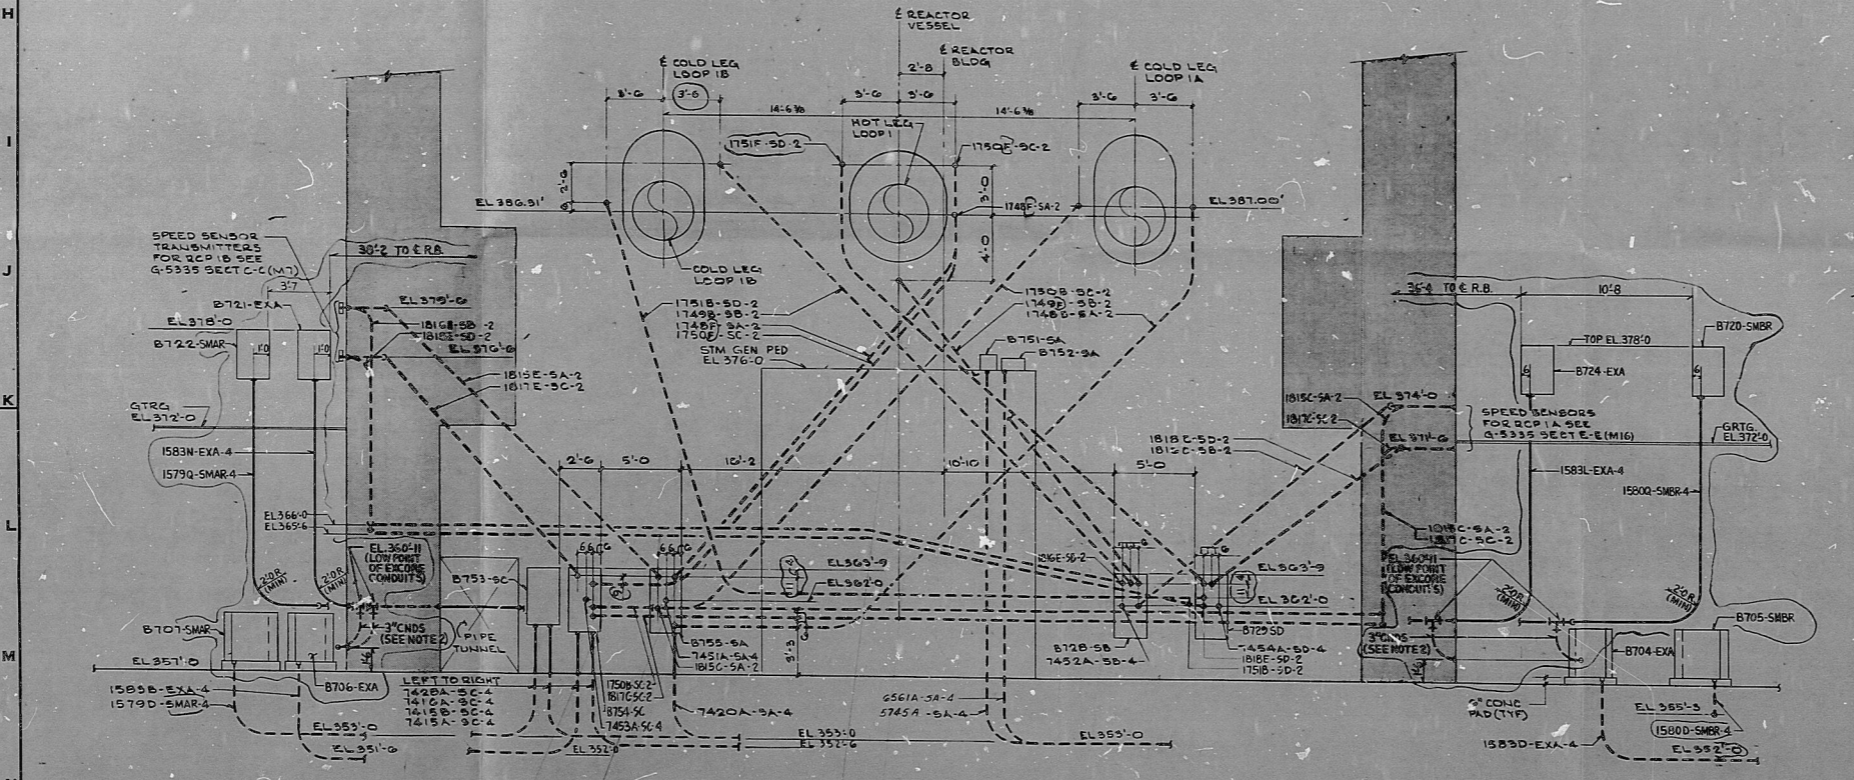


WPPS-3240-G-5337

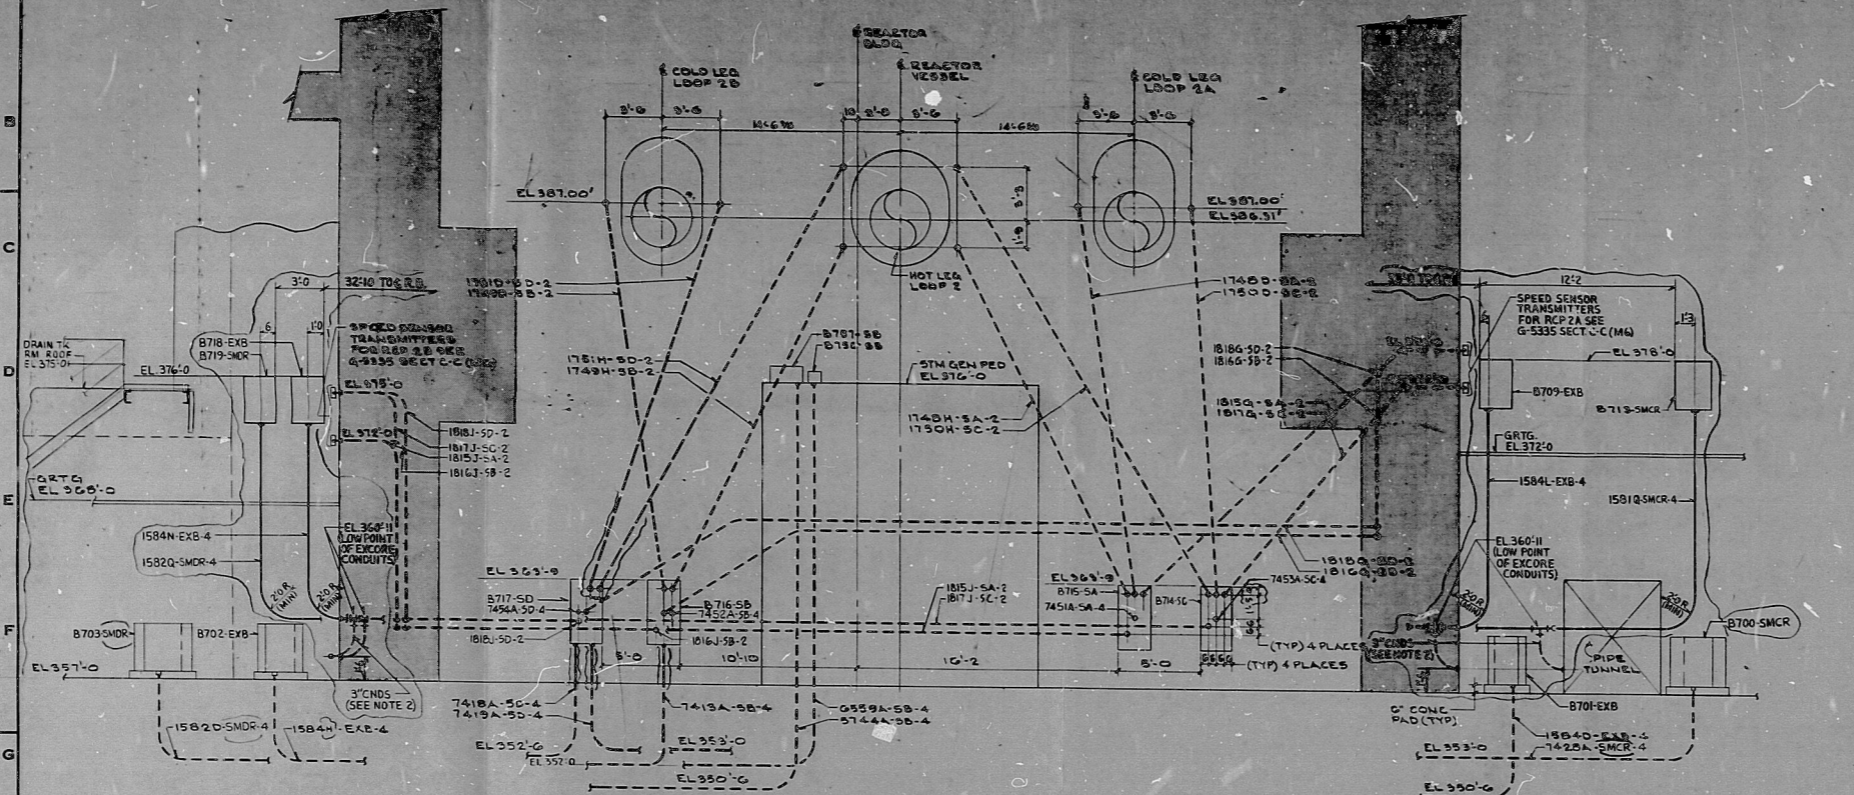

NOTES
 1. FOR NOTES, SYMBOLS & REFERENCE DRAWINGS SEE DWG. D-2025
 2. PROVIDE DRAINAGE FOR EXPOSED CONDUITS SEE DWG. D-2025 SH 5 ITEM 3.02.

THIS DRAWING CONTAINS:
 CONSTRUCTION CONTRACT NO. 259
 CONSTRUCTION CONTRACT NO. 255

THE SCOPE OF THE 255 CONTRACT INCLUDES ALL EMBEDDED ELECTRICAL WORK IN REACTOR BUILDING. THE SCOPE OF THE 259 CONTRACT IS FOR THE INSTALLATION OF ELECTRICAL BOXES, CABLE TRAYS, EXPOSED EQUIPMENT GROUNDING TERMINATIONS AND EXPOSED CONDUITS. FOR FURTHER DETAILS SEE CONSTR. SPECIFICATIONS.

APPROVED FOR CONSTRUCTION

THIS DRAWING INCORPORATES ALL G13 CHANGE NOTICES RECEIVED AS OF 8-15-81.

WPPS QUALITY CLASS I IIG
 PRC APERTURE CARD



NUCLEAR SAFETY RELATED

WASHINGTON PUBLIC POWER SUPPLY SYSTEM
 NUCLEAR PROJECTS NO. 525
 1961-1960 MW INSTALLATION
 1963-1960 MW INSTALLATION
 REACTOR BUILDING
 CONDUIT & TRAY SECTIONS SH. 4

INCORPORATED FOR 169, 228, 270, DCN 25, PCP350-00401
 (ADD) 2 REVISIONS EMBEDDED CONDUITS ON SECTS G-G & H-H

NO.	DATE	REVISION	BY	CHK.	APPROVED
1	4-27-81		EL	RS	CD

EBASCO SERVICES INCORPORATED

SCALE	DATE	PROJECT
AS SHOWN	5-15-80	WPPS-3240-G-5337

RIDS

8303300564

