




















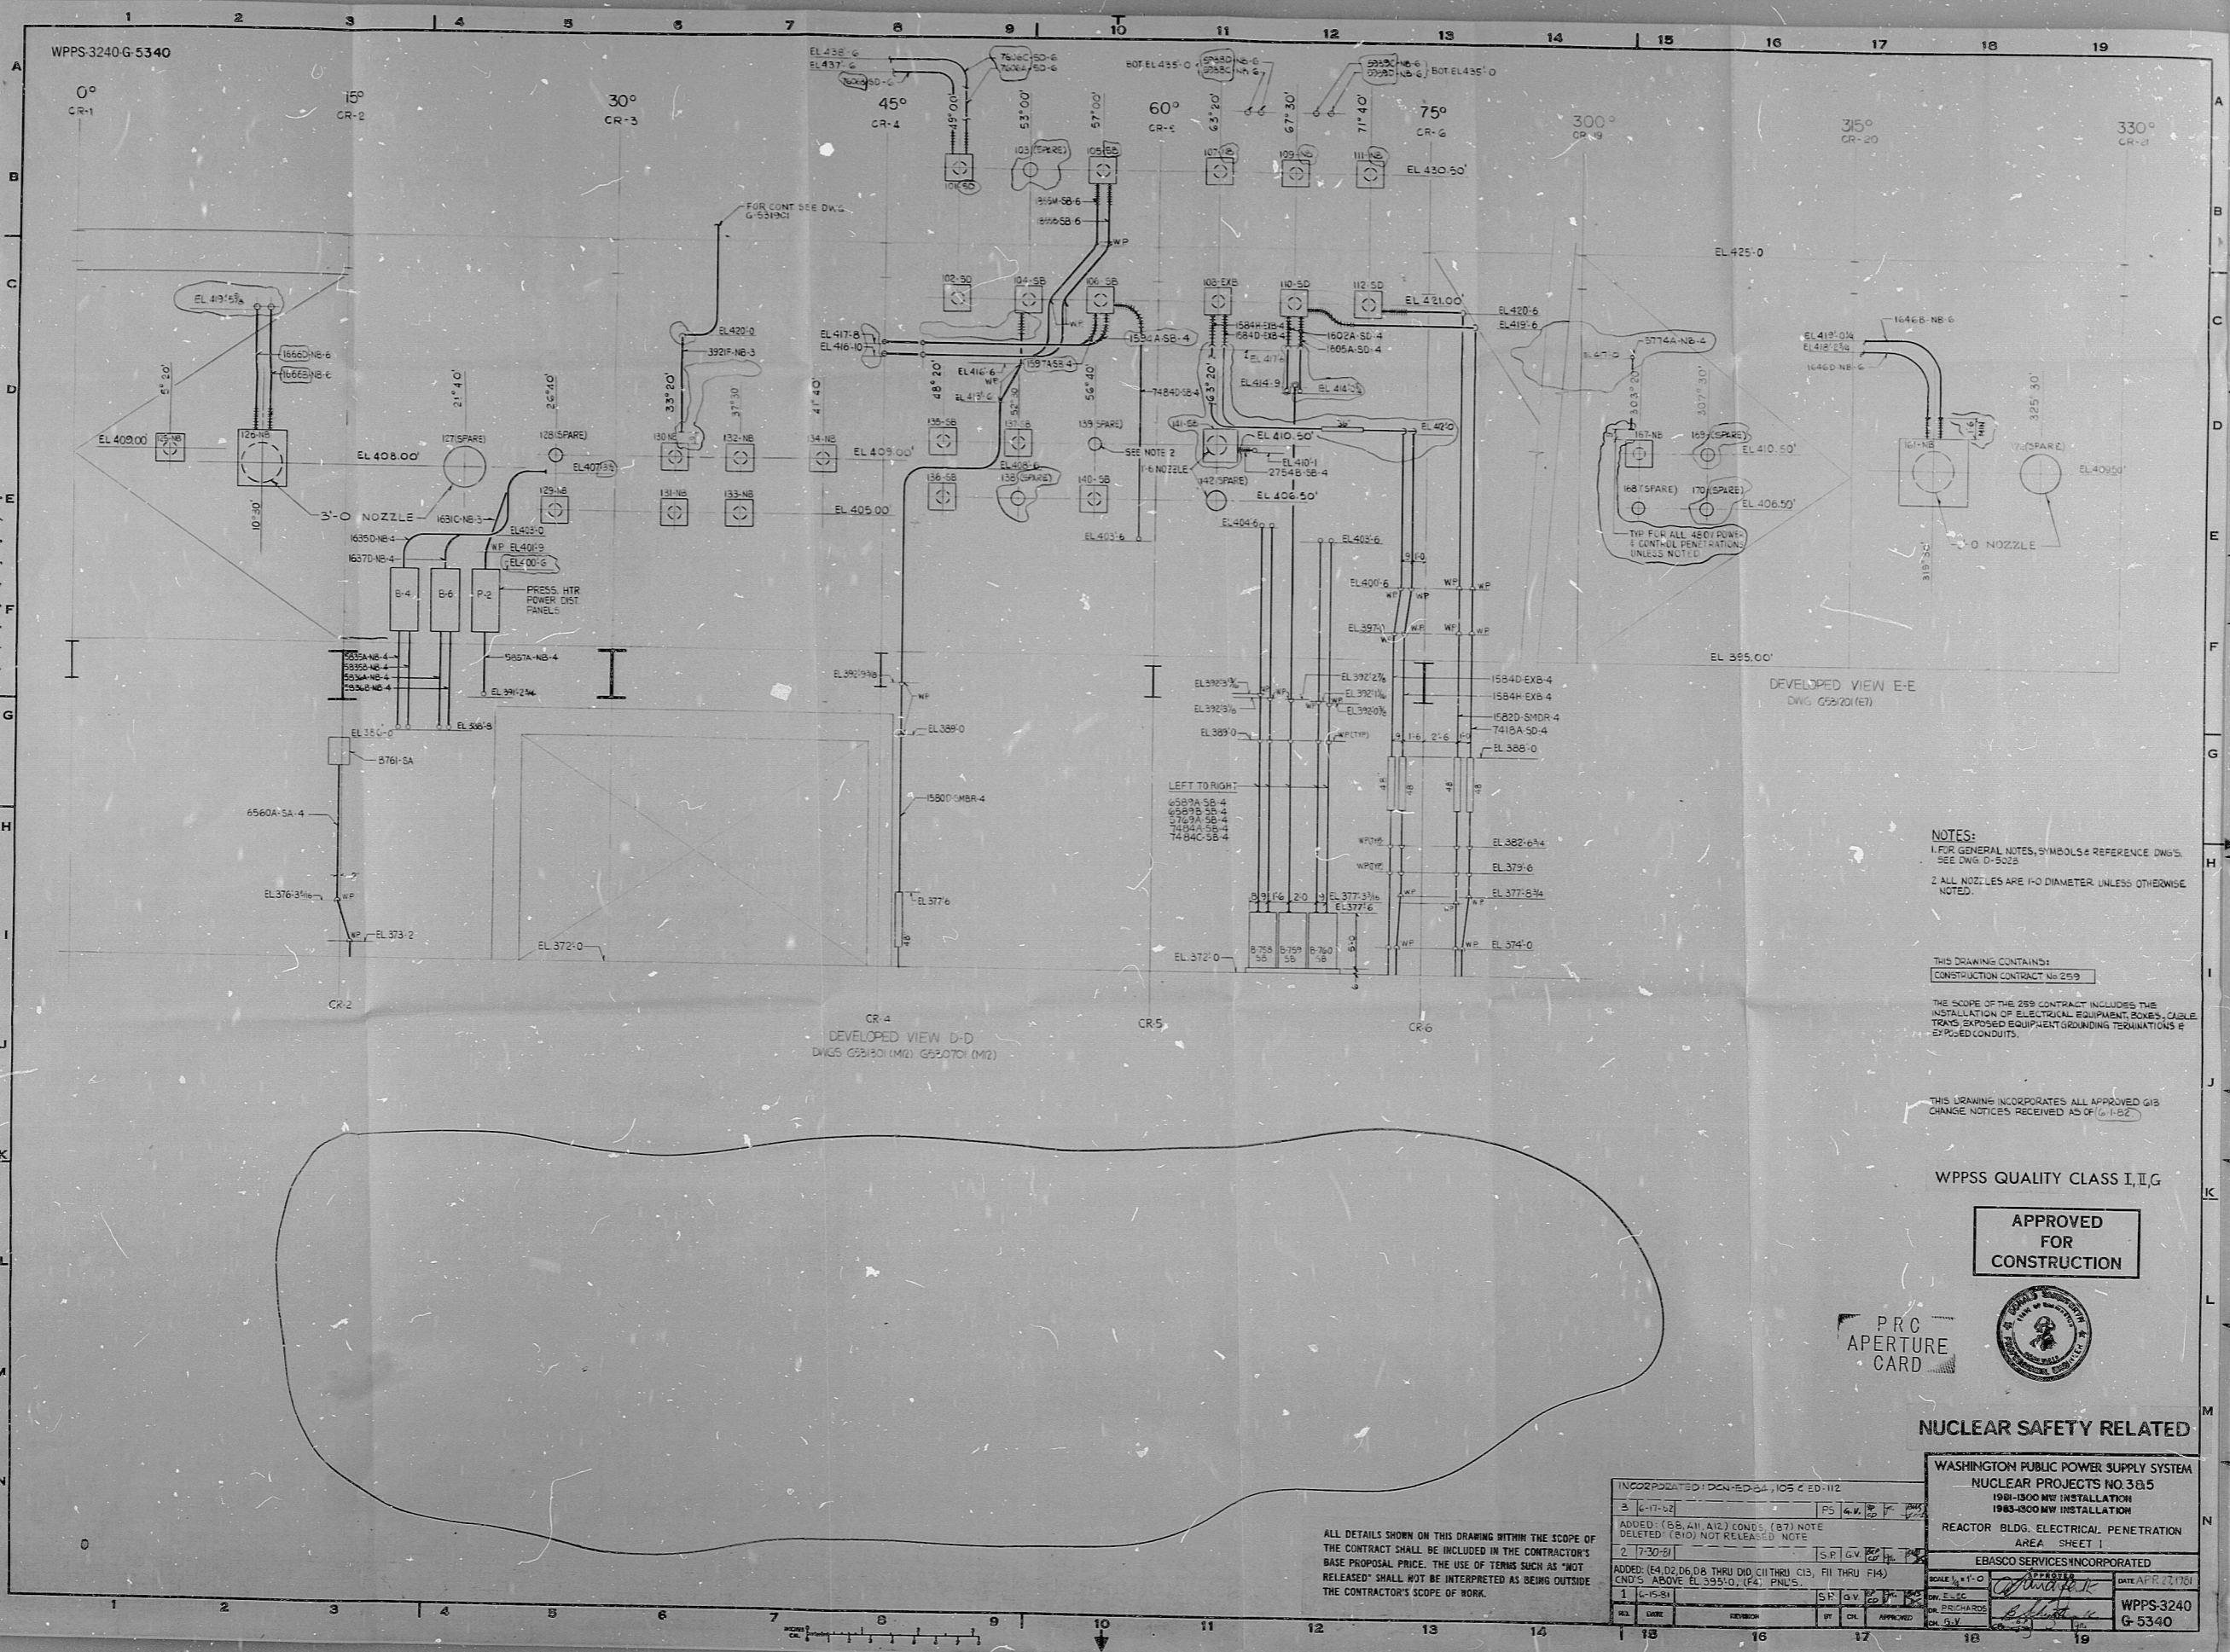

NOTES:  
 1. FOR GENERAL NOTES, SYMBOLS & REFERENCE DWGS. SEE DWG. D-502B.  
 2. ALL NOZZLES ARE 1-0 DIAMETER UNLESS OTHERWISE NOTED.

THIS DRAWING CONTAINS:  
 CONSTRUCTION CONTRACT NO. 259

THE SCOPE OF THE 259 CONTRACT INCLUDES THE INSTALLATION OF ELECTRICAL EQUIPMENT, BOXES, CABLE TRAYS, SUSPENDED EQUIPMENT, GROUNDING TERMINATIONS & EXPOSED CONDUITS.

THIS DRAWING INCORPORATES ALL APPROVED GIB CHANGE NOTICES RECEIVED AS OF 1-1-82

WPPSS QUALITY CLASS I, IIG

APPROVED FOR CONSTRUCTION

PRC APERTURE CARD



NUCLEAR SAFETY RELATED

INCORPORATED (DCN-ED-84, 105 & ED-112)		DATE: APR 21, 1982	
3	6-17-82	PS	4, 5, 6, 7, 8, 9, 10, 11, 12, 13, 14, 15, 16, 17, 18, 19
ADDED: (55, 51, A12) COND. (87) NOTE DELETED (87) NOT RELEASED NOTE			
ADDED: (E4, D2, D6, D8, THRU D10, C1 THRU C13, F1 THRU F14) COND'S ABOVE EL 395'-0" (F4), PNU.S.			
1	6-15-81	SP	1, 2, 3, 4, 5, 6, 7, 8, 9, 10, 11, 12, 13, 14, 15, 16, 17, 18, 19
REV	DATE	BY	APP'D

ALL DETAILS SHOWN ON THIS DRAWING WITHIN THE SCOPE OF THE CONTRACT SHALL BE INCLUDED IN THE CONTRACTOR'S BASE PROPOSAL PRICE. THE USE OF TERMS SUCH AS "NOT RELEASED" SHALL NOT BE INTERPRETED AS BEING OUTSIDE THE CONTRACTOR'S SCOPE OF WORK.

WASHINGTON PUBLIC POWER SUPPLY SYSTEM  
 NUCLEAR PROJECTS NO. 3 & 5  
 REACTOR BLDG. ELECTRICAL PENETRATION  
 AREA SHEET 1

EBASCO SERVICES INCORPORATED

SCALE: 1/8" = 1'-0"

DATE: APR 21, 1982

WPPSS-3240  
 G-5340



RIDS

8303300570

