


34" 22" 17" 11" 8.5" 11" 8.5" 17" 22" 34"

34" 22" 17" 11" 8.5" 11" 8.5" 17" 22" 34"

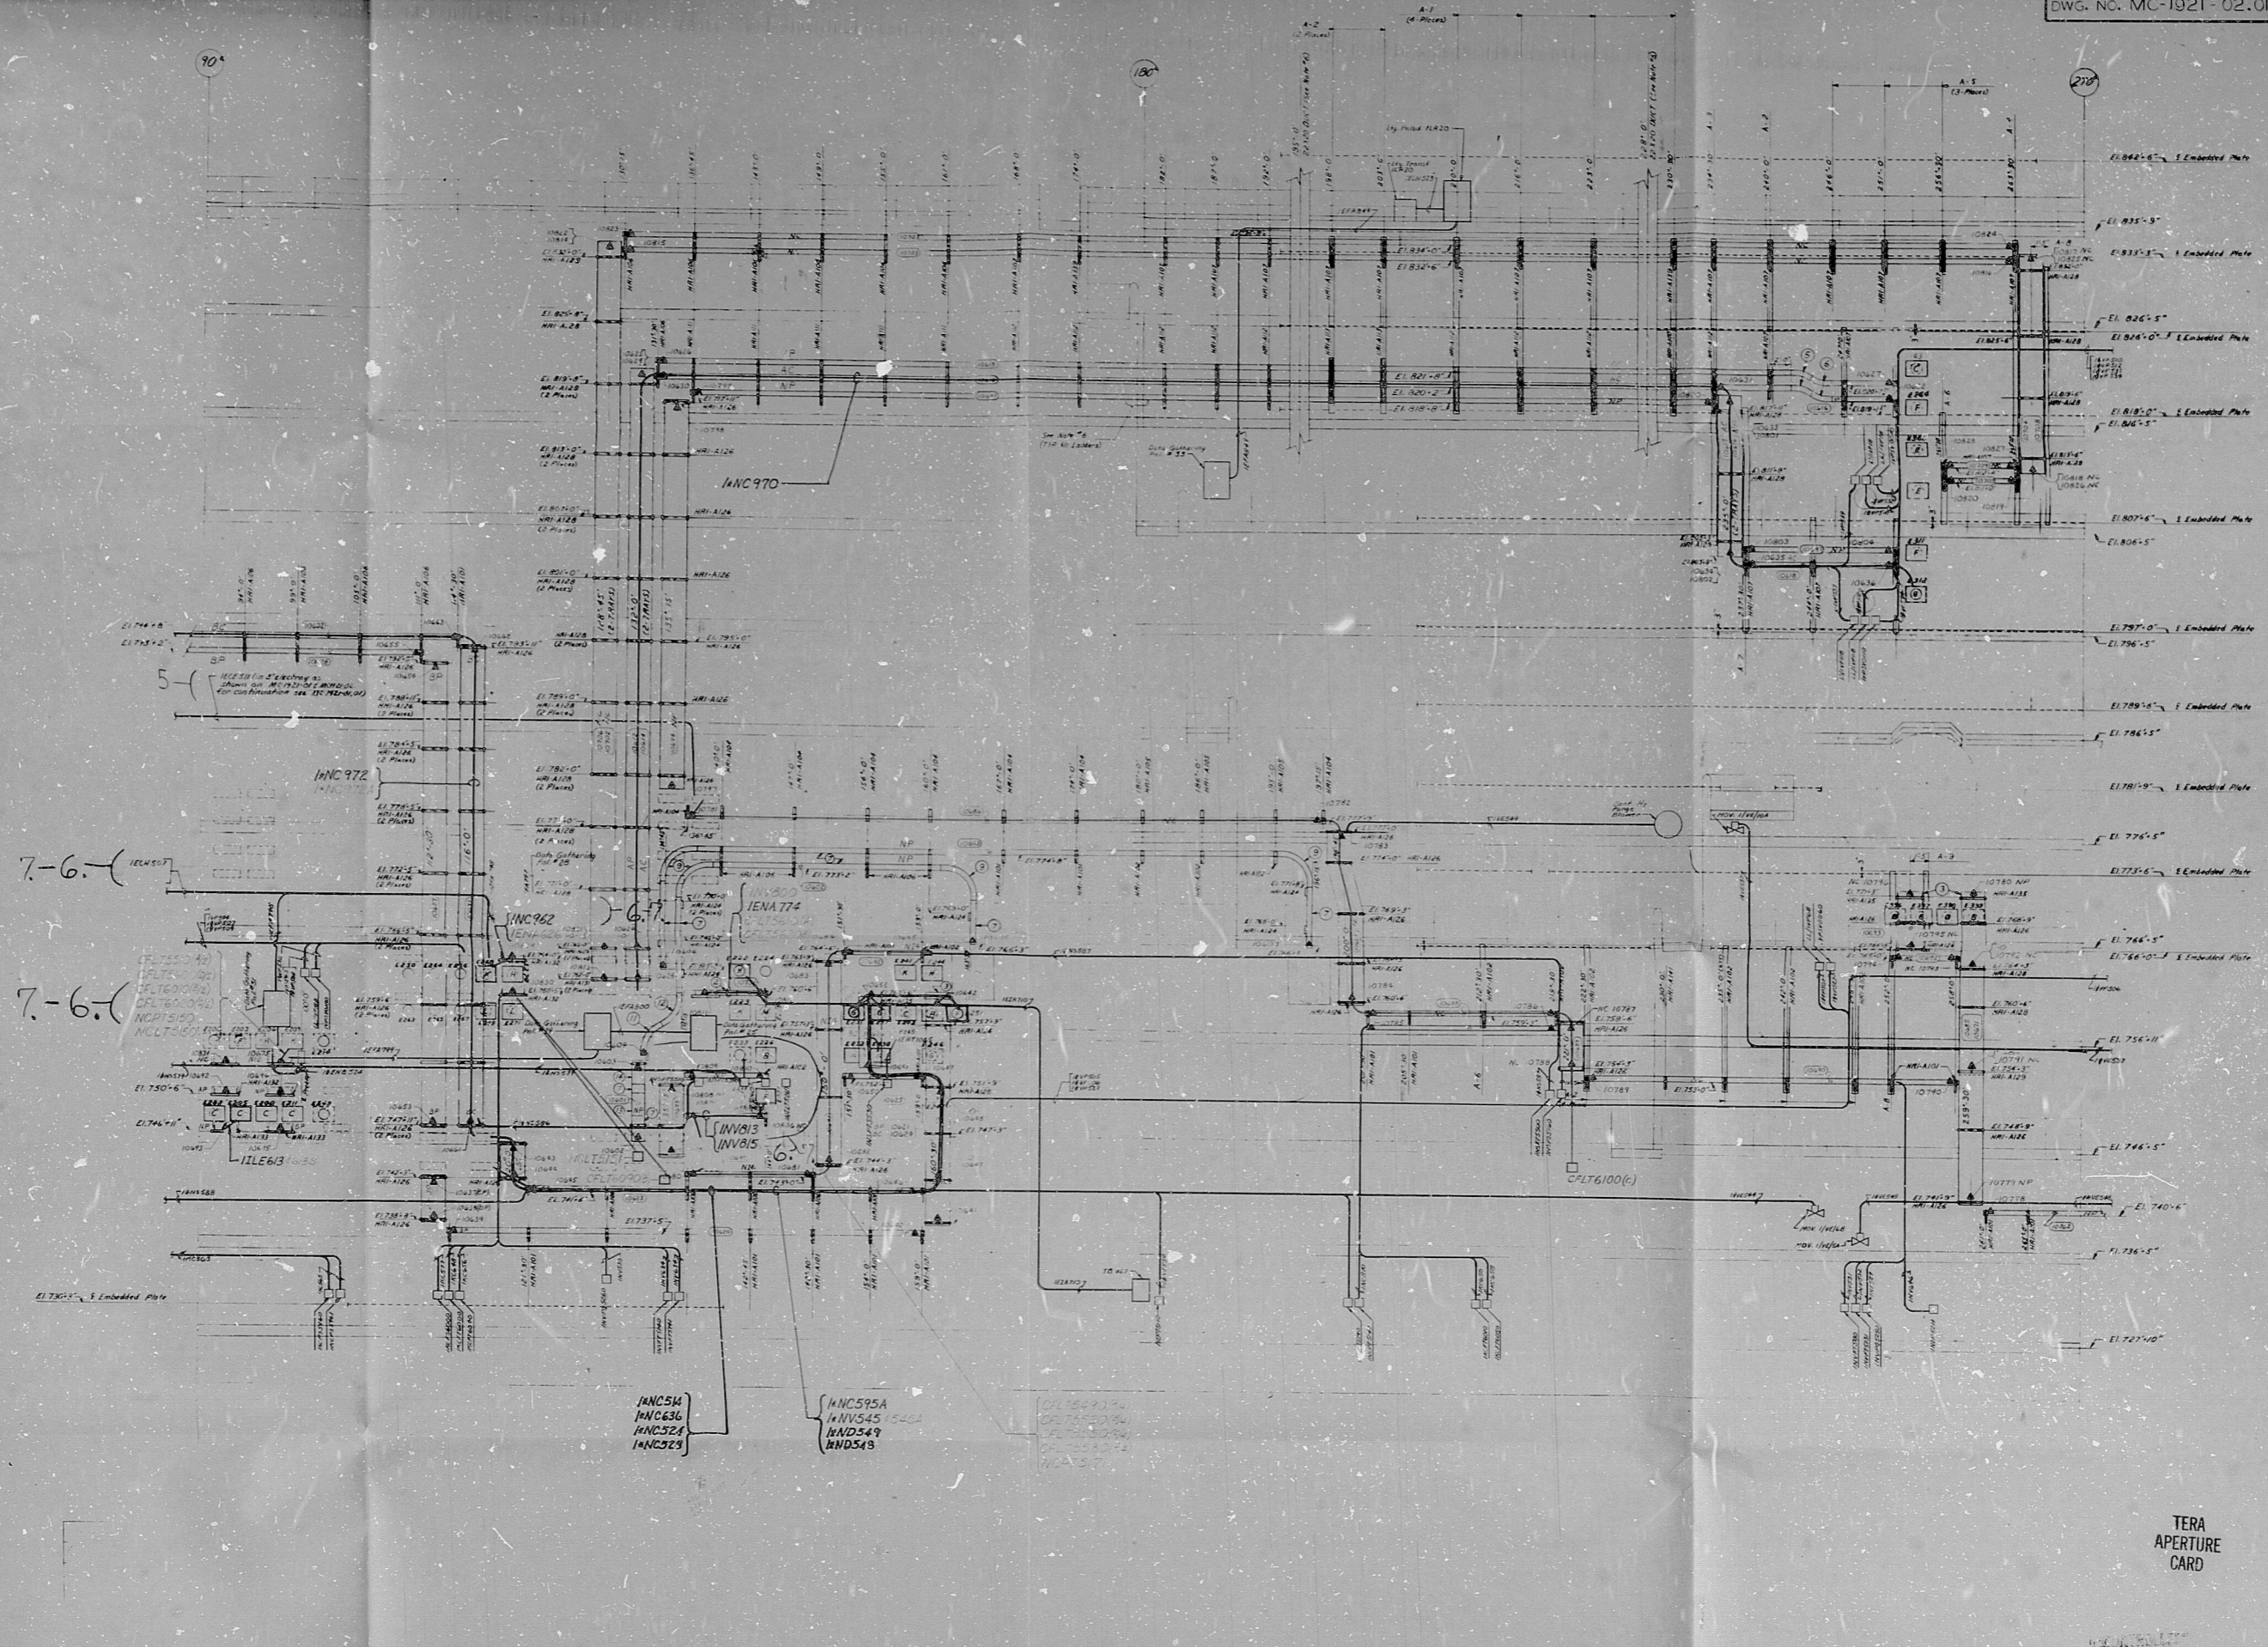

TERA APERTURE CARD

"UNCONTROLLED"

8110270515  
NUCLEAR SAFETY RELATED

DUKE POWER COMPANY  
MCUIRE NUCLEAR STATION UNIT NR1

COMPUTER CABLE ROUTING  
REACTOR BUILDING  
ANNULUS ELEVATION  
FROM AZIMUTH 90° TO 270°

NOTE: For notes and reference draw MC-1921-01.01

NO.	REVISIONS	CHKD.	APPD.	DATE	INSPECTED
1	Rev. as shown noted				WAIVED
2	For the drawing MC-1921-01.01				WAIVED
3	Added Security Access Control				WAIVED
4	Added Security Access Control				WAIVED
DESIGNED BY: DATE: 10/27/74  
CHECKED BY: DATE: 11/1/74  
SCALE: 1/8" = 1'-0" DWG. NO. MC-1921-02.01 REV. 7

RIDS

8110270515

