
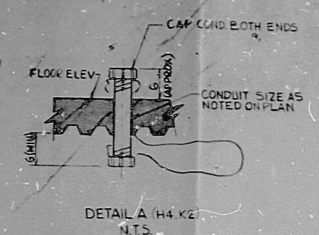
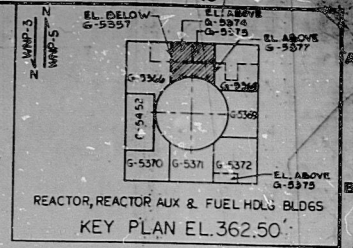


34

78

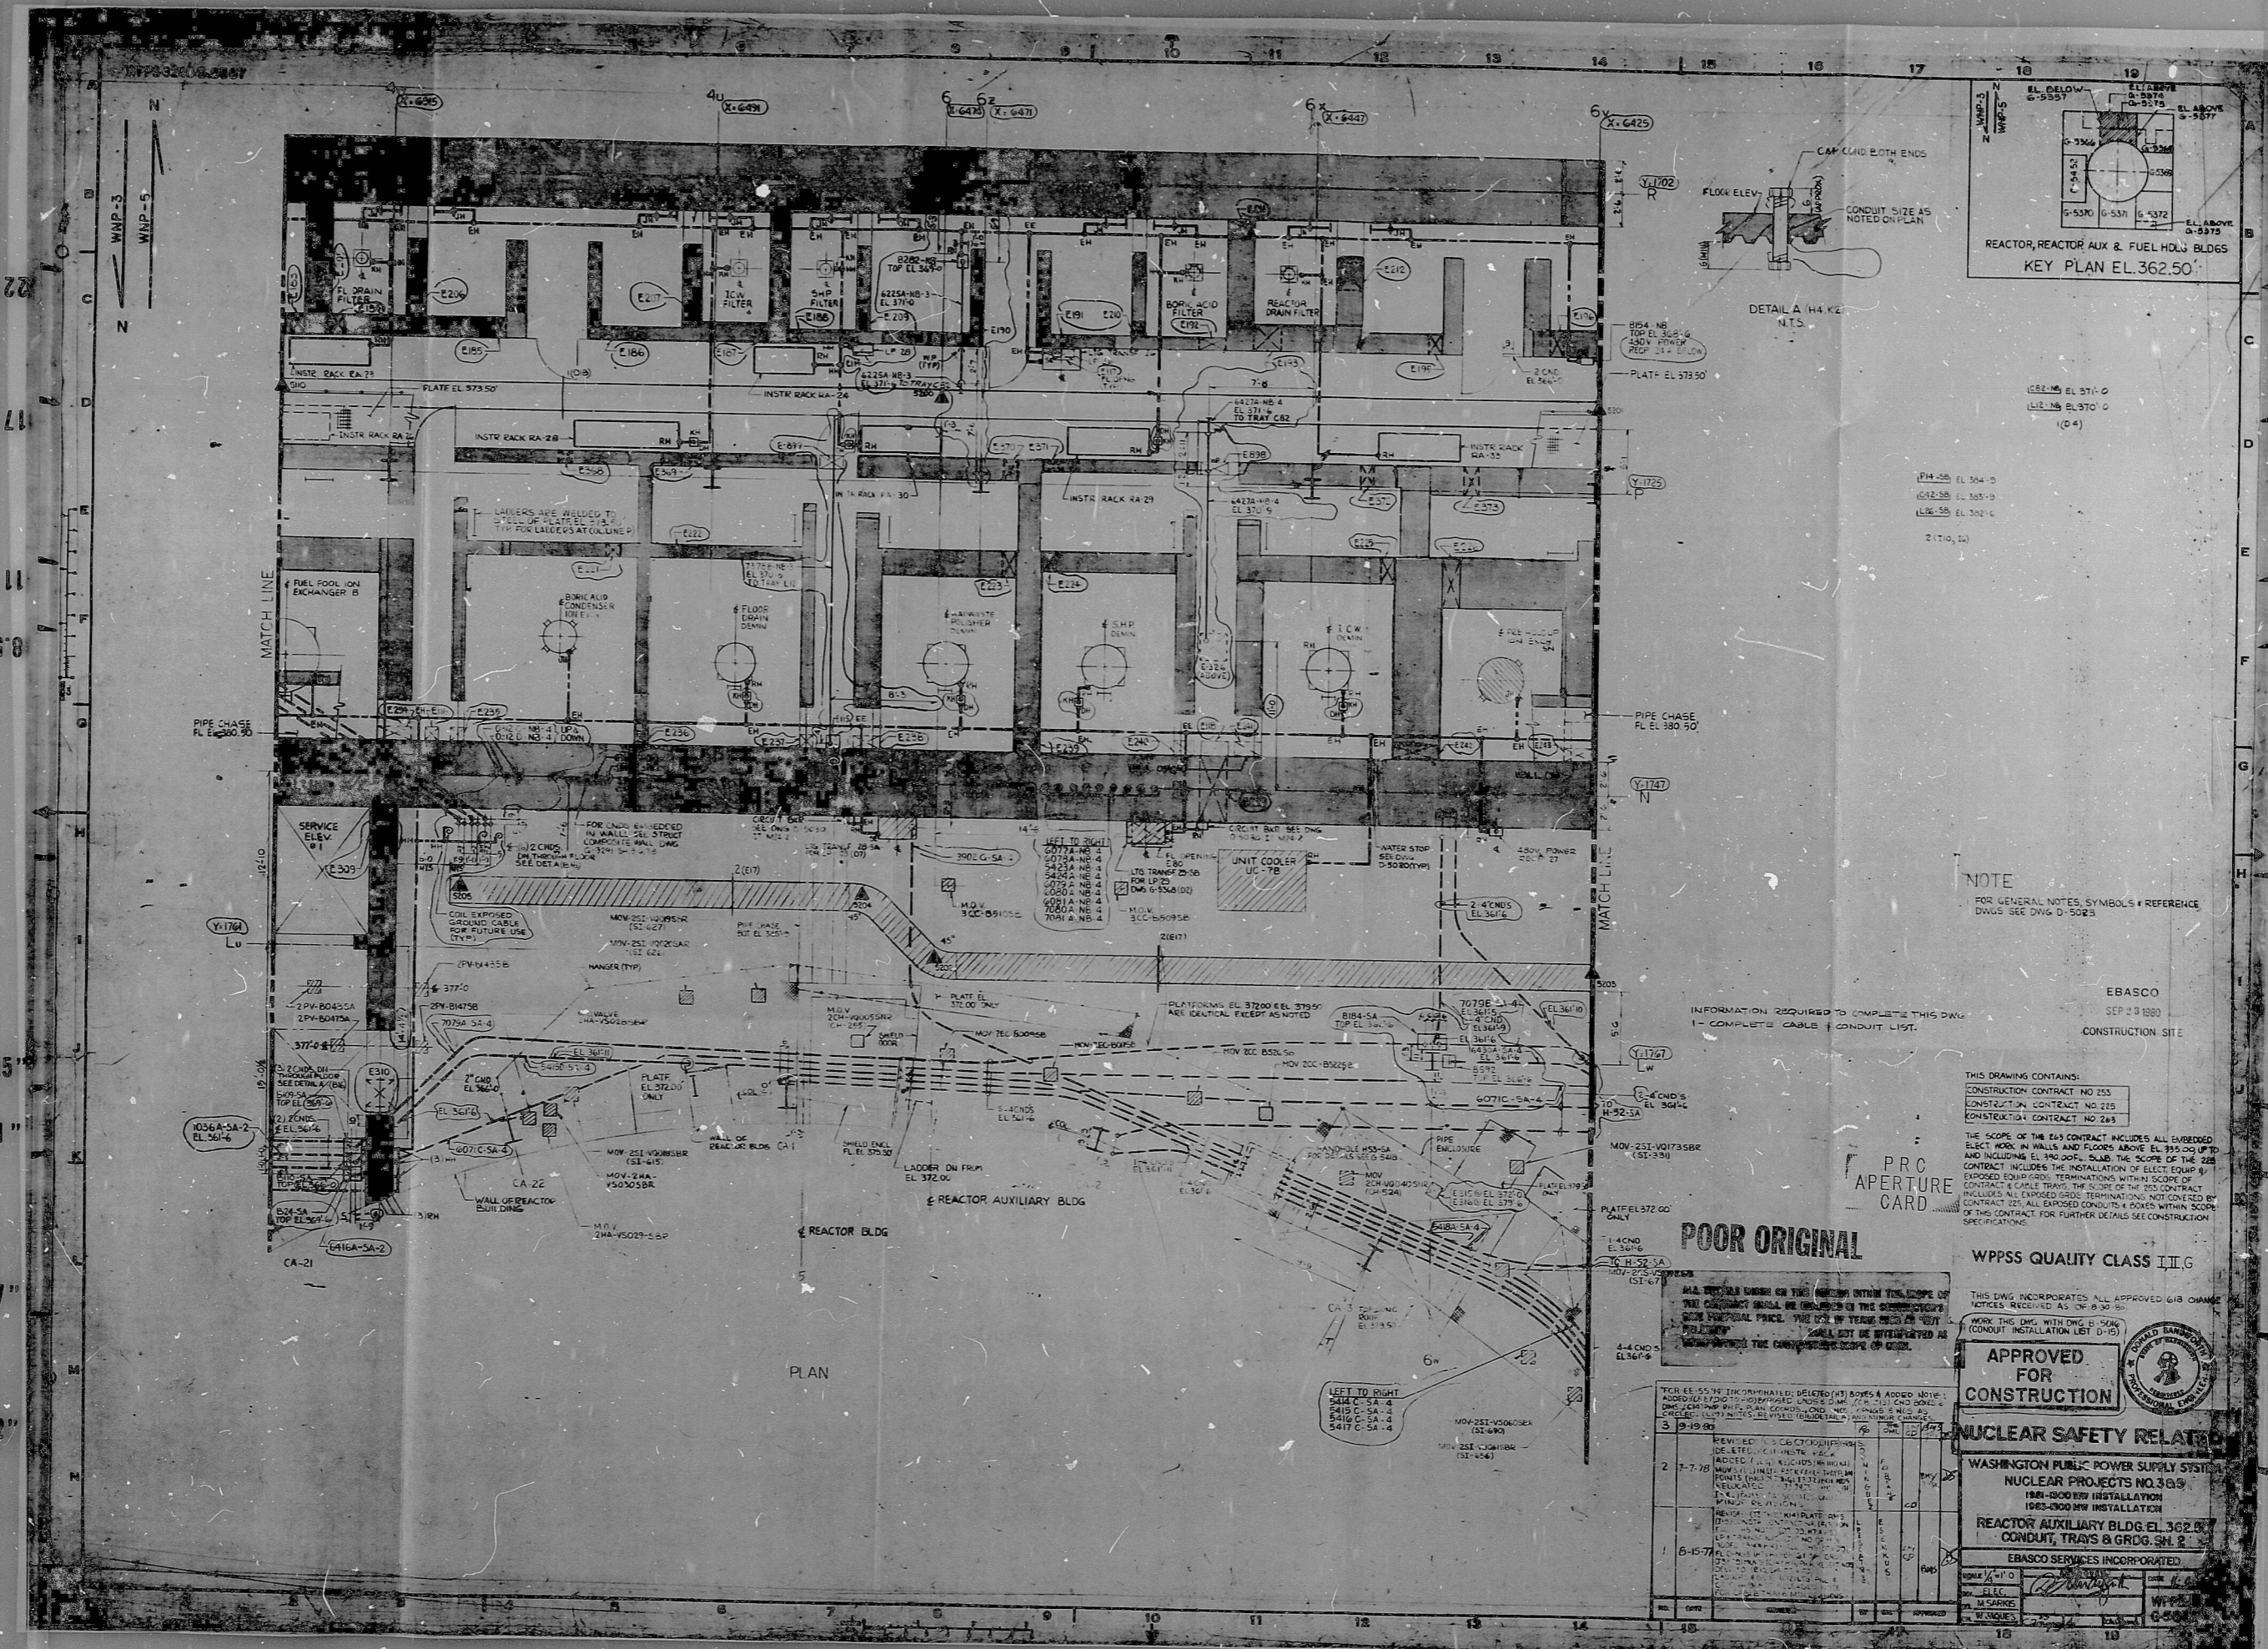

REACTOR, REACTOR AUX. & FUEL HOLD BLDGS  
KEY PLAN EL. 362.50



EL. 362.50  
EL. 361.0  
EL. 360.0  
(0.4)

104-55 EL. 364.0  
104-56 EL. 363.0  
106-55 EL. 362.4  
2170, 10

NOTE  
FOR GENERAL NOTES, SYMBOLS & REFERENCE  
DWGS SEE DWG D-5023

EBASCO  
SEP 23 1980  
CONSTRUCTION SITE

THIS DRAWING CONTAINS:  
CONSTRUCTION CONTRACT NO. 253  
CONSTRUCTION CONTRACT NO. 215  
CONSTRUCTION CONTRACT NO. 243

OF THE CONTRACT FOR FURTHER DETAILS SEE CONSTRUCTION  
SPECIFICATIONS.

PRO  
APERTURE  
CARD

POOR ORIGINAL

WPPSS QUALITY CLASS II G

THIS DWG INCORPORATES ALL APPROVED CHG. ORDER  
NOTICES RECEIVED AS OF 9-30-80  
WORK THE DWG WITH DRC 10-0-80  
(CONDUIT INSTALLATION LET D-15)

APPROVED FOR CONSTRUCTION

NUCLEAR SAFETY RELATED

WASHINGTON PUBLIC POWER SUPPLY SYSTEM  
NUCLEAR PROJECTS NO. 309

1983-1988 INSTALLATION

REACTOR AUXILIARY BLDG. EL. 362.50  
CONDUIT, TRAYS & GRDG. SM. 2

EBASCO SERVICES INCORPORATED

NO.	DATE	DESCRIPTION	BY	CHKD.	APPROVED

PLAN

LEFT TO RIGHT  

18 19

RIDS

8303300601

