




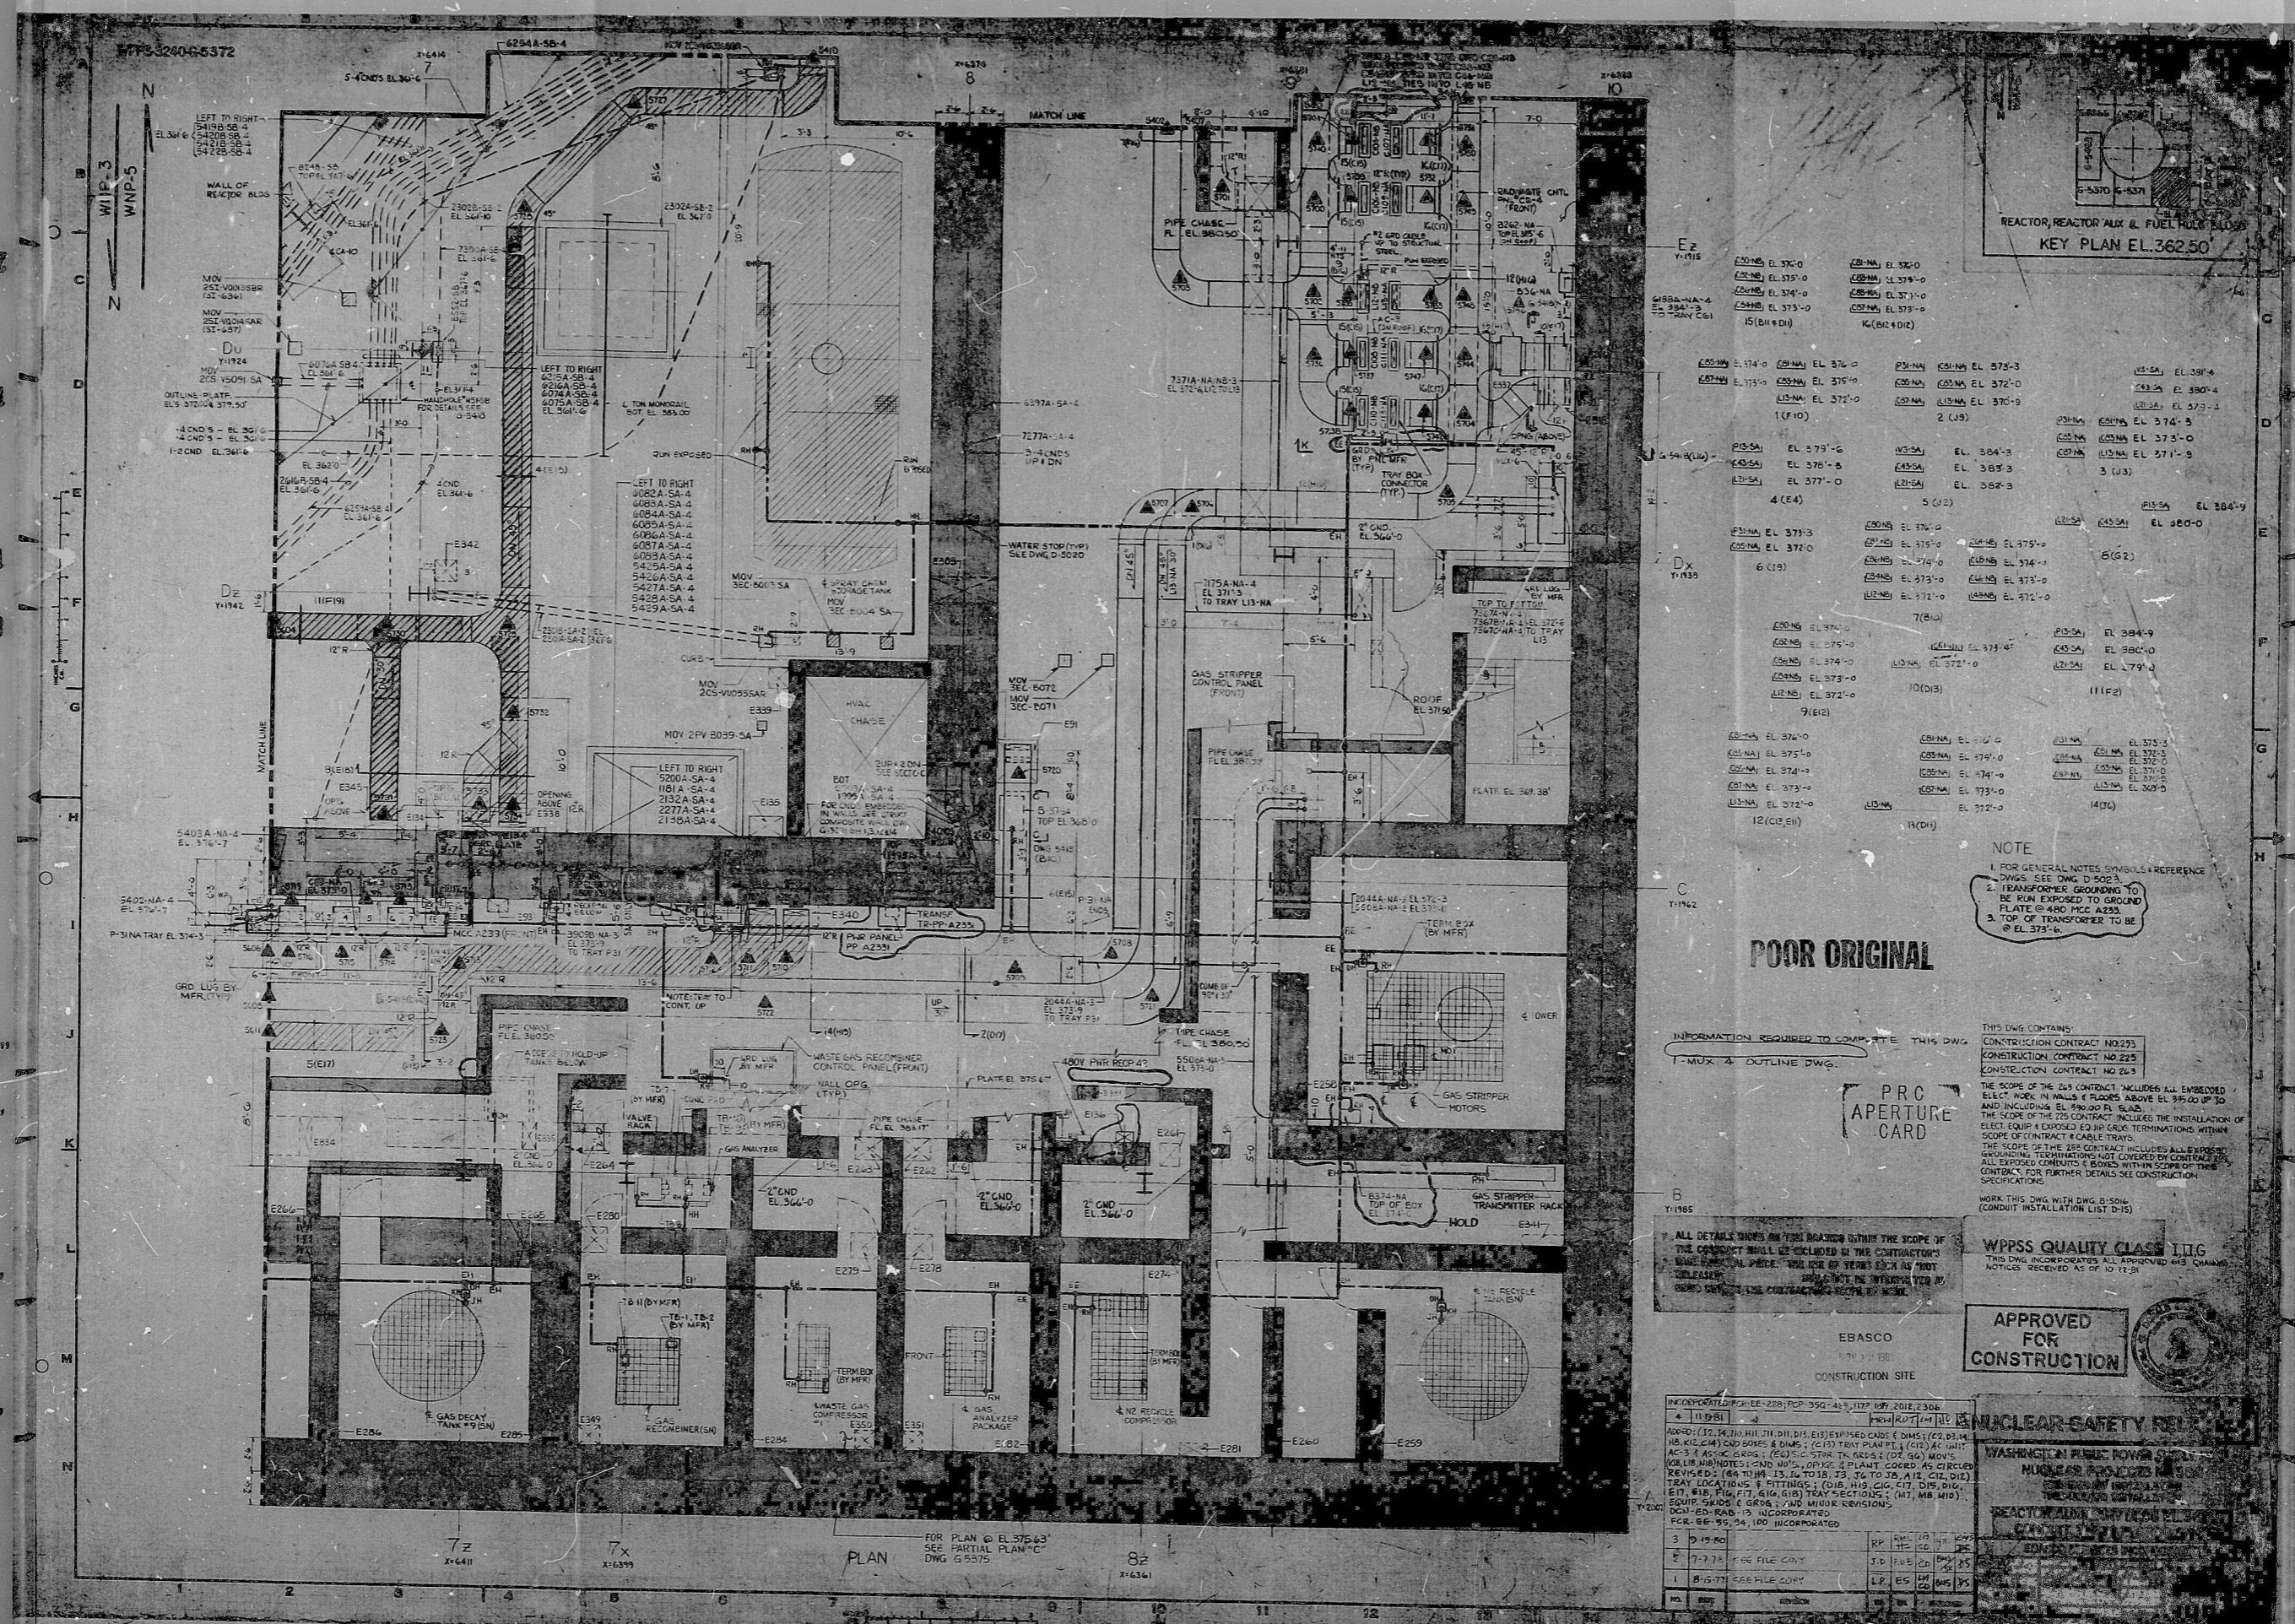

















POOR ORIGINAL

PRC APERTURE CARD

NOTE

- FOR GENERAL NOTES, SYMBOLS & REFERENCE CHANGES SEE DWG. D-5003.
- TOP OF TRANSFORMER TO BE @ EL. 373.6.

INFORMATION REQUIRED TO COMPLETE THIS DWG.

1. MUX 4 OUTLINE DWG.


WPPSS QUALITY CLASS IITG

THIS DWG INCORPORATES ALL APPROVED CHANGES NOTICED RECEIVED AS OF 10/11/81.

APPROVED FOR CONSTRUCTION



NO.	DATE	DESCRIPTION	BY	CHKD.
3	10-19-80	REV. FILE COPY	RP	RP
2	7-7-79	REV. FILE COPY	J.D.	RP
1	8-15-77	REV. FILE COPY	RP	RP



REACTOR AUXILIARY & FUEL HANDLING BUILDING

PLAN FOR PLAN @ EL. 375.63 SEE PARTIAL PLAN "C" DWG. G-5575

82 X-6361

RIDS

8303309612

