
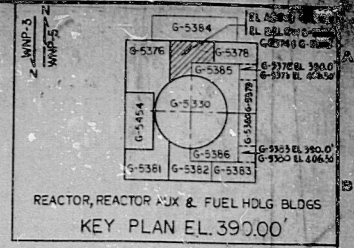


WPPSS-3240-G-5377

WNP-3
WNP-5

A
B
C
D
E
F
G
H
I
J
K
L
M
N

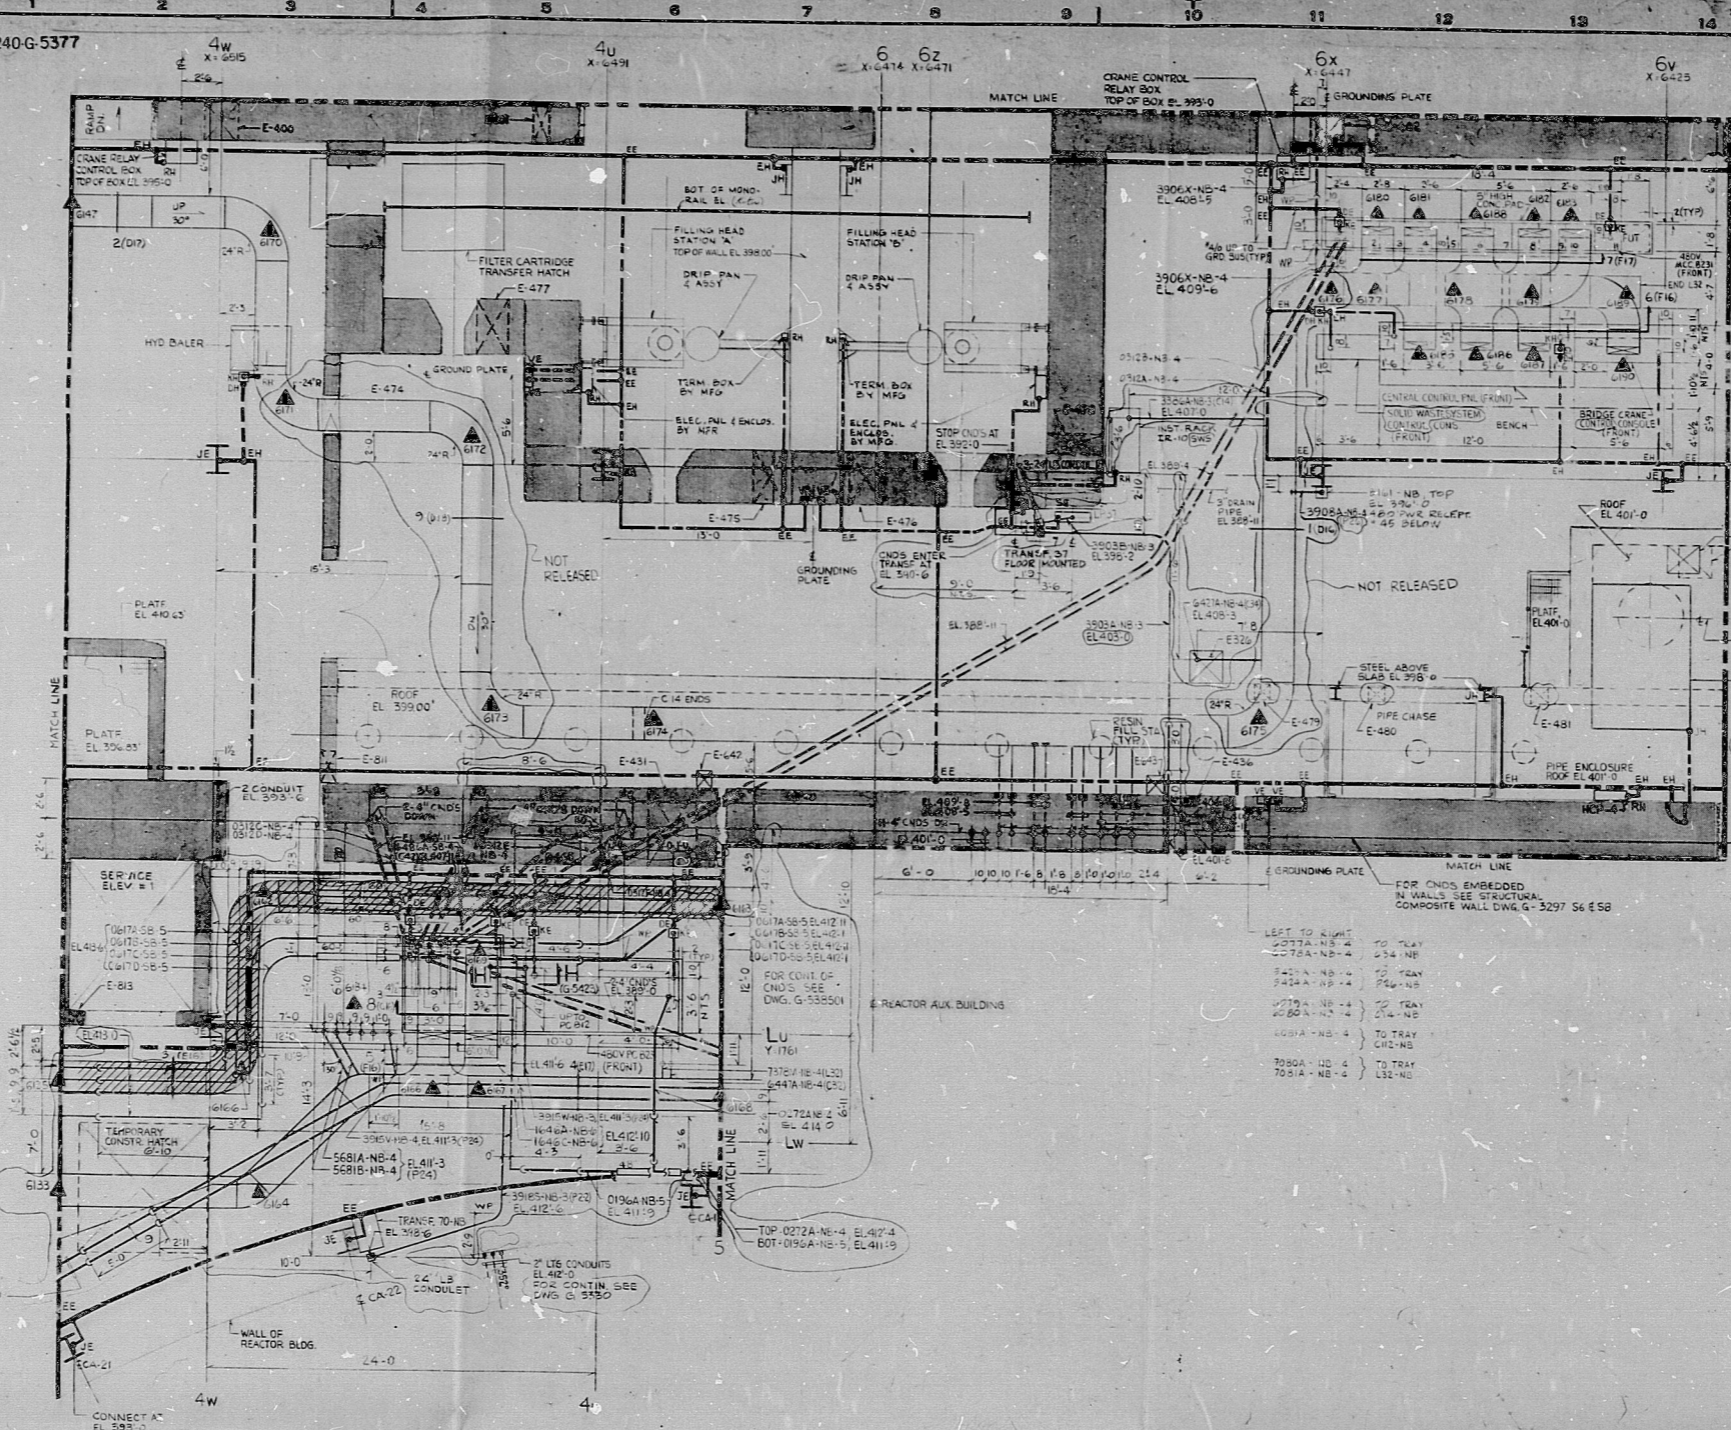


NOTE
1. FOR GENERAL NOTES SYMBOLS & REFERENCE DIMS SEE DWG D-502B
2. ALL TRAY FITTINGS ON THIS DWG SHALL HAVE 1/2" RADIUS UNLESS OTHERWISE NOTED.

POOR ORIGINAL

APPROVED FOR CONSTRUCTION

INFORMATION REQUIRED TO COMPLETE THIS DWG
1. COMPLETE TABLE 4 CONDUIT LIST
2. REVISED TRAY LAYOUT PER 043 RW-RAB-10.

ADDED (1) TO 10, 11, 12, 1000.
--

WPPSS QUALITY CLASS II

PRC APERTURE CARD

NUCLEAR SAFETY RELATED

WASHINGTON PUBLIC POWER SUPPLY SYSTEM
NUCLEAR PROJECTS NO. 3 & 5
1900-1500 MW INSTALLATION
1983-1500 MW INSTALLATION

REACTOR AUX BLDG EL. 393.00
CND TRAYS & CND SH.

EBASCO SERVICES INCORPORATED

WPPSS-3240

ALL DETAILS SHOWN ON THIS DRAWING WITHIN THE SCOPE OF THE CONTRACT SHALL BE INCLUDED IN THE CONTRACTOR'S BASE PROPOSAL PRICE. THE USE OF TERMS SUCH AS "NOT RELEASED" SHALL NOT BE INTERPRETTED AS BEING OUTSIDE THE CONTRACTOR'S SCOPE OF WORK.

RIDS

8303300631

