


22
17
11
8.5
8.5
11
17
22

22
17
11
8.5
11
17
22

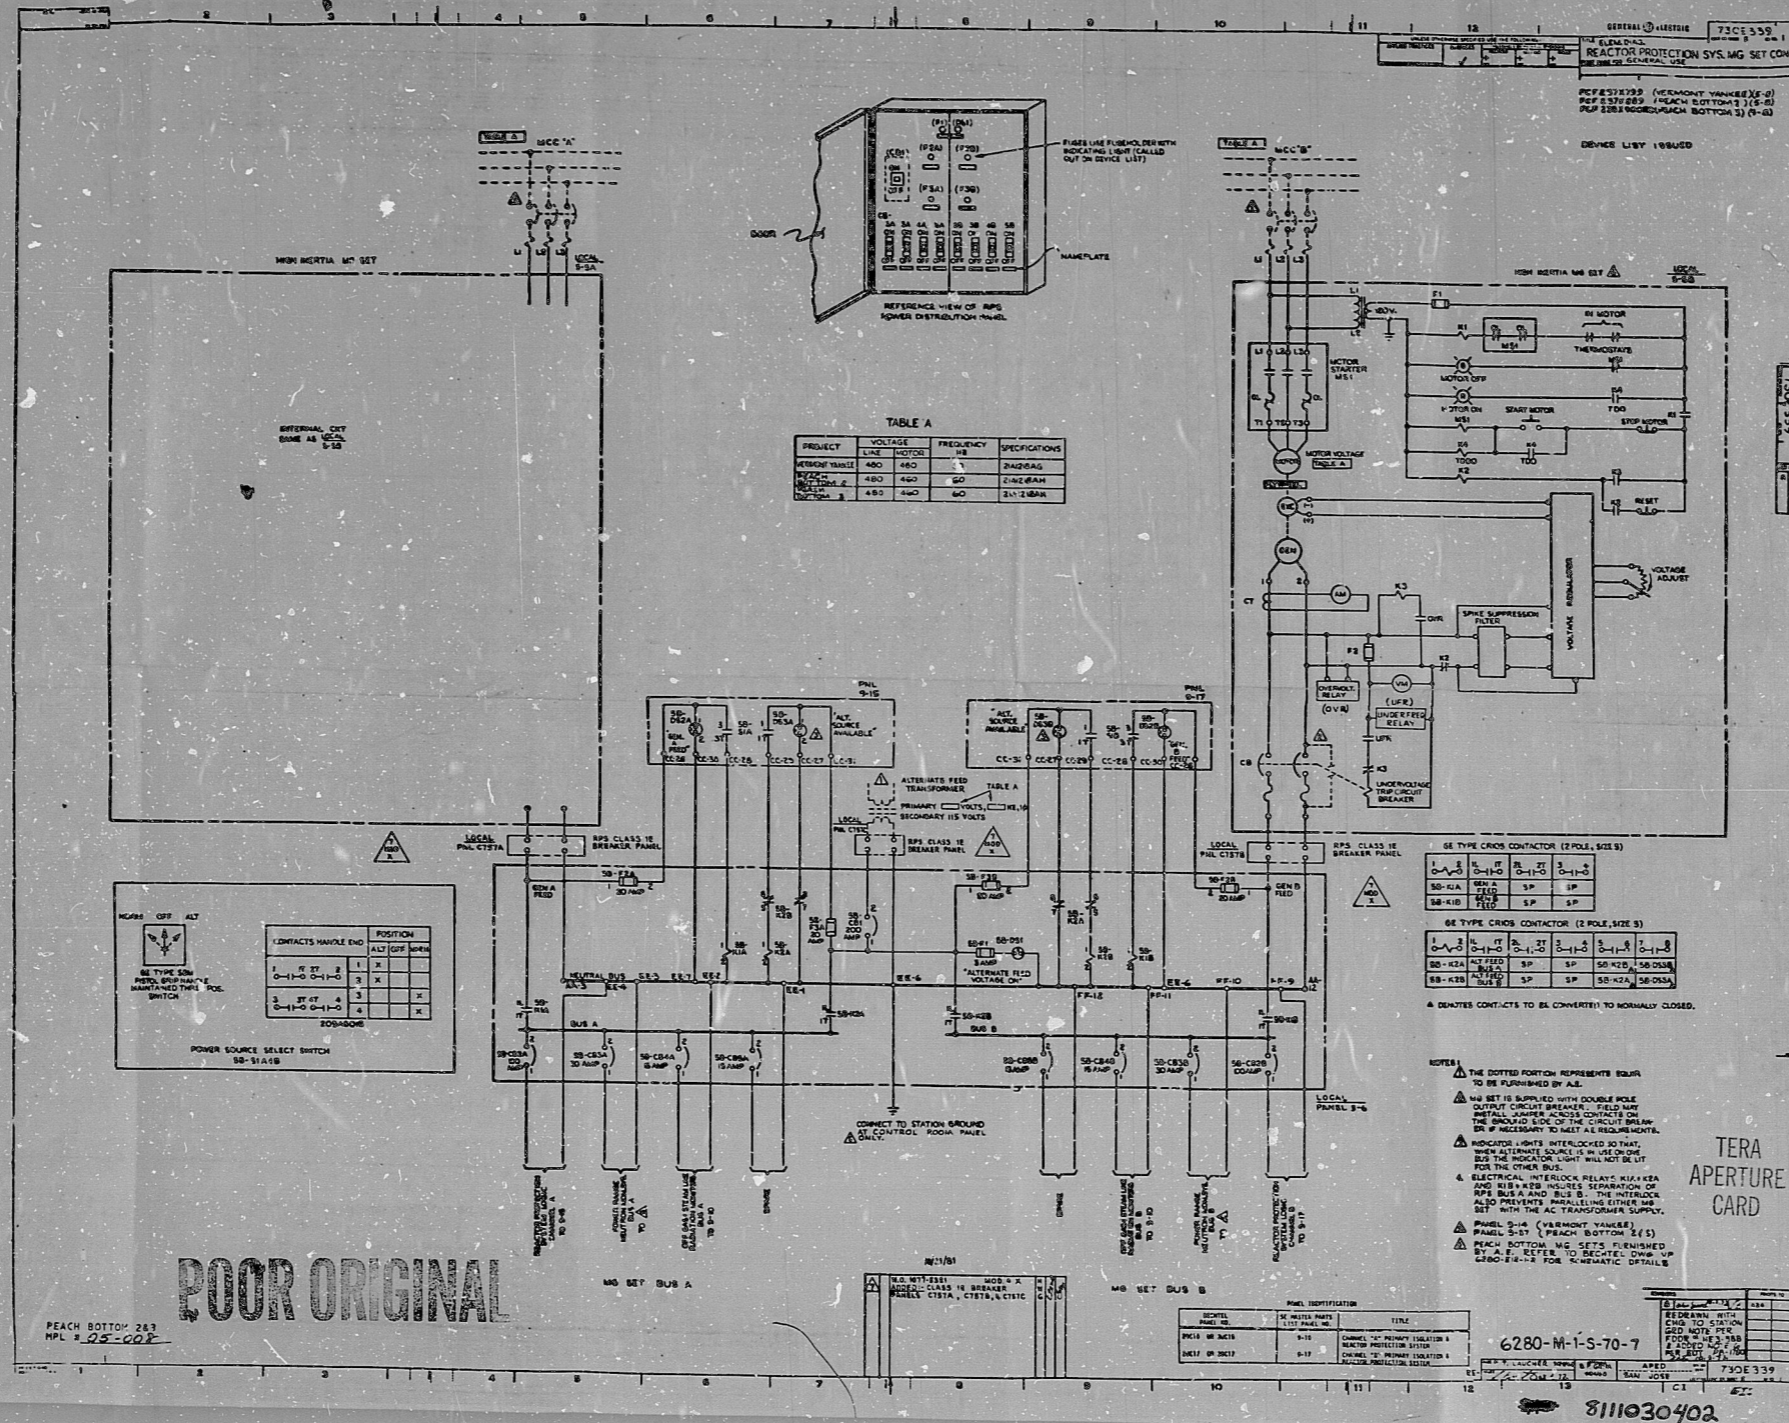

RIDS

8111030402

