
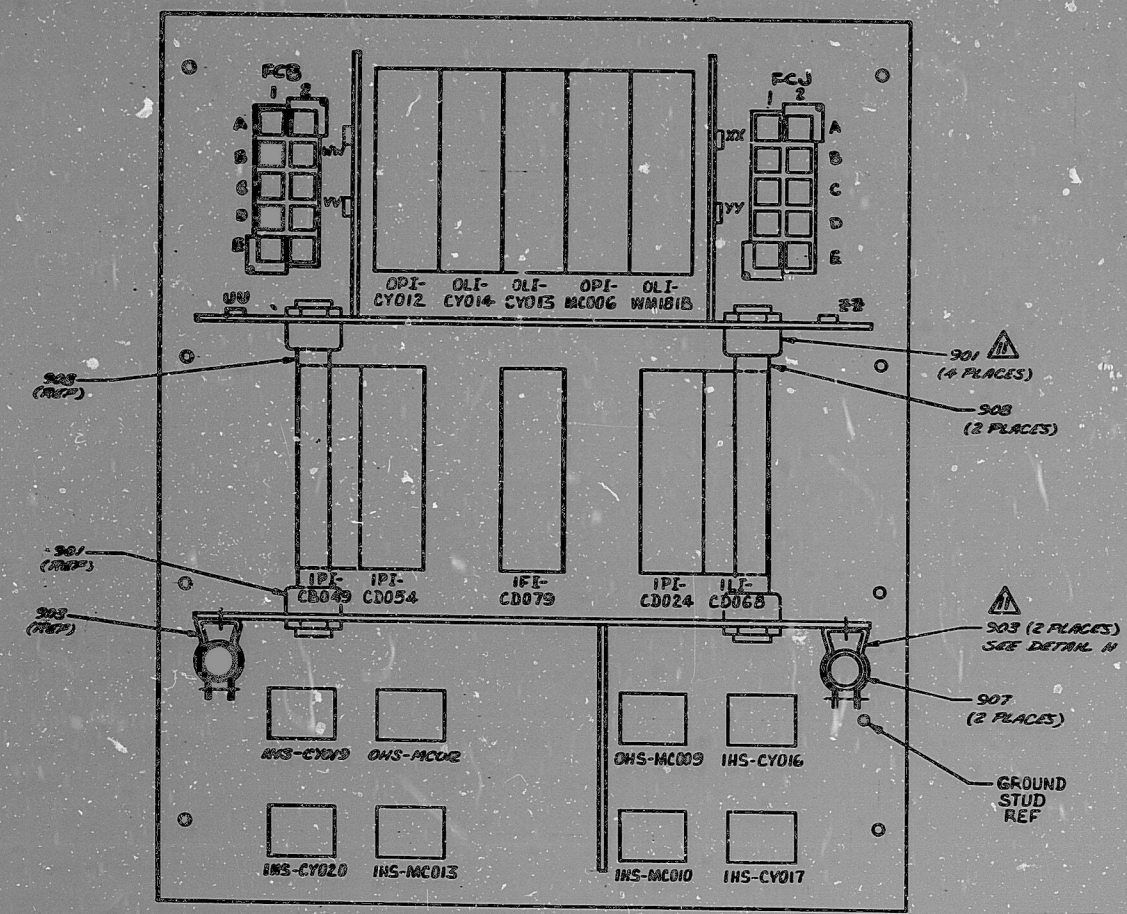


PART NO.	MARKING	MP CHAR ITEM NO.	SIZE
1000A	COND IN WTR STOR STNR LEVEL	①	.12
1000B	COND XFER PMP DISCH PRESSURE	②	
1000C	COND STOR STNR 1A LEVEL	③	.157
1000D	COND STOR STNR 1B LEVEL	④	
1000E	COND XFER PMP DISCH HDR PRESSURE	⑤	
1001	COND POLISHER INLET FLOW	⑥	.158
1002A	COND HOTWELL LEVEL	⑦	
1002B	COND PMP DISCH HDR PRESSURE	⑧	.159
1003A	COND BATH PMP DISCH HDR PRESSURE	⑨	.159
1003B	COND BATH PMP DISCH HDR PRESSURE	⑩	.159

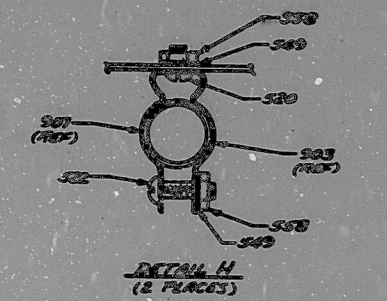

TERA  
 APERTURE  
 CARD

REVISED BY DCC  
 AUG 18 1981  
 FOR REFERENCE ONLY  
 Not To Be Used For Construction

REV	DATE	BY	CHKD BY	APP'D BY	DESCRIPTION



RIDS

811110047

