
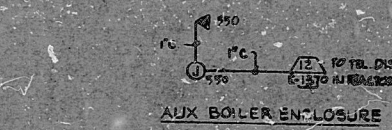
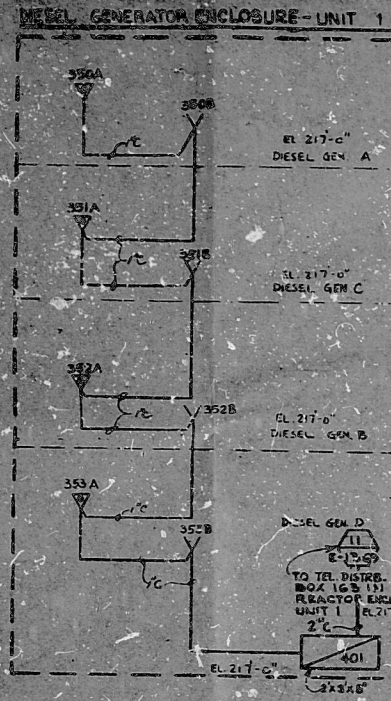
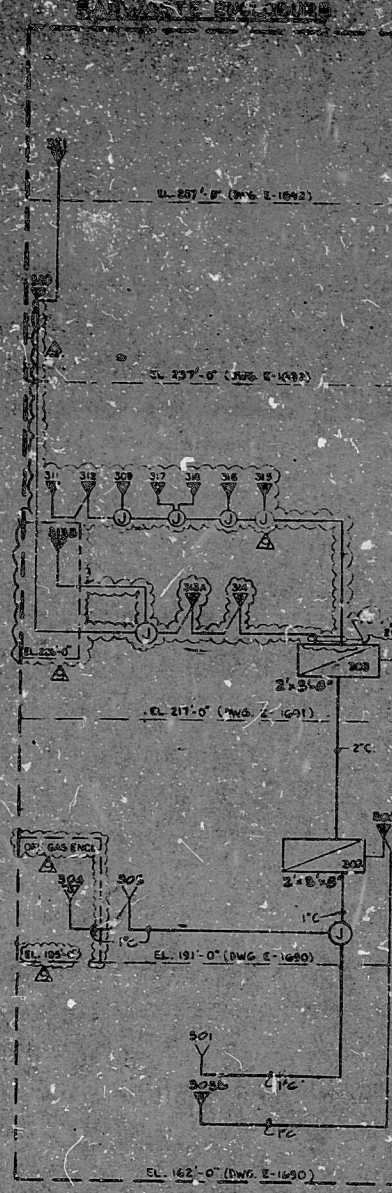
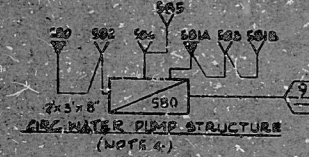
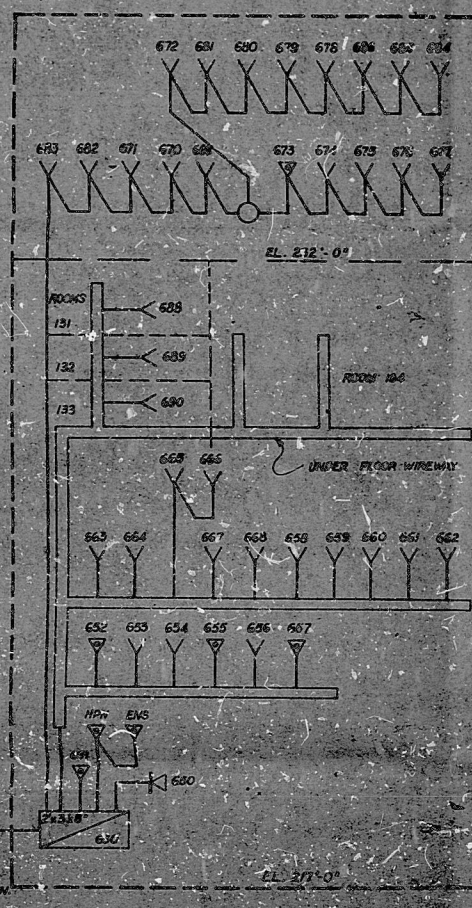
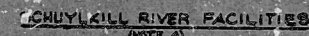





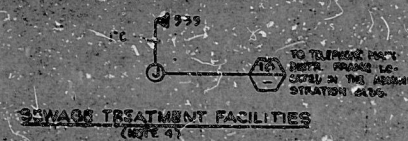

NOTES

1. ALL BOXES TO BE WALL MOUNTED.
2. ALL CONDUIT RUNS TO BE LIMITED TO TWO FEET, UNLESS OTHERWISE SPECIFIED.
4. CONDUITS FOR PAXS EQUIPMENT ARE TO BE INSTALLED BY SUBCONTRACTORS IN THE SUBCONTRACTED BUILDING (SEE SUBCONTRACTS FOR CONDUIT LAYOUT). SECTEL FIELD SHALL INSTALL CONDUIT FOR THE PAXS SYSTEM IN OTHER BUILDINGS. SEE SUBCONTRACTS FOR PAXS SYSTEM EQUIPMENT & CABLES.
5. FOR THE TELEPHONE (PAXS) SYSTEM SYMBOLS SEE PWS E-1269.
6. FOR LOAD DISPATCHED TELEPHONE DESCRIPTION SEE NOTE 6 OF REFERENCE PWS E-1475.
7. CONDUIT SHALL BE RUN IN 3 WALLS SEE NOTE 7 OF REFERENCE PWS E-1407.

REFERENCE DRAWINGS

- E-1363 RISER DIAGRAM - TELEPHONE SYSTEM (PAXS) - UNIT 1.
- E-1470 RISER DIAGRAM - TELEPHONE SYSTEM (PAXS) - UNIT 2.
- E-1407 COMMUNICATIONS - SYMBOLS AND DETAILS.
- E-1453 COMMUNICATIONS - FIRE ALARM LAYOUT - AUXILIARY POWER ENCLOSURE - ABOVE EL. 217'-0" & 217'-0".
- E-1407 SCHUYLKILL RIVER FACILITIES - PUMPING STATION - LIGHTING.
- E-5001 LIGHTING - CIRCULATING WATER PUMP STRUCTURE ABOVE EL. 217'-0" & 217'-0".
- E-5601 LIGHTING - WATER TREATMENT ENCLOSURE - ABOVE EL. 217'-0".
- LATER TECHNICAL SUPPORT CENTER.
- E-5601 SEWAGE TREATMENT FACILITIES CONDUIT LIGHTING & GROUNDING PLAN.
- E-7007 ADMIN. BLDG., SHOPS AND WAREHOUSE - FIRE ALARM AND COMM. - ABOVE EL. 217'-0".
- E-7008 ADMIN. BLDG., SHOPS AND WAREHOUSE - FIRE ALARM AND COMM. - BASEMENT, SECOND FLOOR AND ABOVE.
- E-7009 ADMIN. BLDG., SHOPS AND WAREHOUSE - FIRE ALARM AND COMM. - RISER DIAGRAM.
- E-1475 COMMUNICATIONS & FIRE ALARM LAYOUT - MAIN CONTROL ROOM ABOVE EL. 263'-0".
- E-1467 COMMUNICATIONS & FIRE ALARM LAYOUT - DIESEL GENERATOR ENCL. - UNIT 1 - EL. 217'-0".
- E-1467 COMMUNICATIONS & FIRE ALARM LAYOUT - DIESEL GENERATOR ENCL. - UNIT 2 - EL. 217'-0".
- E-1465 COMMUNICATIONS & FIRE ALARM LAYOUT - SPRAY POND PUMP STRUCTURE EL. 263'-0".

REVISION	DATE	BY	CHKD	APP'D	DESCRIPTION

PDR RIDS

8405240488

