


GENERAL ELECTING		147D7090
INSERT P601-21B		
NUCLEAR SAFETY RELATED		
OVERALL REVISION	5	SUMMARY SHEET
		1 5
		3 0

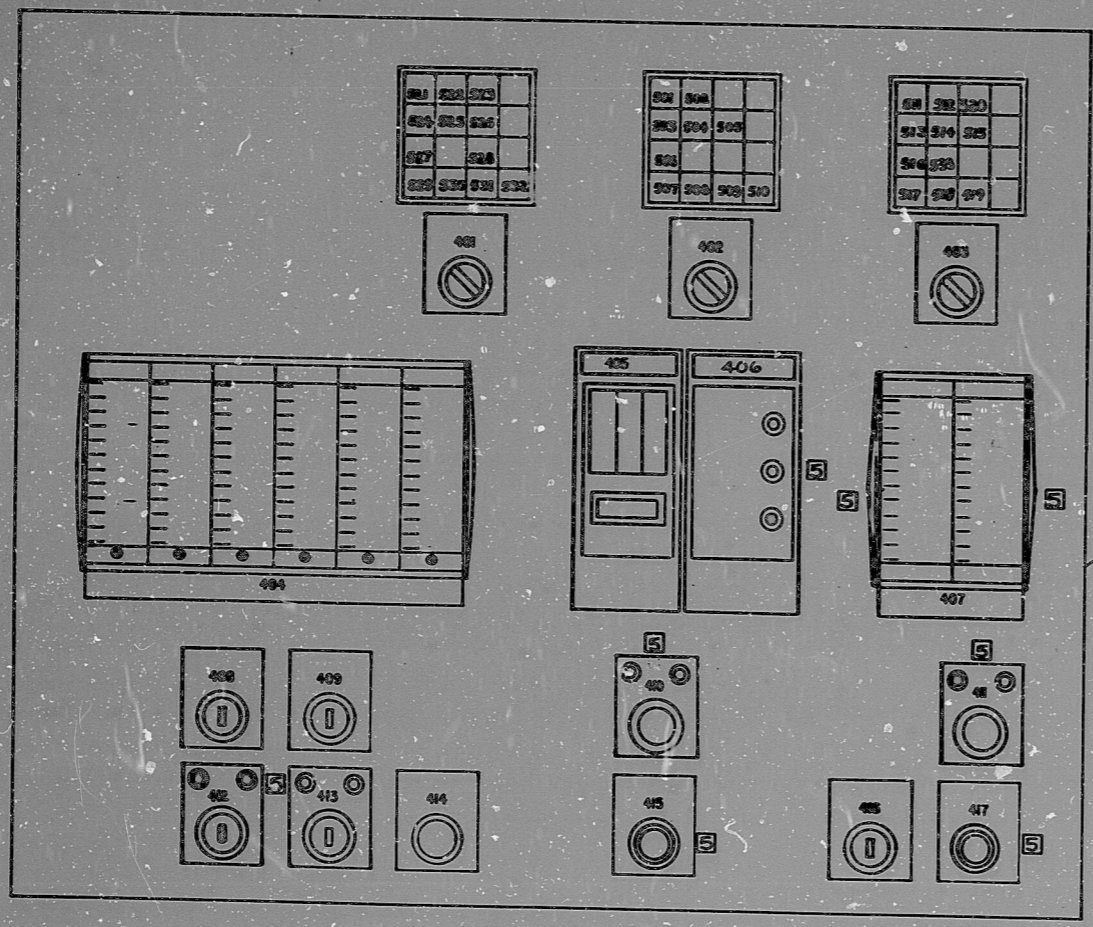

- NOTES:
- FOR ITEMS 1 THRU 100 SEE NSS EDL ITEM 152. FOR ITEMS 101 THRU 130 SEE BOP EDL ITEM 133.
 - MARK REFERENCE DESIGNATION PER ZLAS98B ADJACENT TO DEVICE ON REAR OF INSERT.
 - WIRE INSERT PER WIRE LIST ITEM 154.
 - FOR CONTACT ARRANGEMENT SEE 167A2804
 - FOR CONTACT ARRANGEMENT SEE 272A7472
 - FOR CONTACT ARRANGEMENT SEE 8318603
 - TRIM JUNCTION BRACKETS FOR 150 METERS PER CLAMP MODIFICATION DWG 272A8965.
 - INSTALL ITEM 189 (SWITCH) IN POSITIONS INDICATED BY ITEM 231 (MARKER PLATE). INSTALL ITEMS 361, 362 & 315 IN REMAINING POSITIONS.
 - MARK REFERENCE DESIGNATIONS FOR JAY-EL INDICATORS AS SHOWN USING .12 HIGH CHARACTERS.
 - REMOVE BULBS SUPPLIED WITH ITEM 189 AND REPLACE WITH ITEM 182 (BULBS)

PL ITEM NUMBER
 REFERENCE DESIGNATIONS
 SEE NOTE 2

TERA
 APERTURE
 CARD

BALDWIN
 COPY
 AUG 18 1981
 FOR REFERENCE ONLY
 Not To Be Used For Construction

REV	DATE	BY	CHKD	DESCRIPTION	REV	DATE	BY	CHKD	DESCRIPTION

1	2	3	4	5	6	7	8	9	10
								CI	ES

RIDS

81112079

