
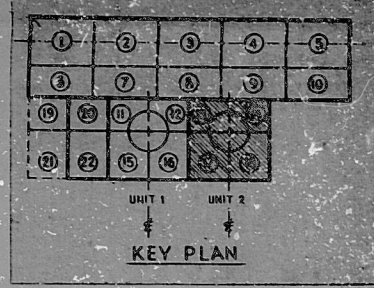


H
G
F
E
D
C
B
A

FOR CONSTRUCTION USE				
ADDED	REVISED	DELETED	DATE	BY
	218603-AT31 G-6	208603-1RS G-6		
		208603-1RS G-6		
# DWG. ONLY				

MATCH LINE FOR CONT. SEE DWG.

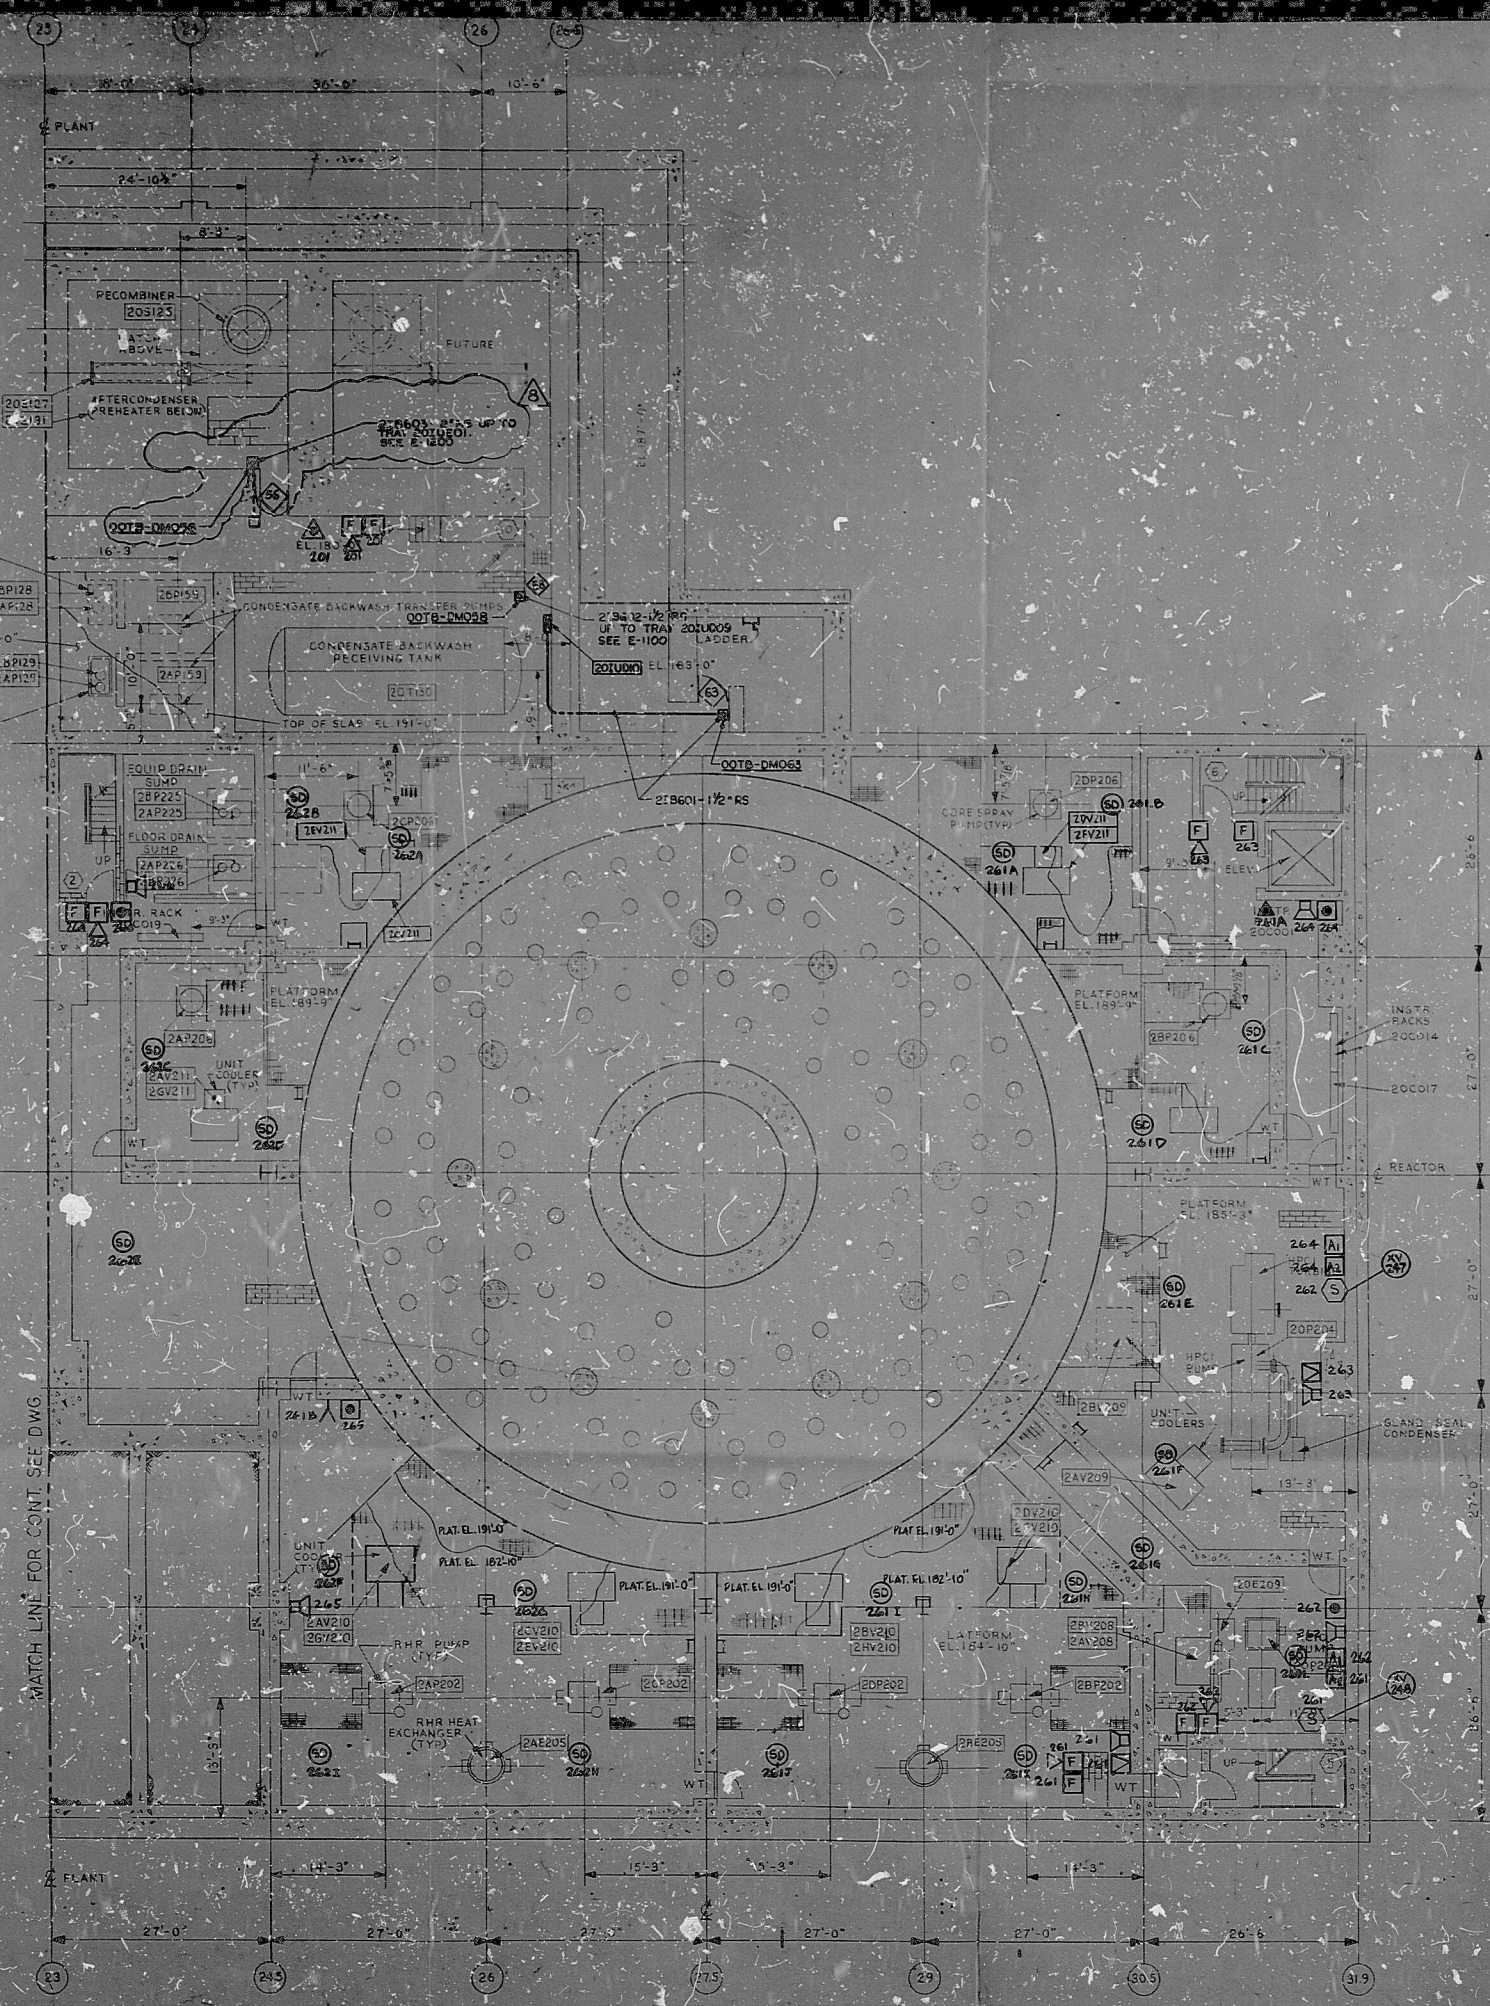

- NOTES
1. FOR FIRE ALARM RACEWAY SYSTEM SEE RISER DIAGRAM DWG. NO. E-1361
 2. FOR PUBLIC ADDRESS RACEWAY SYSTEM SEE RISER DIAGRAM DWG. NO. E-1370
 3. FOR PABX RACEWAY SYSTEM SEE RISER DIAGRAM DWG. NO. E-1370
 4. FOR TYPICAL INSTALLATION OF DOOR MONITOR SEE DWG. E-1407.
 5. $\diamond$ DENOTES "DOOR" MARK NO.

- REFERENCE DRAWINGS
- E-1408 FIRE ALARM SYSTEM - NOTES, SYMBOLS AND DETAILS
 - E-1361 RISER DIAGRAM FIRE ALARM SYSTEM - UNIT 2
 - E-1407 COMMUNICATION - NOTES, SYMBOLS & DETAILS
 - E-1367 RISER DIAGRAM PUBLIC ADDRESS SYSTEM - UNIT 2
 - E-1370 RISER DIAGRAM TELEPHONE SYSTEM (PABX) - UNIT 2

1/2" = 1'-0"	AS COR. FOR 2731E.	1/2" = 1'-0"	1/2" = 1'-0"
1/4" = 1'-0"	MODIFIED FROM NO. 1	1/4" = 1'-0"	1/4" = 1'-0"
1/8" = 1'-0"	NOTES 1 & 2	1/8" = 1'-0"	1/8" = 1'-0"
PDR RIDS

8405240556

