

22"

17"

11"

8.5"


8.5"

11"

17"

22"

This drawing and the design it covers are the property of BECHTEL. They are hereby loaned and on the borrower's express agreement that they will not be reproduced, copied, altered, changed, or made except as set forth here and permitted by any written consent given by the issuer in the instrument.

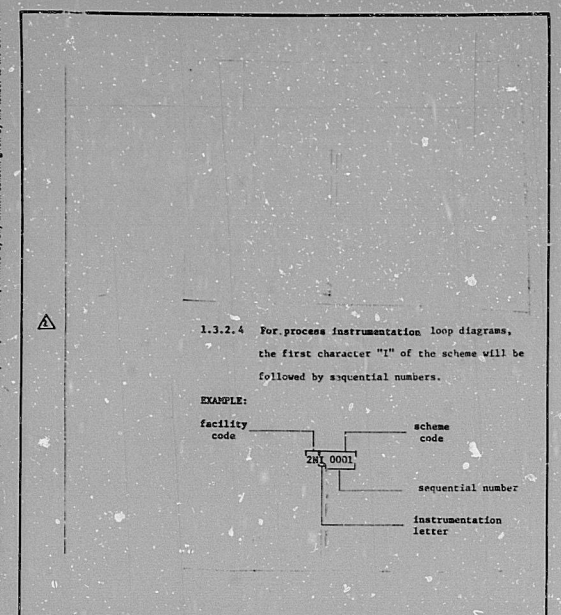

NO.	DATE	REVISIONS	BY	CHK'D	ISSUED	DATE	APP'D
1		REVISED AS SHOWN					
2		REWORKED AS SHOWN					
3		REWORKED FOR CONSTRUCTION					

TITLE: MIDLAND PLANT UNITS 1 & 2  
 DRAWING NO.: 220  
 SHEET NO.: 2

TERA  
APERTURE  
CARD

16X

I certify that the image contained on this frame was made in the normal and regular course of business, on the date stated below and that it is an accurate reproduction of the document submitted to reprographics.

22"

RIDS

811120852

