


17"
11"
8.5"
8.5"
11"
17"

17"
11"
8.5"
8.5"
11"
17"

This drawing and the design it covers are the property of BECHTEL. They are hereby loaned and on the borrower's express agreement that they will not be reproduced, copied, loaned, exhibited, or used except in the limited way and private use permitted by any written consent given by the lender to the borrower.

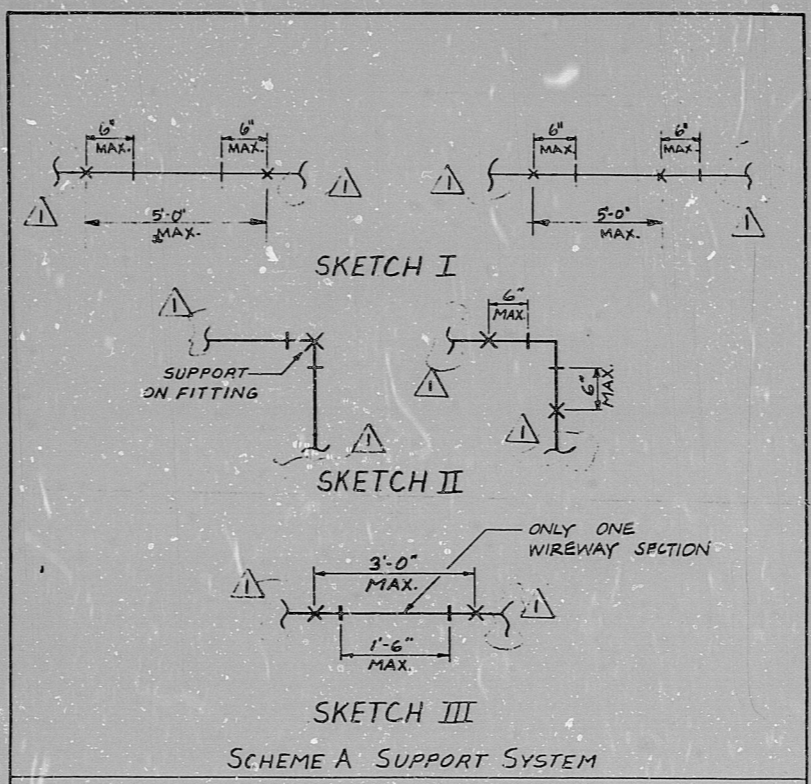

△									
△	10-24-78	ADDED BREAK LINES TO SKETCHES	CLD	9.00	CLD				
△	8/16/78	ISSUED FOR CONSTRUCTION	BOM	9.00	BEM	89			
No.	DATE	REVISIONS	BY	CHK'D	GROUP LEAD	GROUP SUPV.	PROJ. ENGR.	CHIEF ENGR.	
SCALE N.T.S.			DESIGNED B. C. McCONNEL	DRAWN D. HONSE					
ORIGIN			MIDLAND PLANT UNIT 1 & 2 CONSUMERS POWER COMPANY SEISMIC WIREWAY SUPPORTS NOTES, SYMBOLS & DETAILS			JOB No. 7220			
						DRAWING No.		REV.	
						E-39(Q) SH.7		1	

"I certify that the image contained on this frame was made in the normal and regular course of business, on the date stated below and that it is an accurate reproduction of the document submitted to the contractor for filming, by Bechtel Power Corporation.

16X

10-26-81 B. Capello
DATE CAMERA OPERATOR CONT. FOR'S SUP'VR. OR MANAGER

TERA APERTURE CARD

RIDS

811120876

