

22"

22"

17"

17"

11"

11"

8.5"

8.5"

8.5"

8.5"

11"


11"

17"

17"

22"

22"

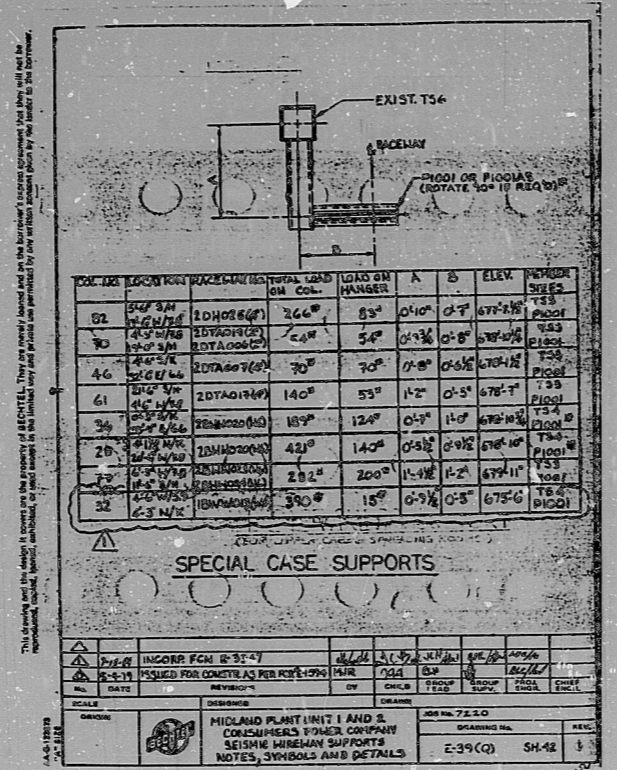

TERA APERTURE CARD

16X

I certify that the image contained on this frame was made in the normal and regular course of business, on the date stated below and that it is an accurate reproduction of the document

RIDS

811120884

