


THIS DRAWING AND THE DESIGN IT CARRIES ARE THE PROPERTY OF BECHTEL. THEY ARE HEREBY LOANED AND ON THE BORROWER'S EXPRESS ASSISEMENT THAT THEY WILL NOT BE REPRODUCED, COPIED, LOANED, EXHIBITED, OR USED EXCEPT IN THE LIMITED WAY AND PRIVATE USE PERMITTED BY ANY WRITING CONSISTENT WITH THE INTERESTS OF THE BORROWER.

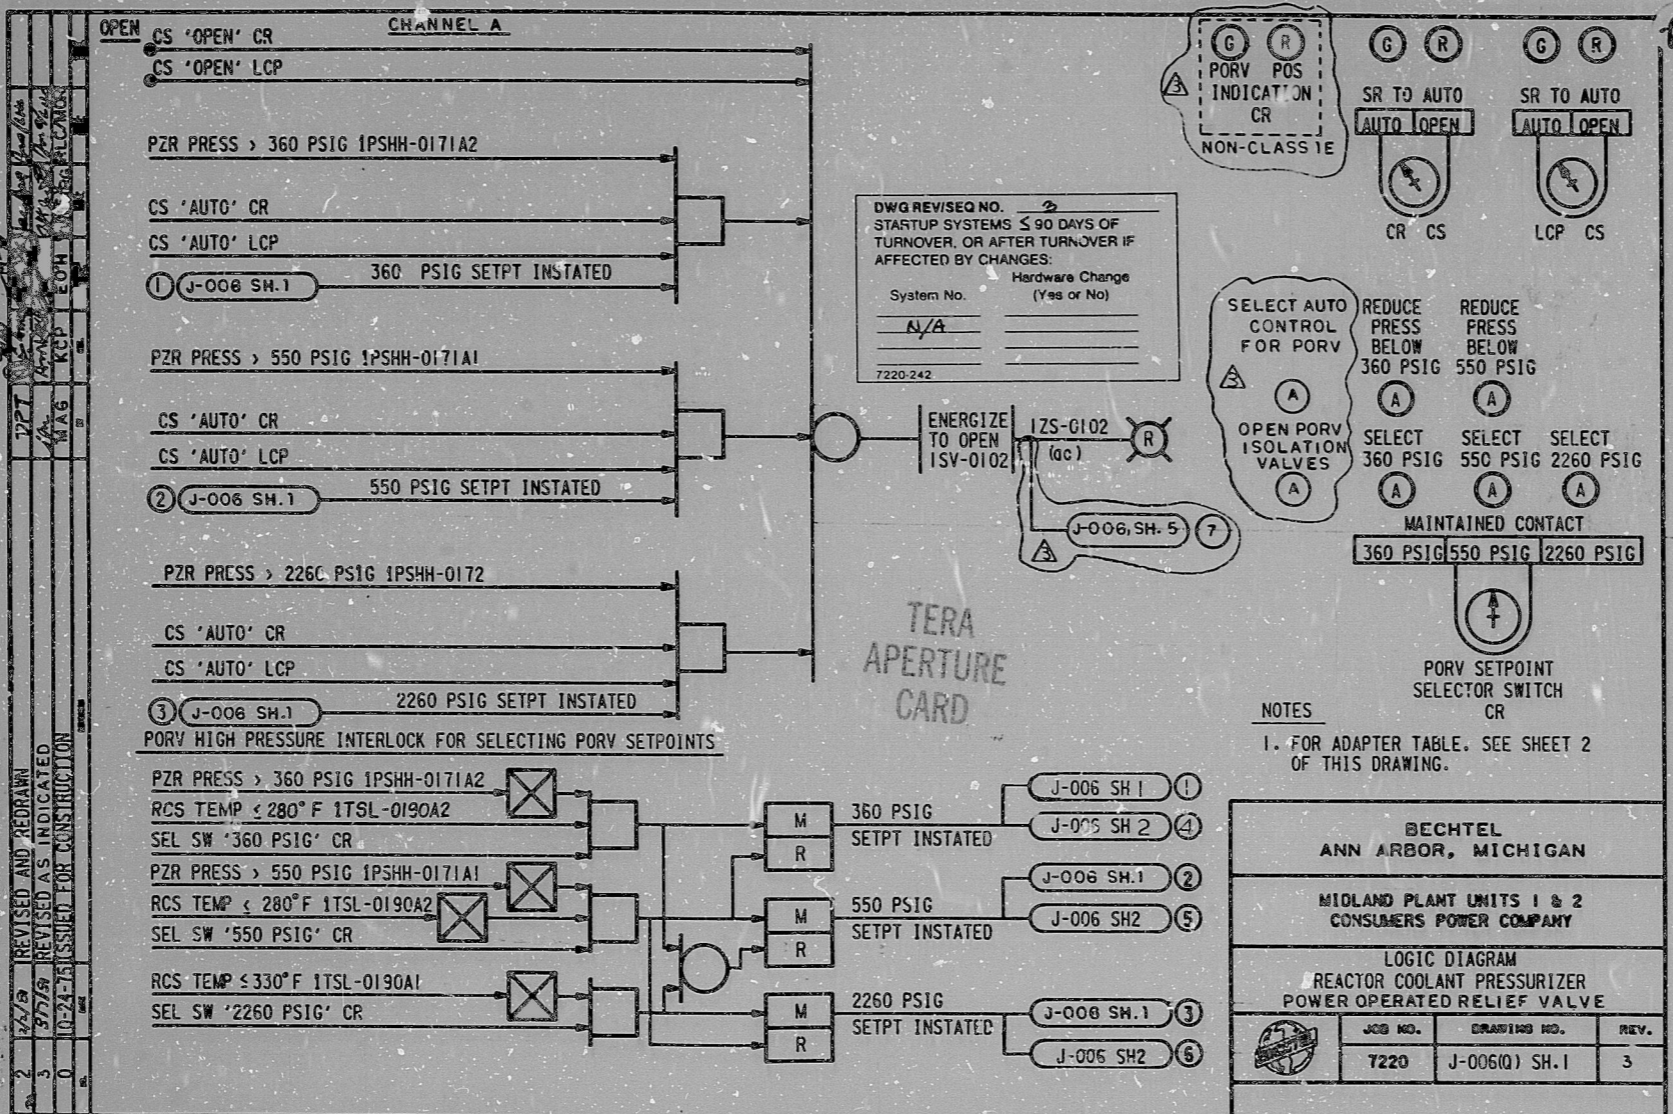

I certify that the image contained on this frame was made in the normal and regular course of business, on the date stated below and that it is an accurate reproduction of the document submitted to reprographics.

16X

8-17-81
DATE
R. G. G. [Signature]
CAMERA OPERATOR SUPERVISOR OF REPROGRAPHICS

G-1348

RIDS

811120894

