



This drawing and the design it covers are the property of BECHTEL. They are hereby loaned and on the borrower's express agreement that they will not be reproduced, copied, loaned, exhibited, or used except in the limited way and private use permitted by any written consent given by the lender to the borrower.

DATE	BY	REVISION
11-27-72	J. R. BROWN	REVISED AS INDICATED
11/21/72	J. R. BROWN	REDRAWN - REVISED AS INDICATED
5-27-75	J. R. BROWN	ISSUED FOR CONSTRUCTION
0		
3		

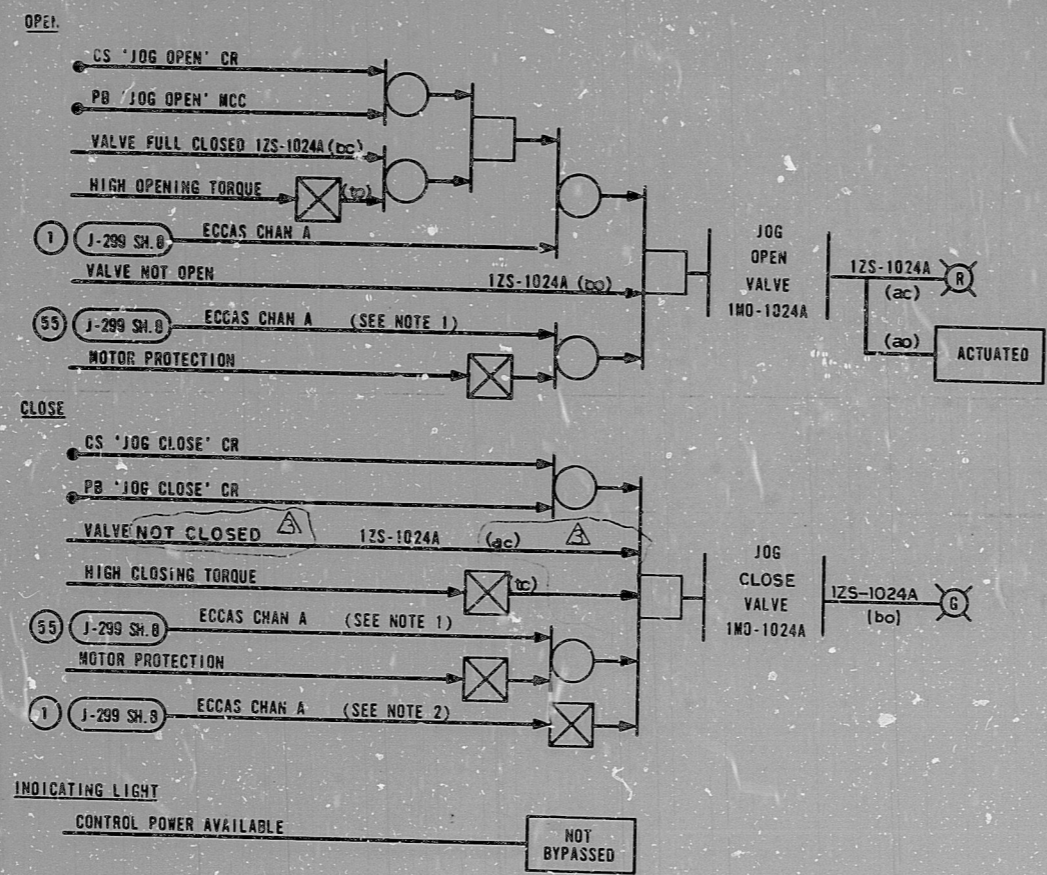

NOT BYPASSED
ACTUATED
CR ECCAS STATUS

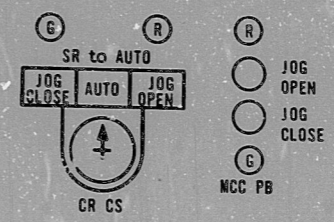

TERA APERTURE CARD

- NOTES:
1. THE ECCAS FOR THERMAL OVERLOAD PROTECTION IS BLOCKED INDEPENDENTLY OF THE ECCAS FOR AUTO OPEN.
 2. THE ECCAS AUTO OPEN SIGNAL MUST BE BLOCKED IF JOG CLOSE IS NECESSARY FOR FLOW CONTROL DURING AN ECCAS EVENT.

BECHTEL ANN ARBOR, MICHIGAN		
MIDLAND PLANT UNITS 1 & 2 CONSUMERS POWER COMPANY		
LOGIC DIAGRAM LOW PRESSURE INJECTION FLOW CONTROL VALVES		
JOB No.	DRAWING No.	REV.
7220	J-018 (0) SH 1 OF 2	3

I CERTIFY THAT THE IMAGE CONTAINED ON THIS FRAME WAS MADE IN THE NORMAL AND REGULAR COURSE OF BUSINESS, ON THE DATE STATED BELOW AND THAT IT IS AN ACCURATE REPRODUCTION OF THE DOCUMENT SUBMITTED TO REPROGRAPHICS.

12/1/78 DATE
SUPERVISOR OF REPROGRAPHICS

RIDS

811120898

