


This drawing and the design it covers are the property of BECHTEL. They are merely loaned and on the borrower's express agreement that they will not be reproduced, copied, loaned, exhibited, or used except in the limited way and private use permitted by any written consent given by the lender to the borrower.

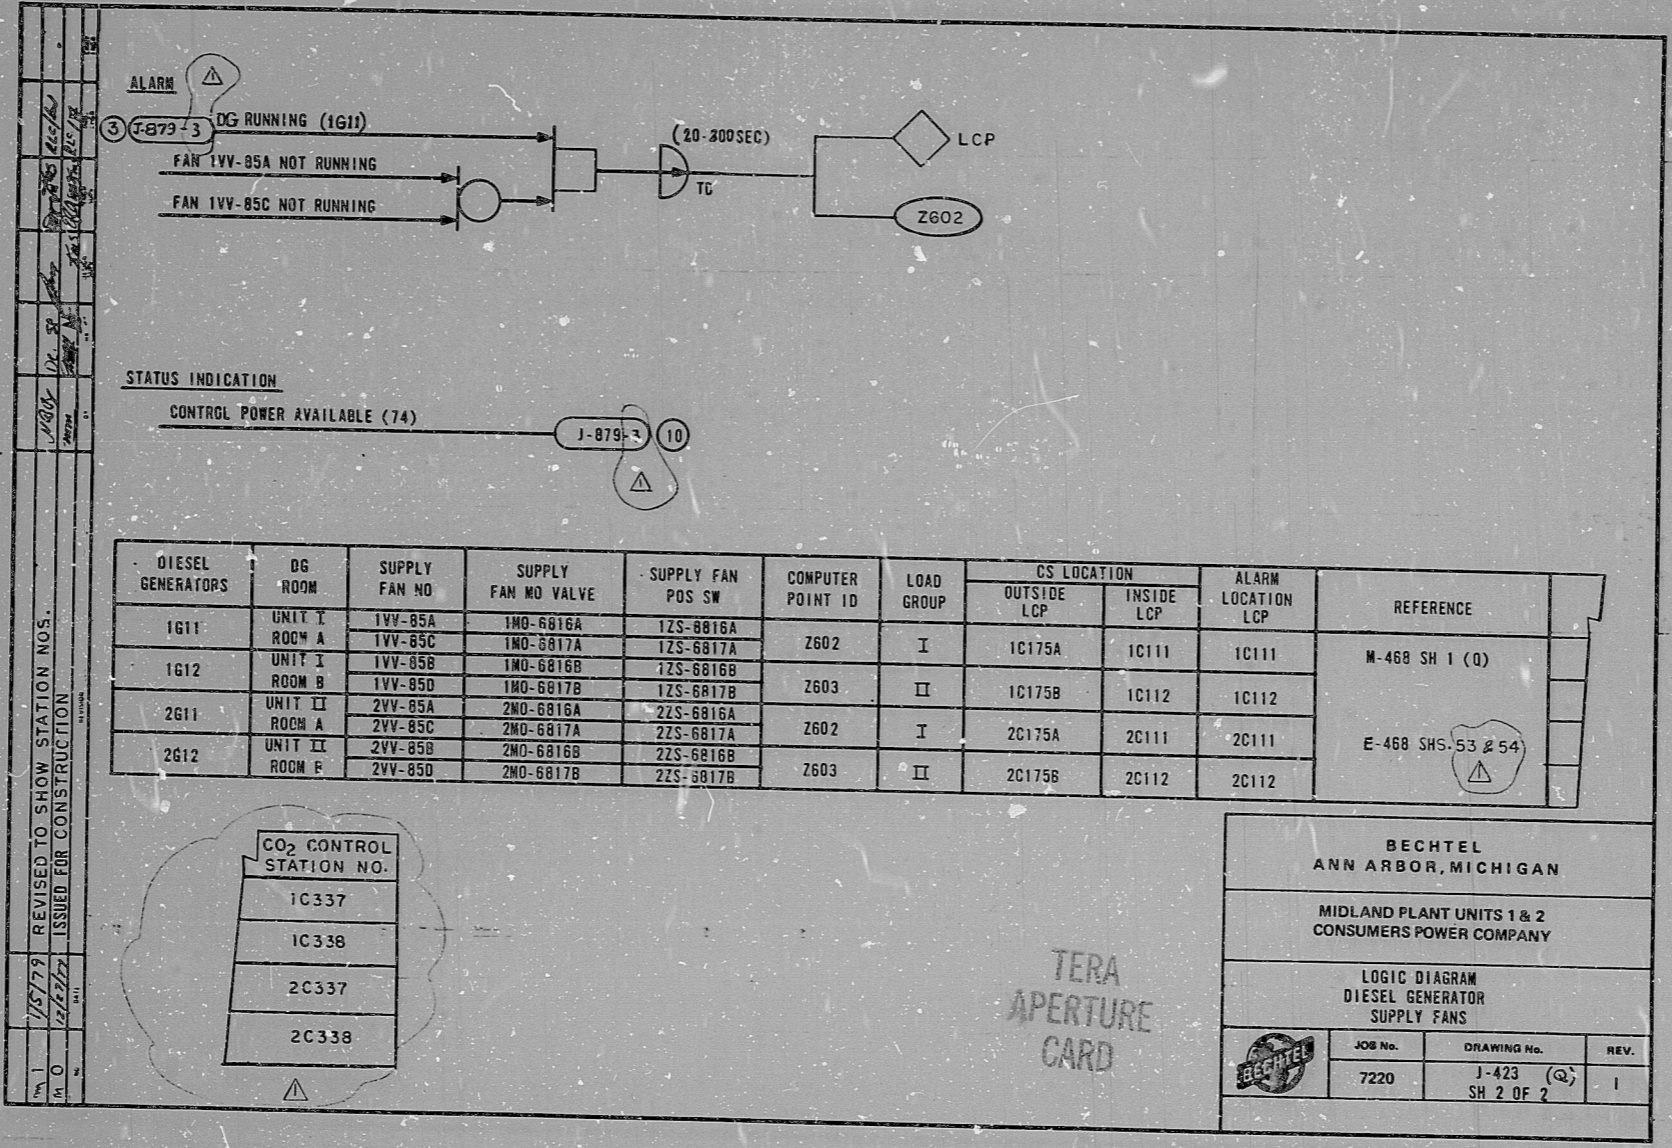

DIESEL GENERATORS	DG ROOM	SUPPLY FAN NO	SUPPLY FAN MD VALVE	SUPPLY FAN POS SW	COMPUTER POINT ID	LOAD GROUP	CS LOCATION		ALARM LOCATION LCP	REFERENCE
							OUTSIDE LCP	INSIDE LCP		

CO <sub>2</sub> CONTROL STATION NO.
1C337
1C338
2C337
2C338

TERA APERTURE CARD

BECHTEL  
ANN ARBOR, MICHIGAN

MIDLAND PLANT UNITS 1 & 2  
CONSUMERS POWER COMPANY

LOGIC DIAGRAM  
DIESEL GENERATOR  
SUPPLY FANS

JOB No.	DRAWING No.	REV.
7220	J-423 (Q) SH 2 OF 2	1

REVISED TO SHOW STATION NOS.  
ISSUED FOR CONSTRUCTION

RIDS

811130069

