


This drawing and the design it covers are the property of BECHTEL. They are merely loaned and on the borrower's express agreement that they will not be reproduced, copied, loaned, exhibited, or used except in the limited way and private use permitted by any written content given by the lender to the borrower.

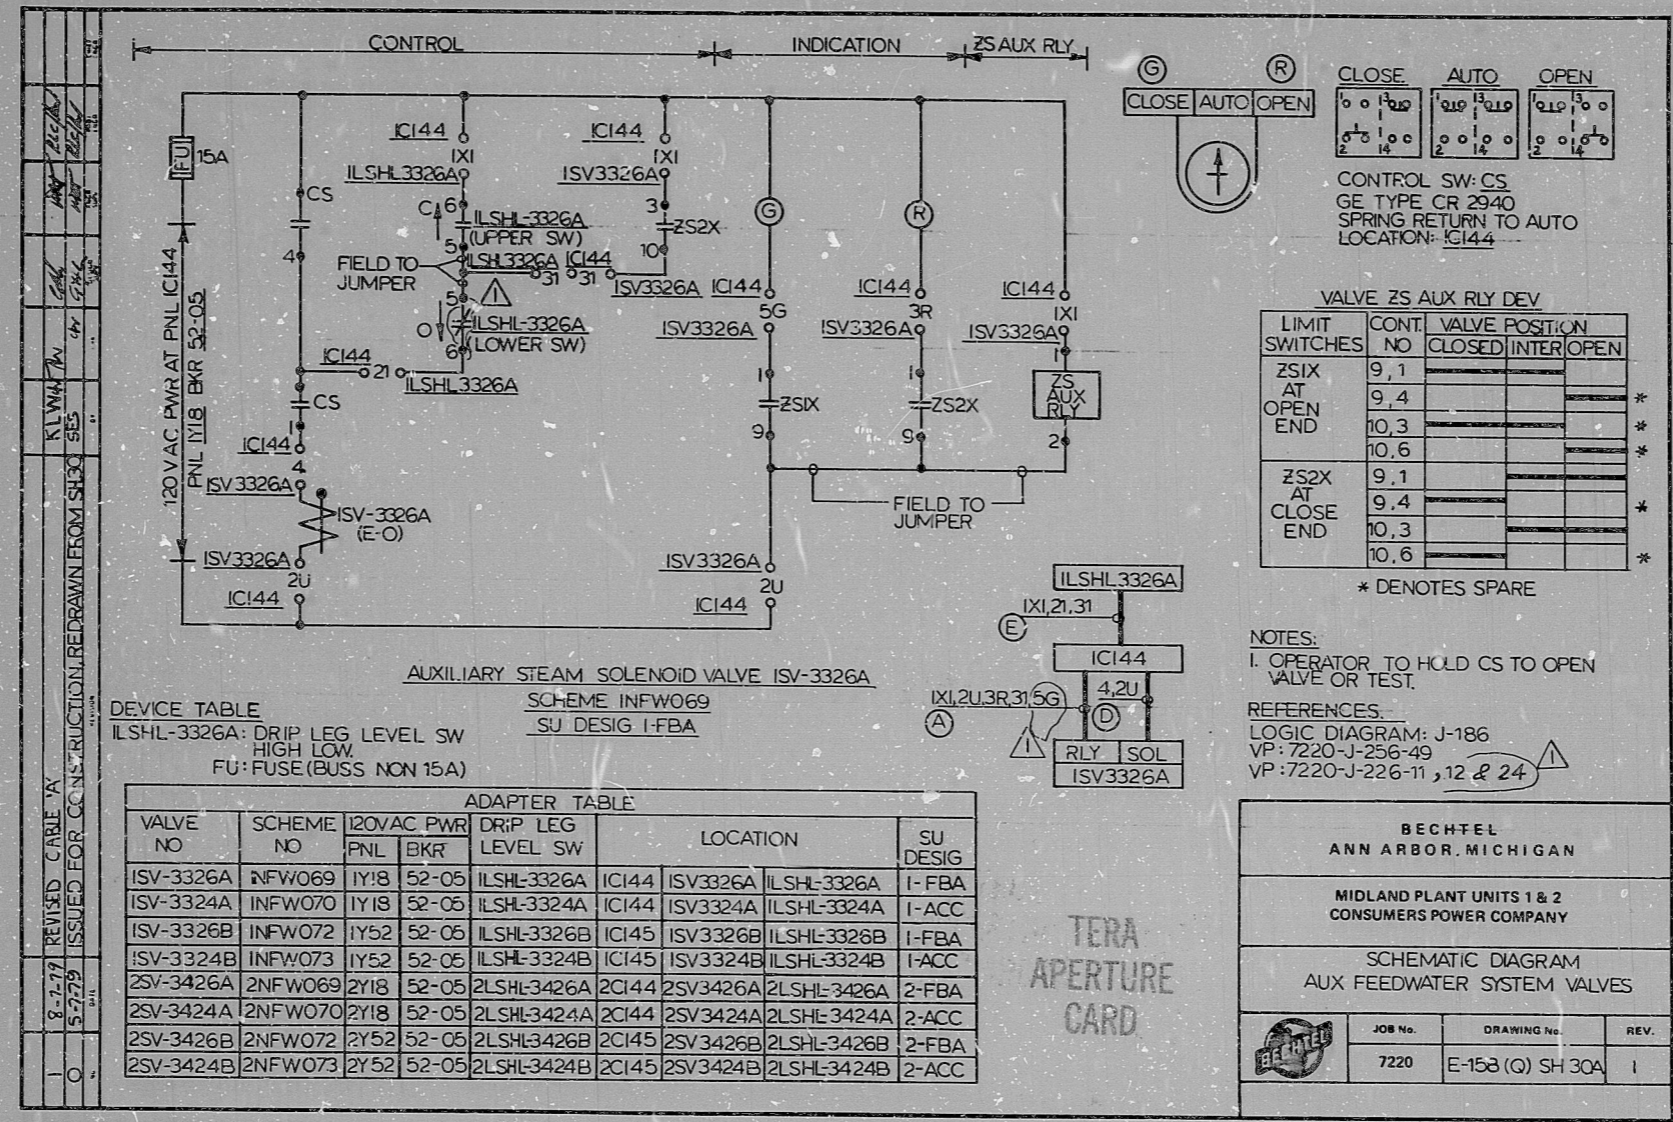

I certify that the image contained on this frame was made in the normal and regular course of business, on the date stated below and that it is an accurate reproduction of the document submitted to reprographics.

**16X**

TERA  
 APERTURE  
 CARD

<b>BECHTEL</b> ANN ARBOR, MICHIGAN		
MIDLAND PLANT UNITS 1 & 2 CONSUMERS POWER COMPANY		
SCHEMATIC DIAGRAM AUX FEEDWATER SYSTEM VALVES		
	JOB No. 7220	DRAWING No. E-153 (Q) SH 30A
	REV. 1	

17"  
 11"  
 8.5"

17"  
 11"  
 8.5"



RIPS

811130091

