


17"  
11"  
8.5"

17"  
11"  
8.5"

This drawing and the design it covers are the property of BECHTEL. They are hereby loaned and on the borrower's express agreement that they will not be reproduced, copied, loaned, exhibited, or used except in the limited way and period as permitted by any written consent given by the lender to the borrower.

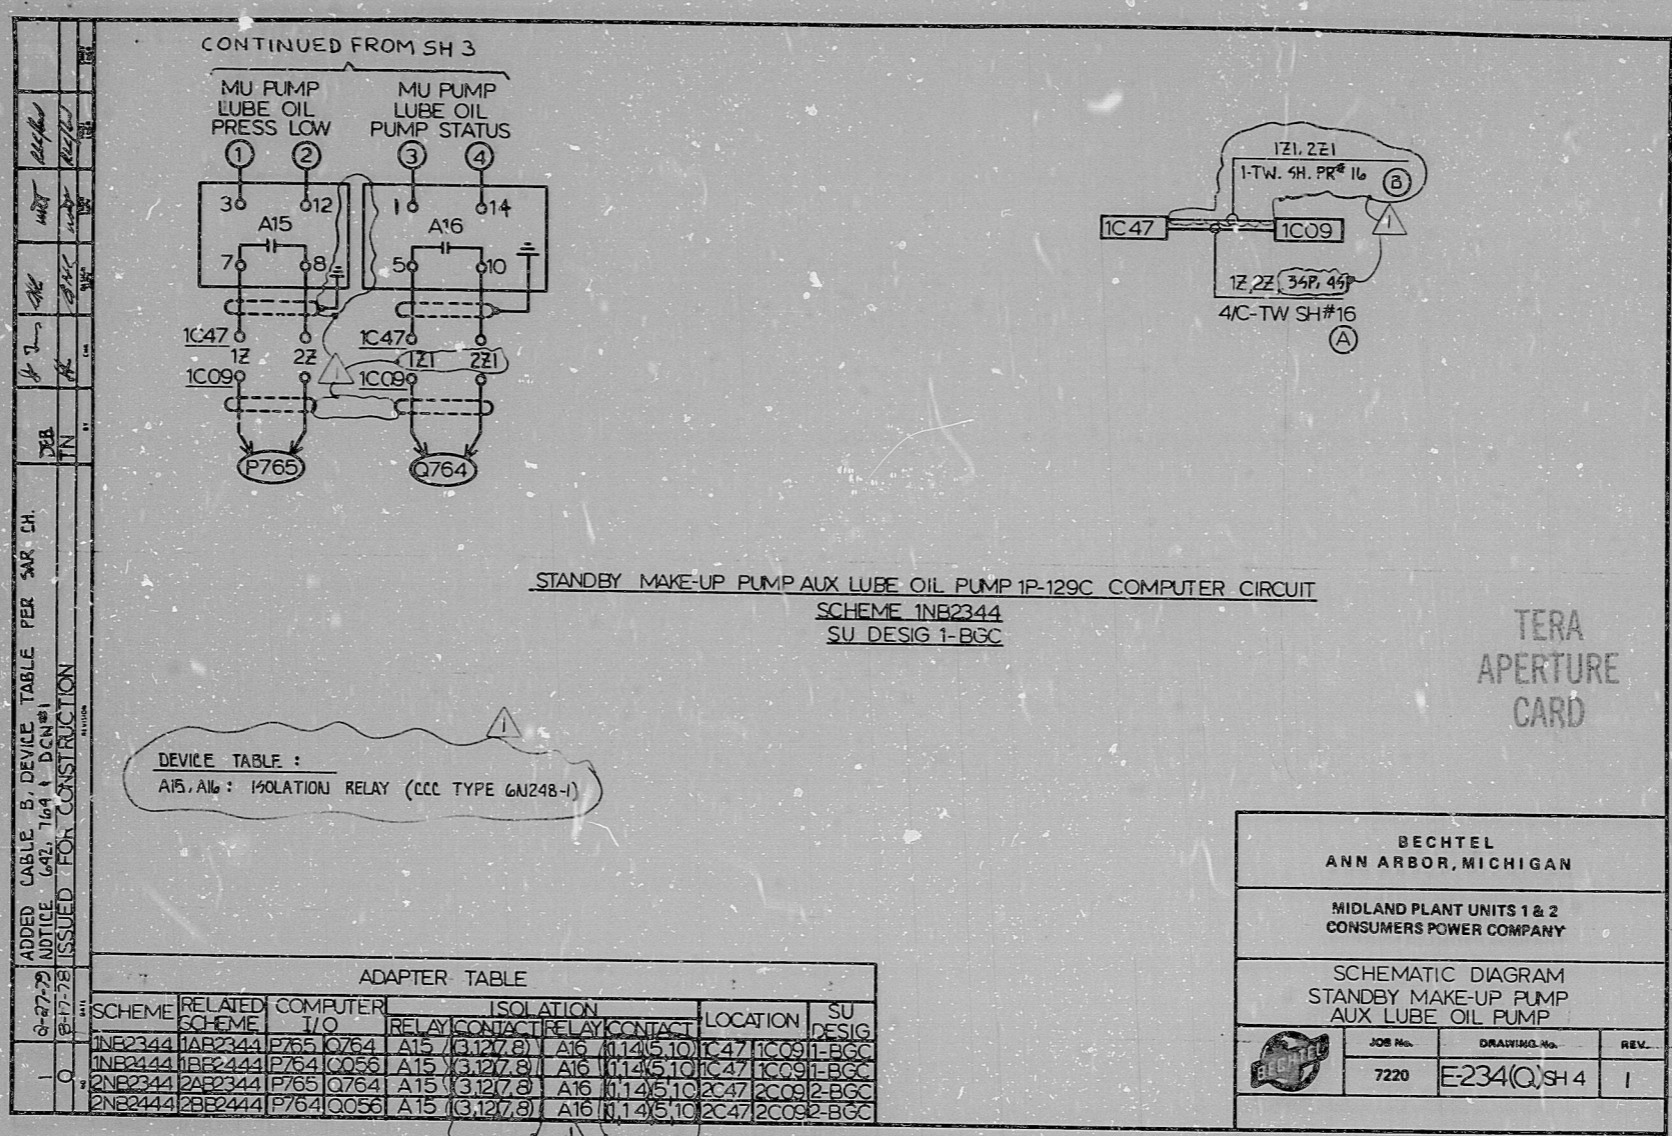

I certify that the image contained on this frame was made in the normal and regular course of business, on the date stated below and that it is an accurate reproduction of the document submitted to reprographics.

6/4/81 DATE  
Butler J. [Signature] CAMERA OPERATOR  
SUPERVISOR OF REPROGRAPHICS

16X

BECHTEL ANN ARBOR, MICHIGAN		
MIDLAND PLANT UNITS 1 & 2 CONSUMERS POWER COMPANY		
SCHEMATIC DIAGRAM STANDBY MAKE-UP PUMP AUX LUBE OIL PUMP		
JOB No. 7220	DRAWING No. E-234(Q)SH 4	REV. 1



RIDS

811130120

