

17"

11"

8.5"

8.5"

11"

17"

17"

11"

8.5"

8.5"


11"

17"



24X

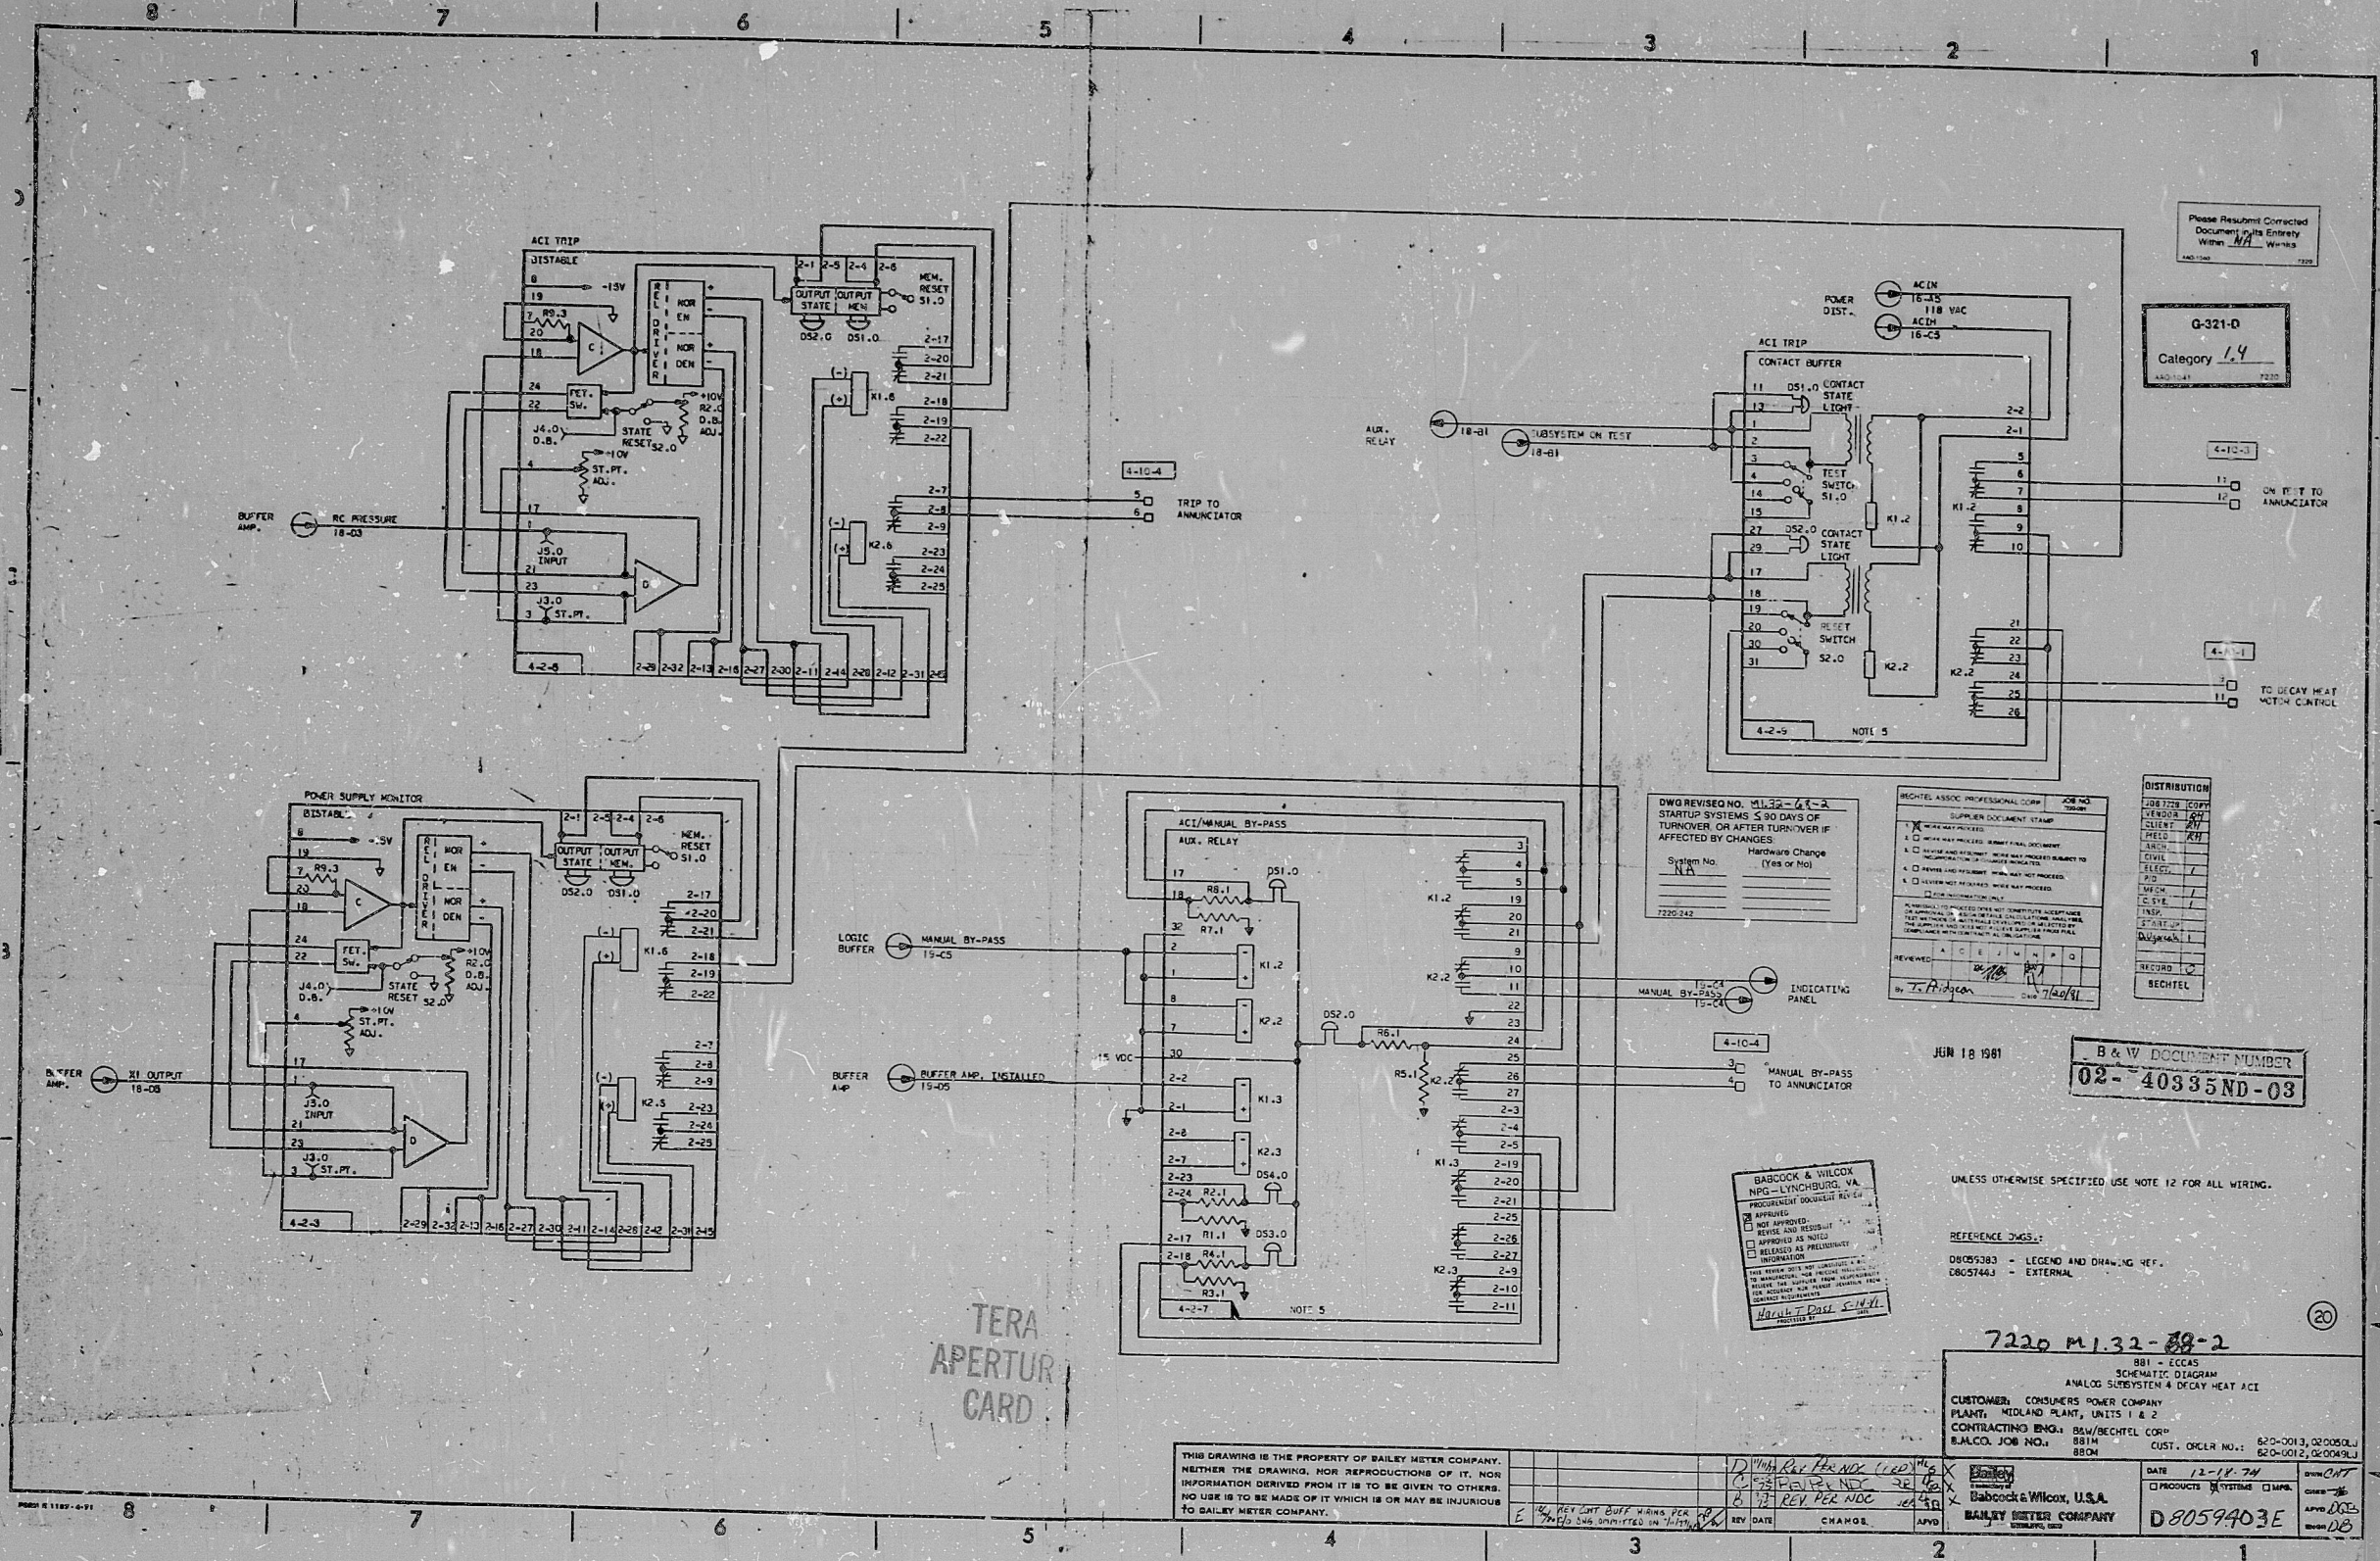

TERA APERTURE CARD


G-321-D
Category **1.4**

DWG REVISION NO. **M.1.32-88-2**
STARTUP SYSTEMS 5 TO 90 DAYS OF TURNOVER ON AFTER TURNOVER IF AFFECTED BY CHANGES

System No. **NA**
Hardware Change (Yes or No)

B & W DOCUMENT NUMBER
02-40335ND-03

UNLESS OTHERWISE SPECIFIED USE NOTE 12 FOR ALL WIRING.

REFERENCE DWGS:
D8059383 - LEGEND AND DRAWING REF.
D8057443 - EXTERNAL

7220 M.1.32-88-2

ANALOG SUBSYSTEM & DECAY HEAT ACI

CUSTOMER: CONSUMERS POWER COMPANY
PLANT: MIDLAND PLANT, UNITS 1 & 2
CONTRACTING ENG.: B&W/BECHTEL CORP.
B.A.L.C.O. JOB NO.: 881M
BECHTEL

D8059403E

THIS DRAWING IS THE PROPERTY OF BAILEY METER COMPANY. NEITHER THE DRAWING, NOR REPRODUCTIONS OF IT, NOR INFORMATION DERIVED FROM IT IS TO BE GIVEN TO OTHERS. NO USE IS TO BE MADE OF IT WHICH IS OR MAY BE INJURIOUS TO BAILEY METER COMPANY.


RIPS

81113a73

