

17"

11"

8.5"

8.5"

11"

17"

17"


11"

8.5"

8.5"

11"

17"

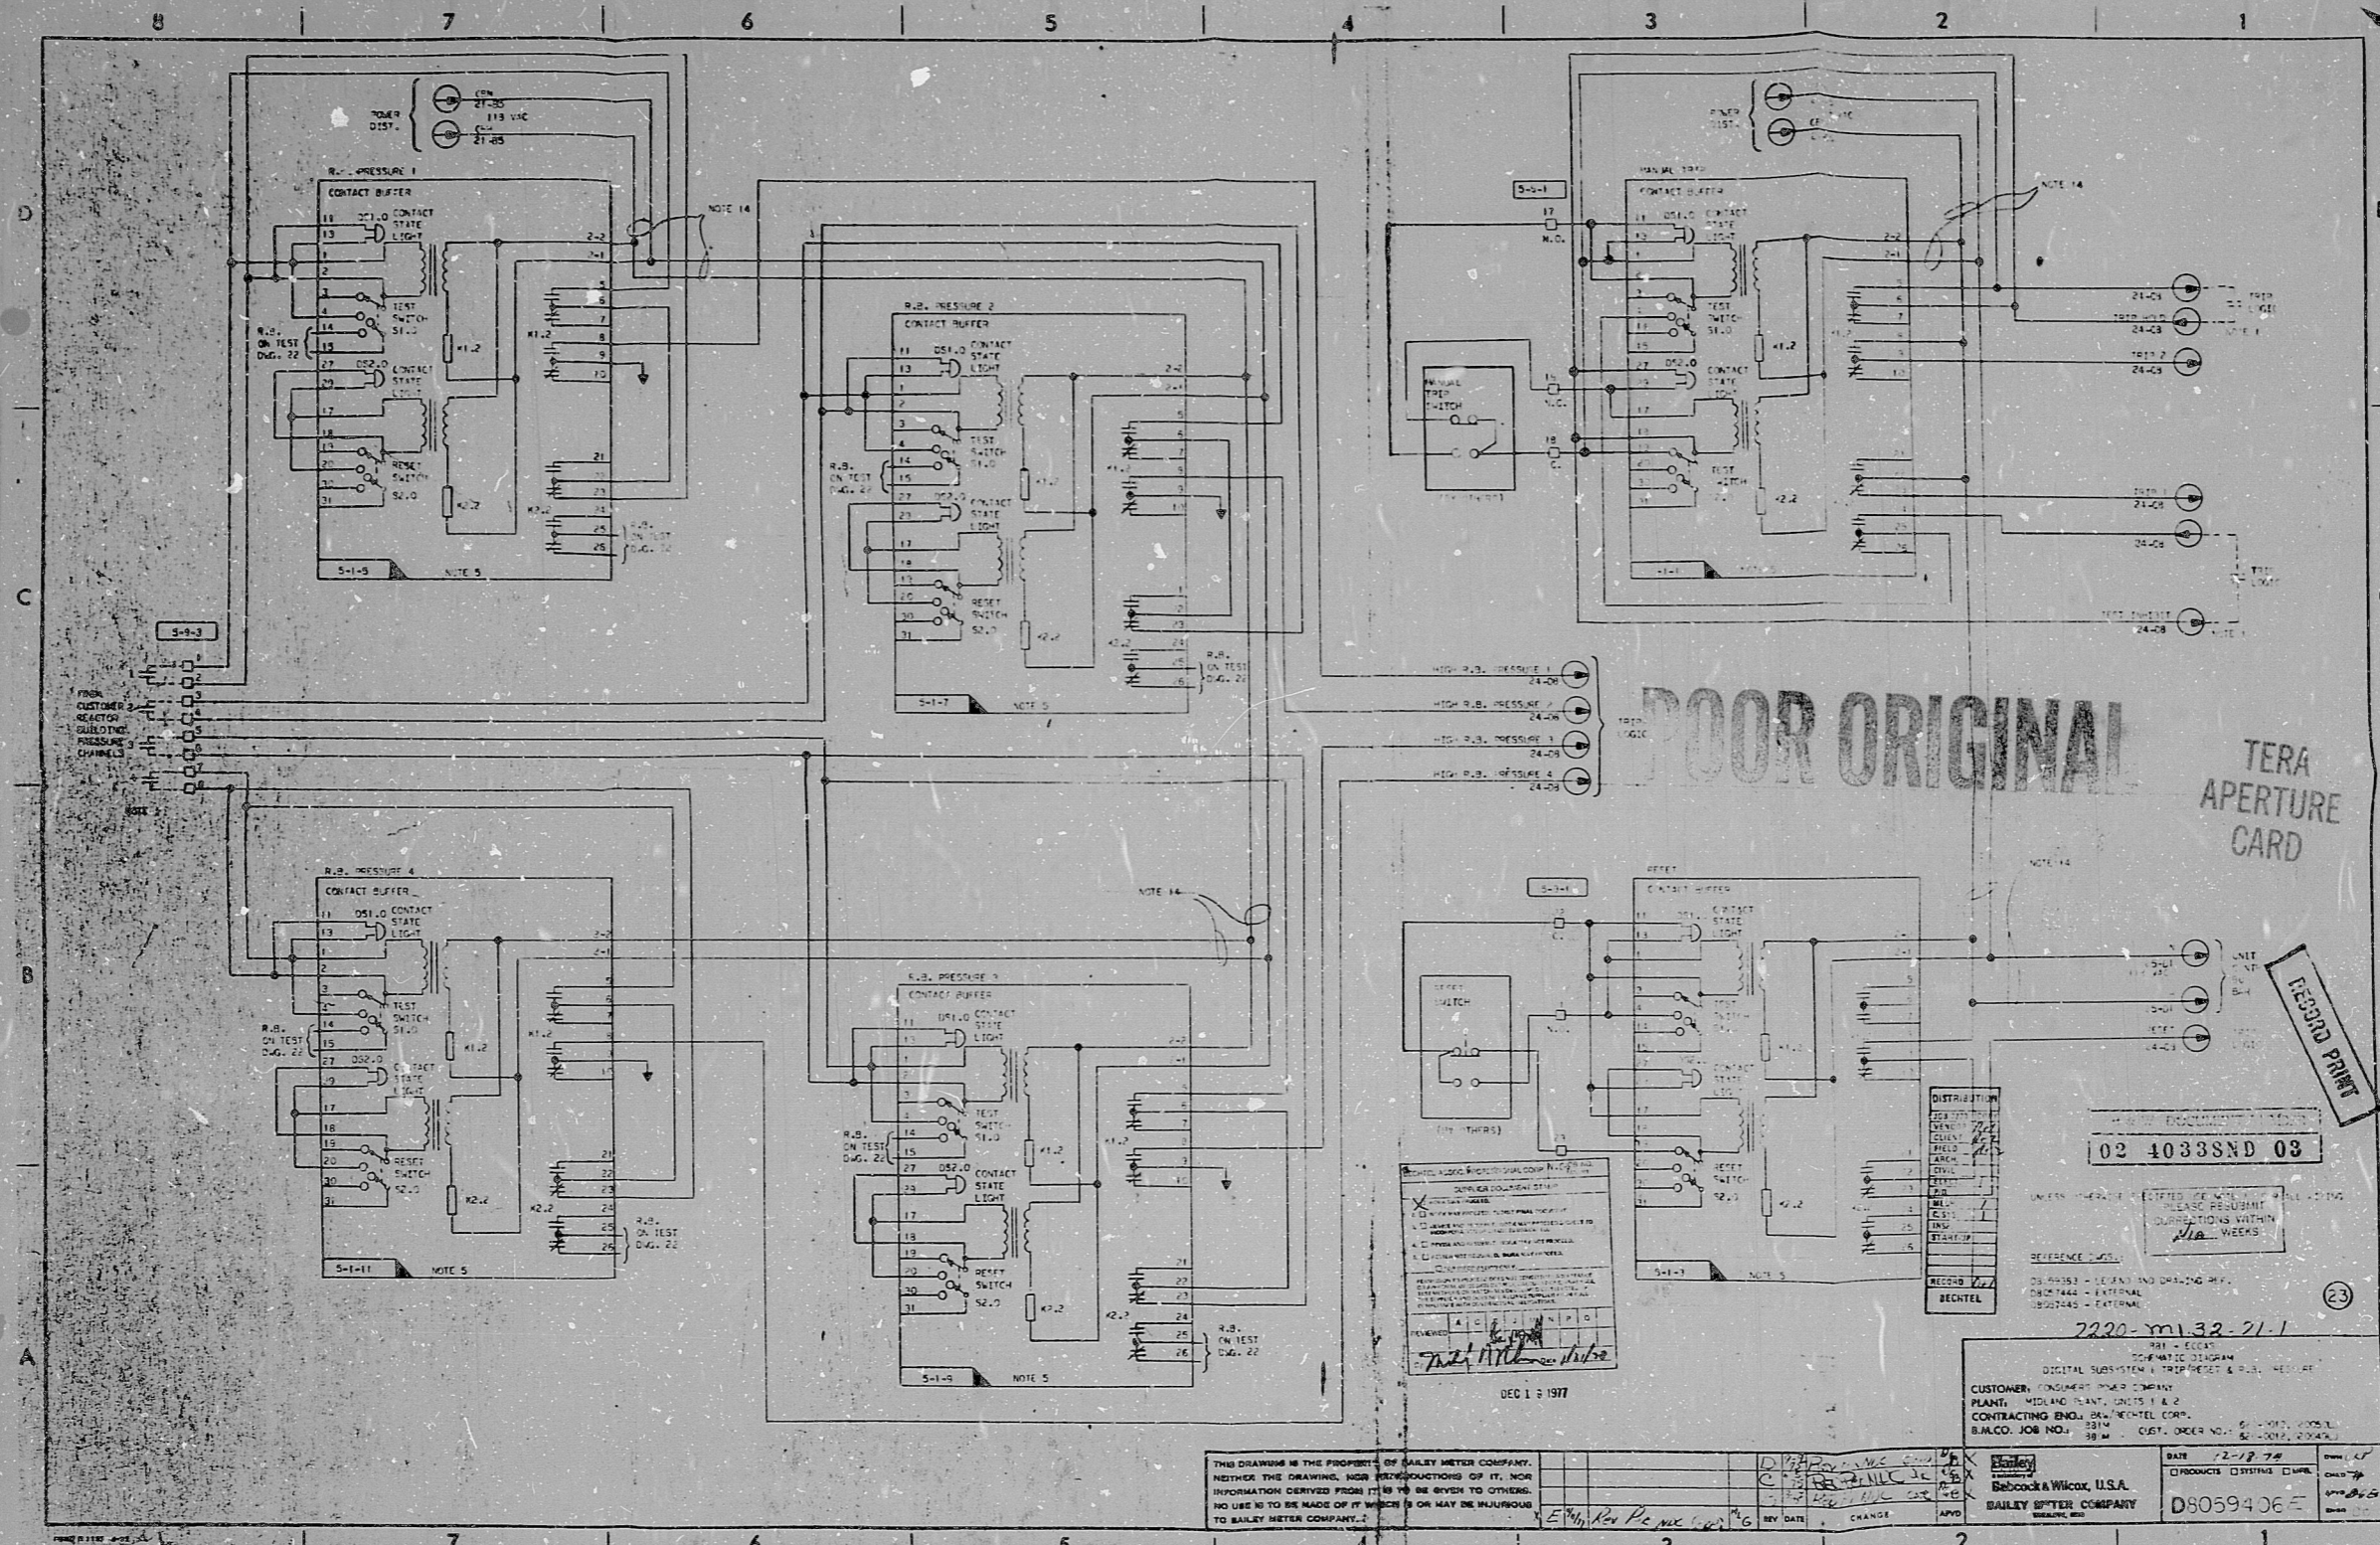

THIS DRAWING IS THE PROPERTY OF BAILEY METER COMPANY. NEITHER THE DRAWING, NOR REPRODUCTIONS OF IT, NOR INFORMATION DERIVED FROM IT IS TO BE GIVEN TO OTHERS. NO USE IS TO BE MADE OF IT WHICH IS OR MAY BE INJURIOUS TO BAILEY METER COMPANY.

DEC 1 3 1977
 E. W. Rev. P. C. Rev. 1/6
 BY DATE CHANGE APO

RECORD PRINT

02 40338ND 03

UNLESS OTHERWISE SPECIFIED BY NOTE, ALL DIMENSIONS ARE IN INCHES UNLESS OTHERWISE SPECIFIED.

REFERENCE: 7220-ml-32-21-1

DATE: 7-2-78

PROJECT: DIGITAL SUBSYSTEM & TRIPRESET & R.B. PRESSURE


PLANT: MIDLAND PLANT, UNITS 1 & 2

CONTRACTING ENG.: BAILEY METER COMPANY

BAILOCO JOB NO.: 3914 CUST. ORDER NO.: 61-1001-0000

BAILEY METER COMPANY
 8059406

BIDS

811130185

