


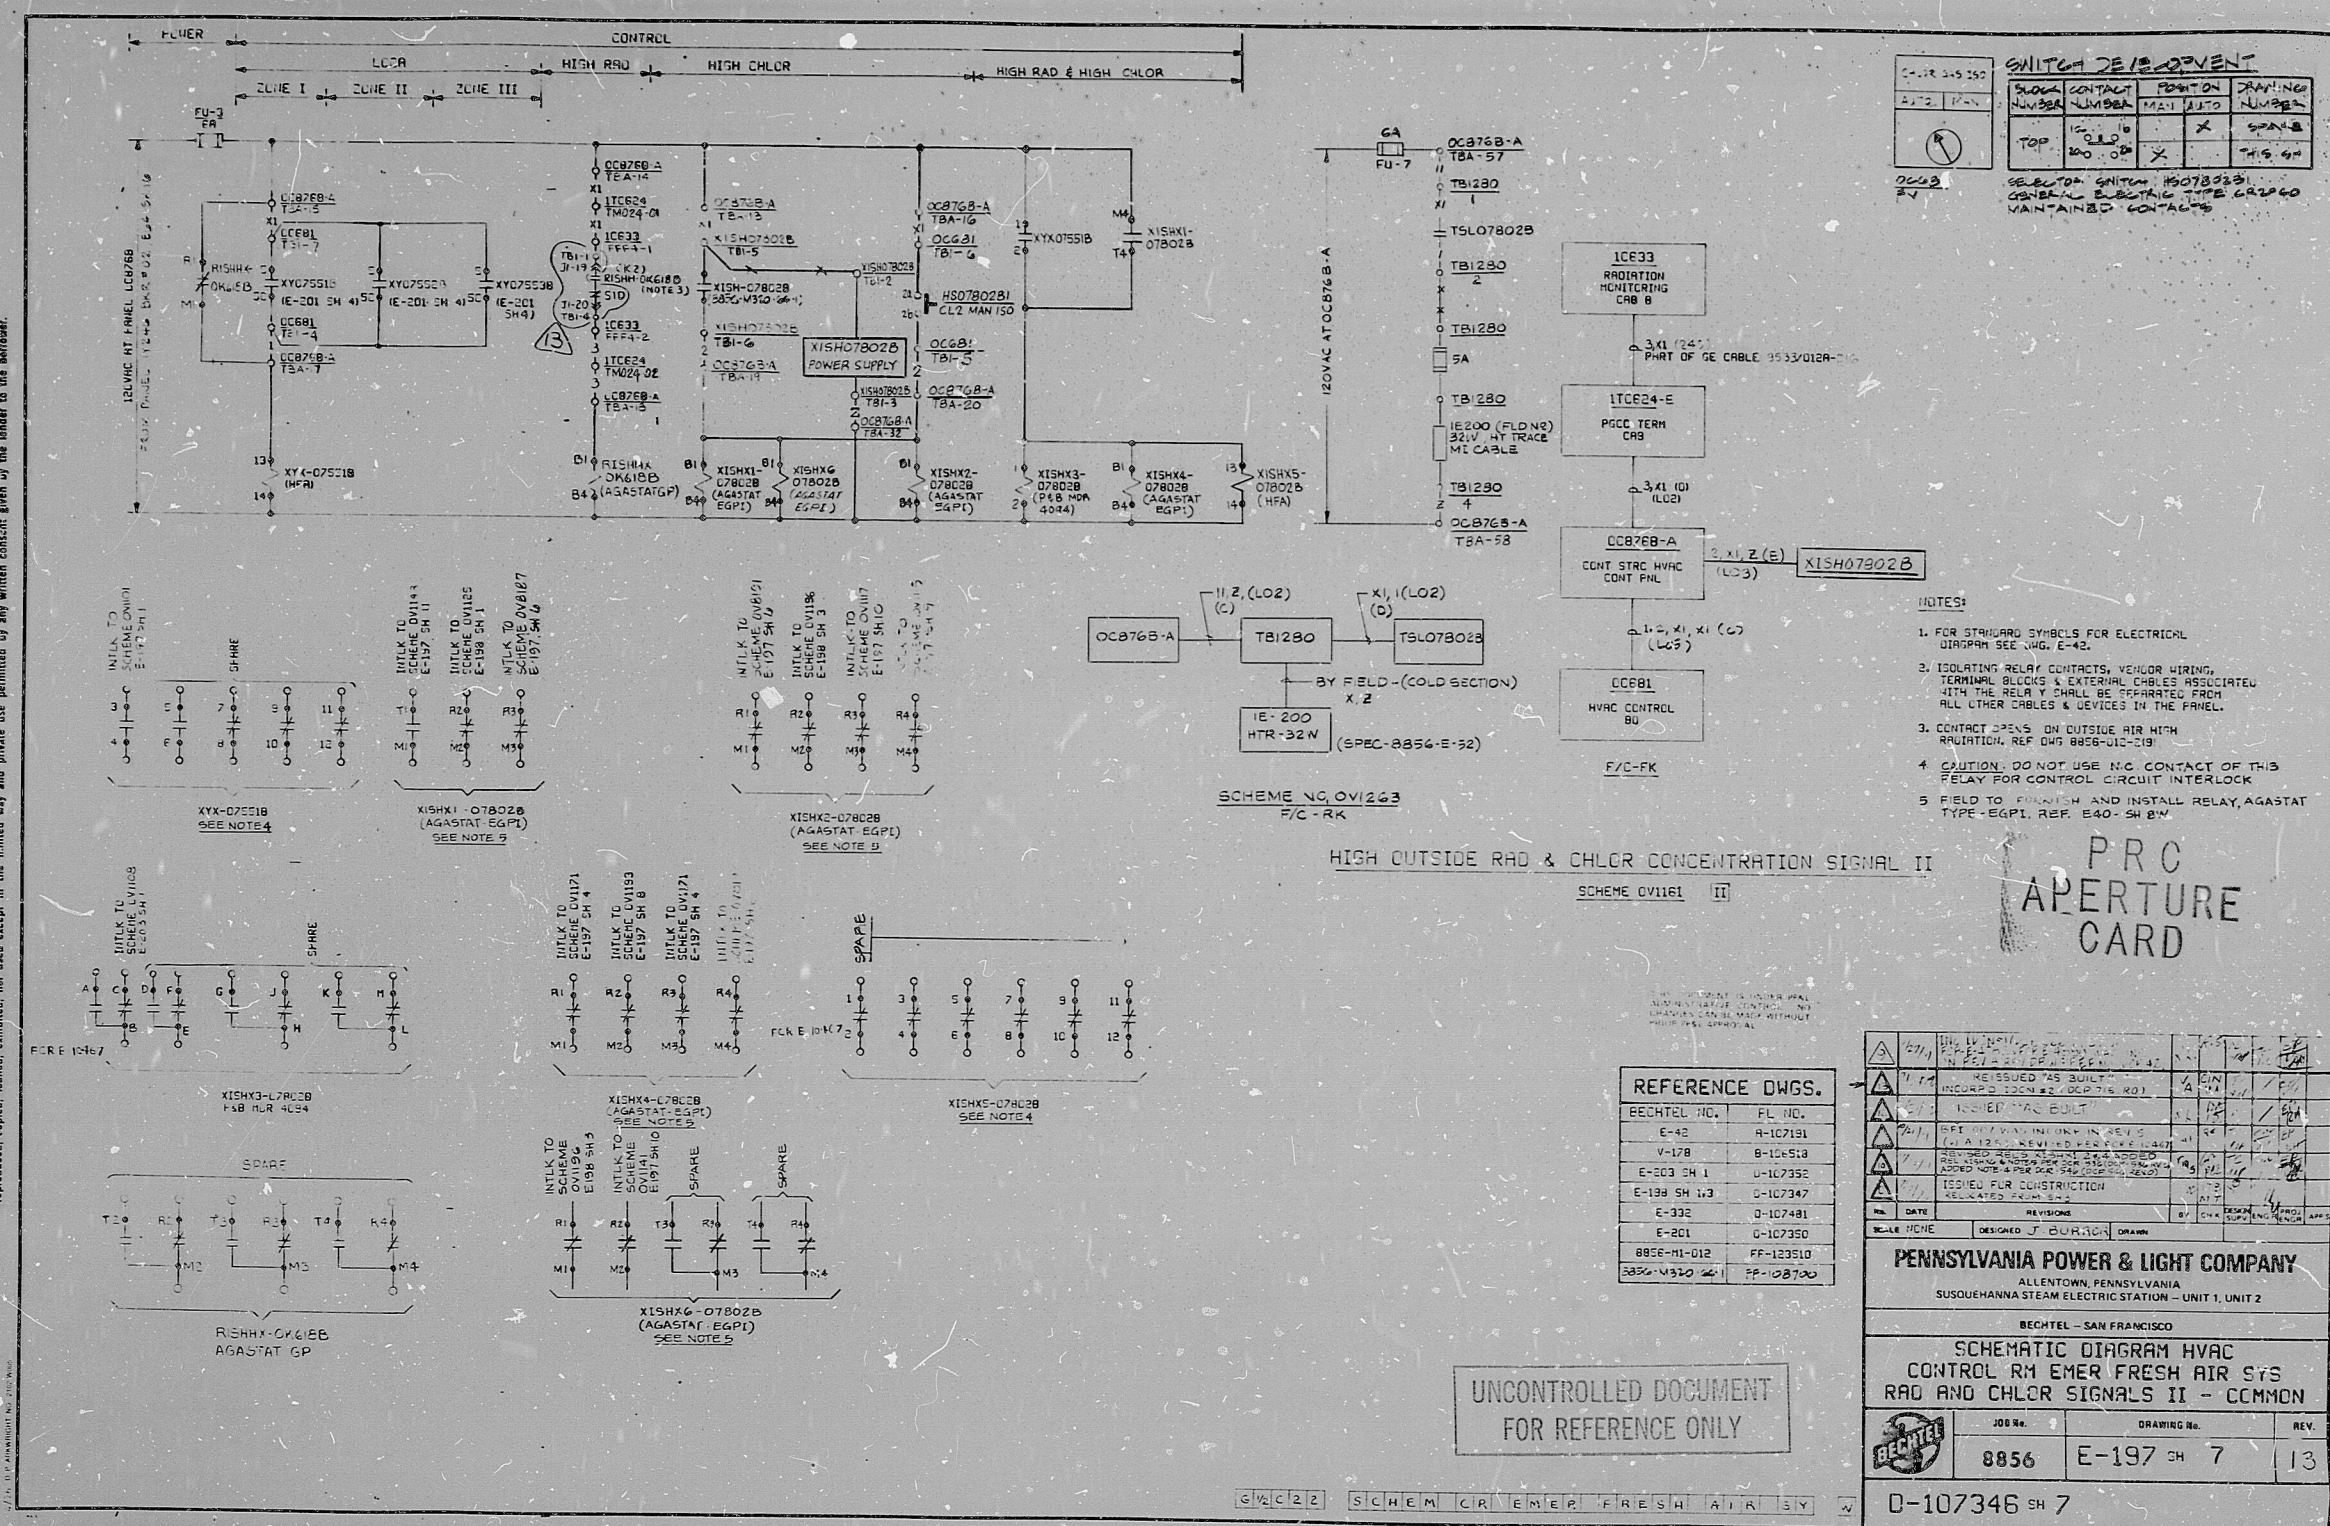

UNCONTROLLED DOCUMENT
FOR REFERENCE ONLY

G	1/2	C	2	2	S	C	H	E	M	C	R	E	N	E	R	F	R	E	S	H	A	I	R	S	Y
---	-----	---	---	---	---	---	---	---	---	---	---	---	---	---	---	---	---	---	---	---	---	---	---	---	---

PENNSYLVANIA POWER & LIGHT COMPANY

ALLENTOWN, PENNSYLVANIA
SUSQUEHANNA STEAM ELECTRIC STATION - UNIT 1, UNIT 2

RECHTEL - SAN FRANCISCO

SCHEMATIC DIAGRAM HVAC

CONTROL RM EMER FRESH AIR SYS

RAD AND CHLOR SIGNALS II - COMMON

	JOB No.	DRAWING No.	P
---	---------	-------------	---

8856	E-197 CH 7
------	------------

8836	L 157	31	1
------	-------	----	---

D-107346 SH 7

8304010022

