


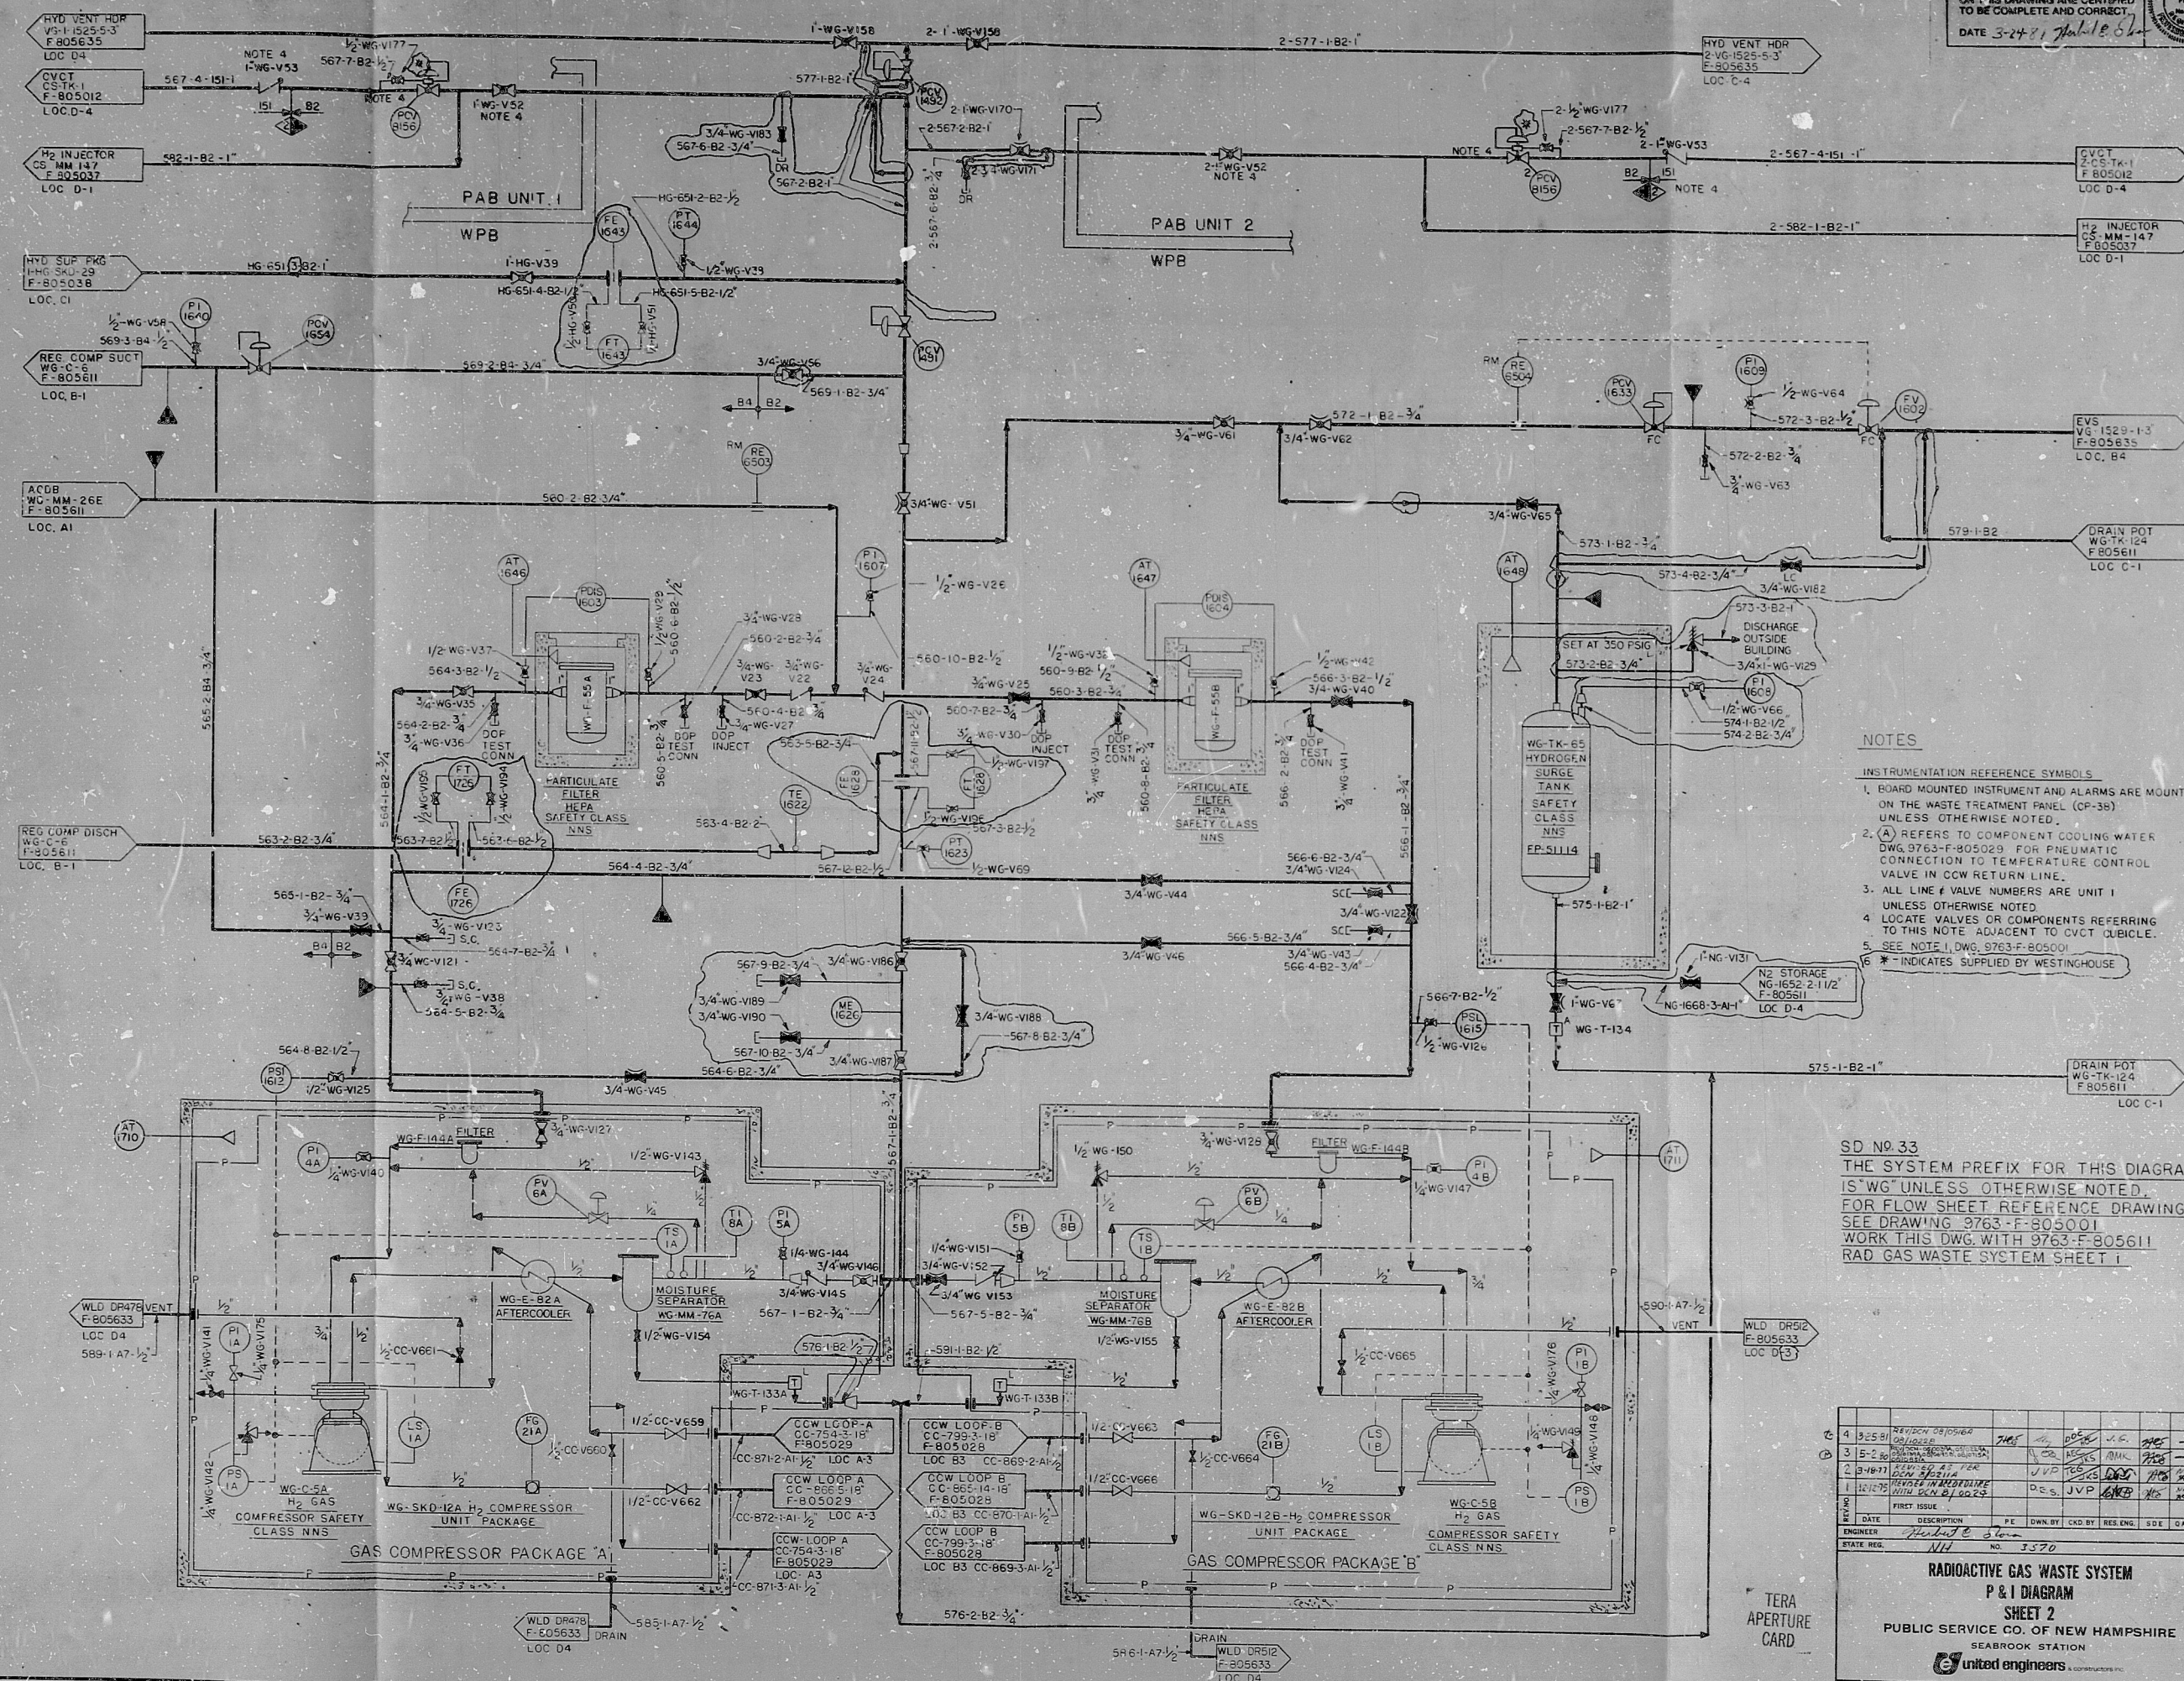

PDR

811180236

