


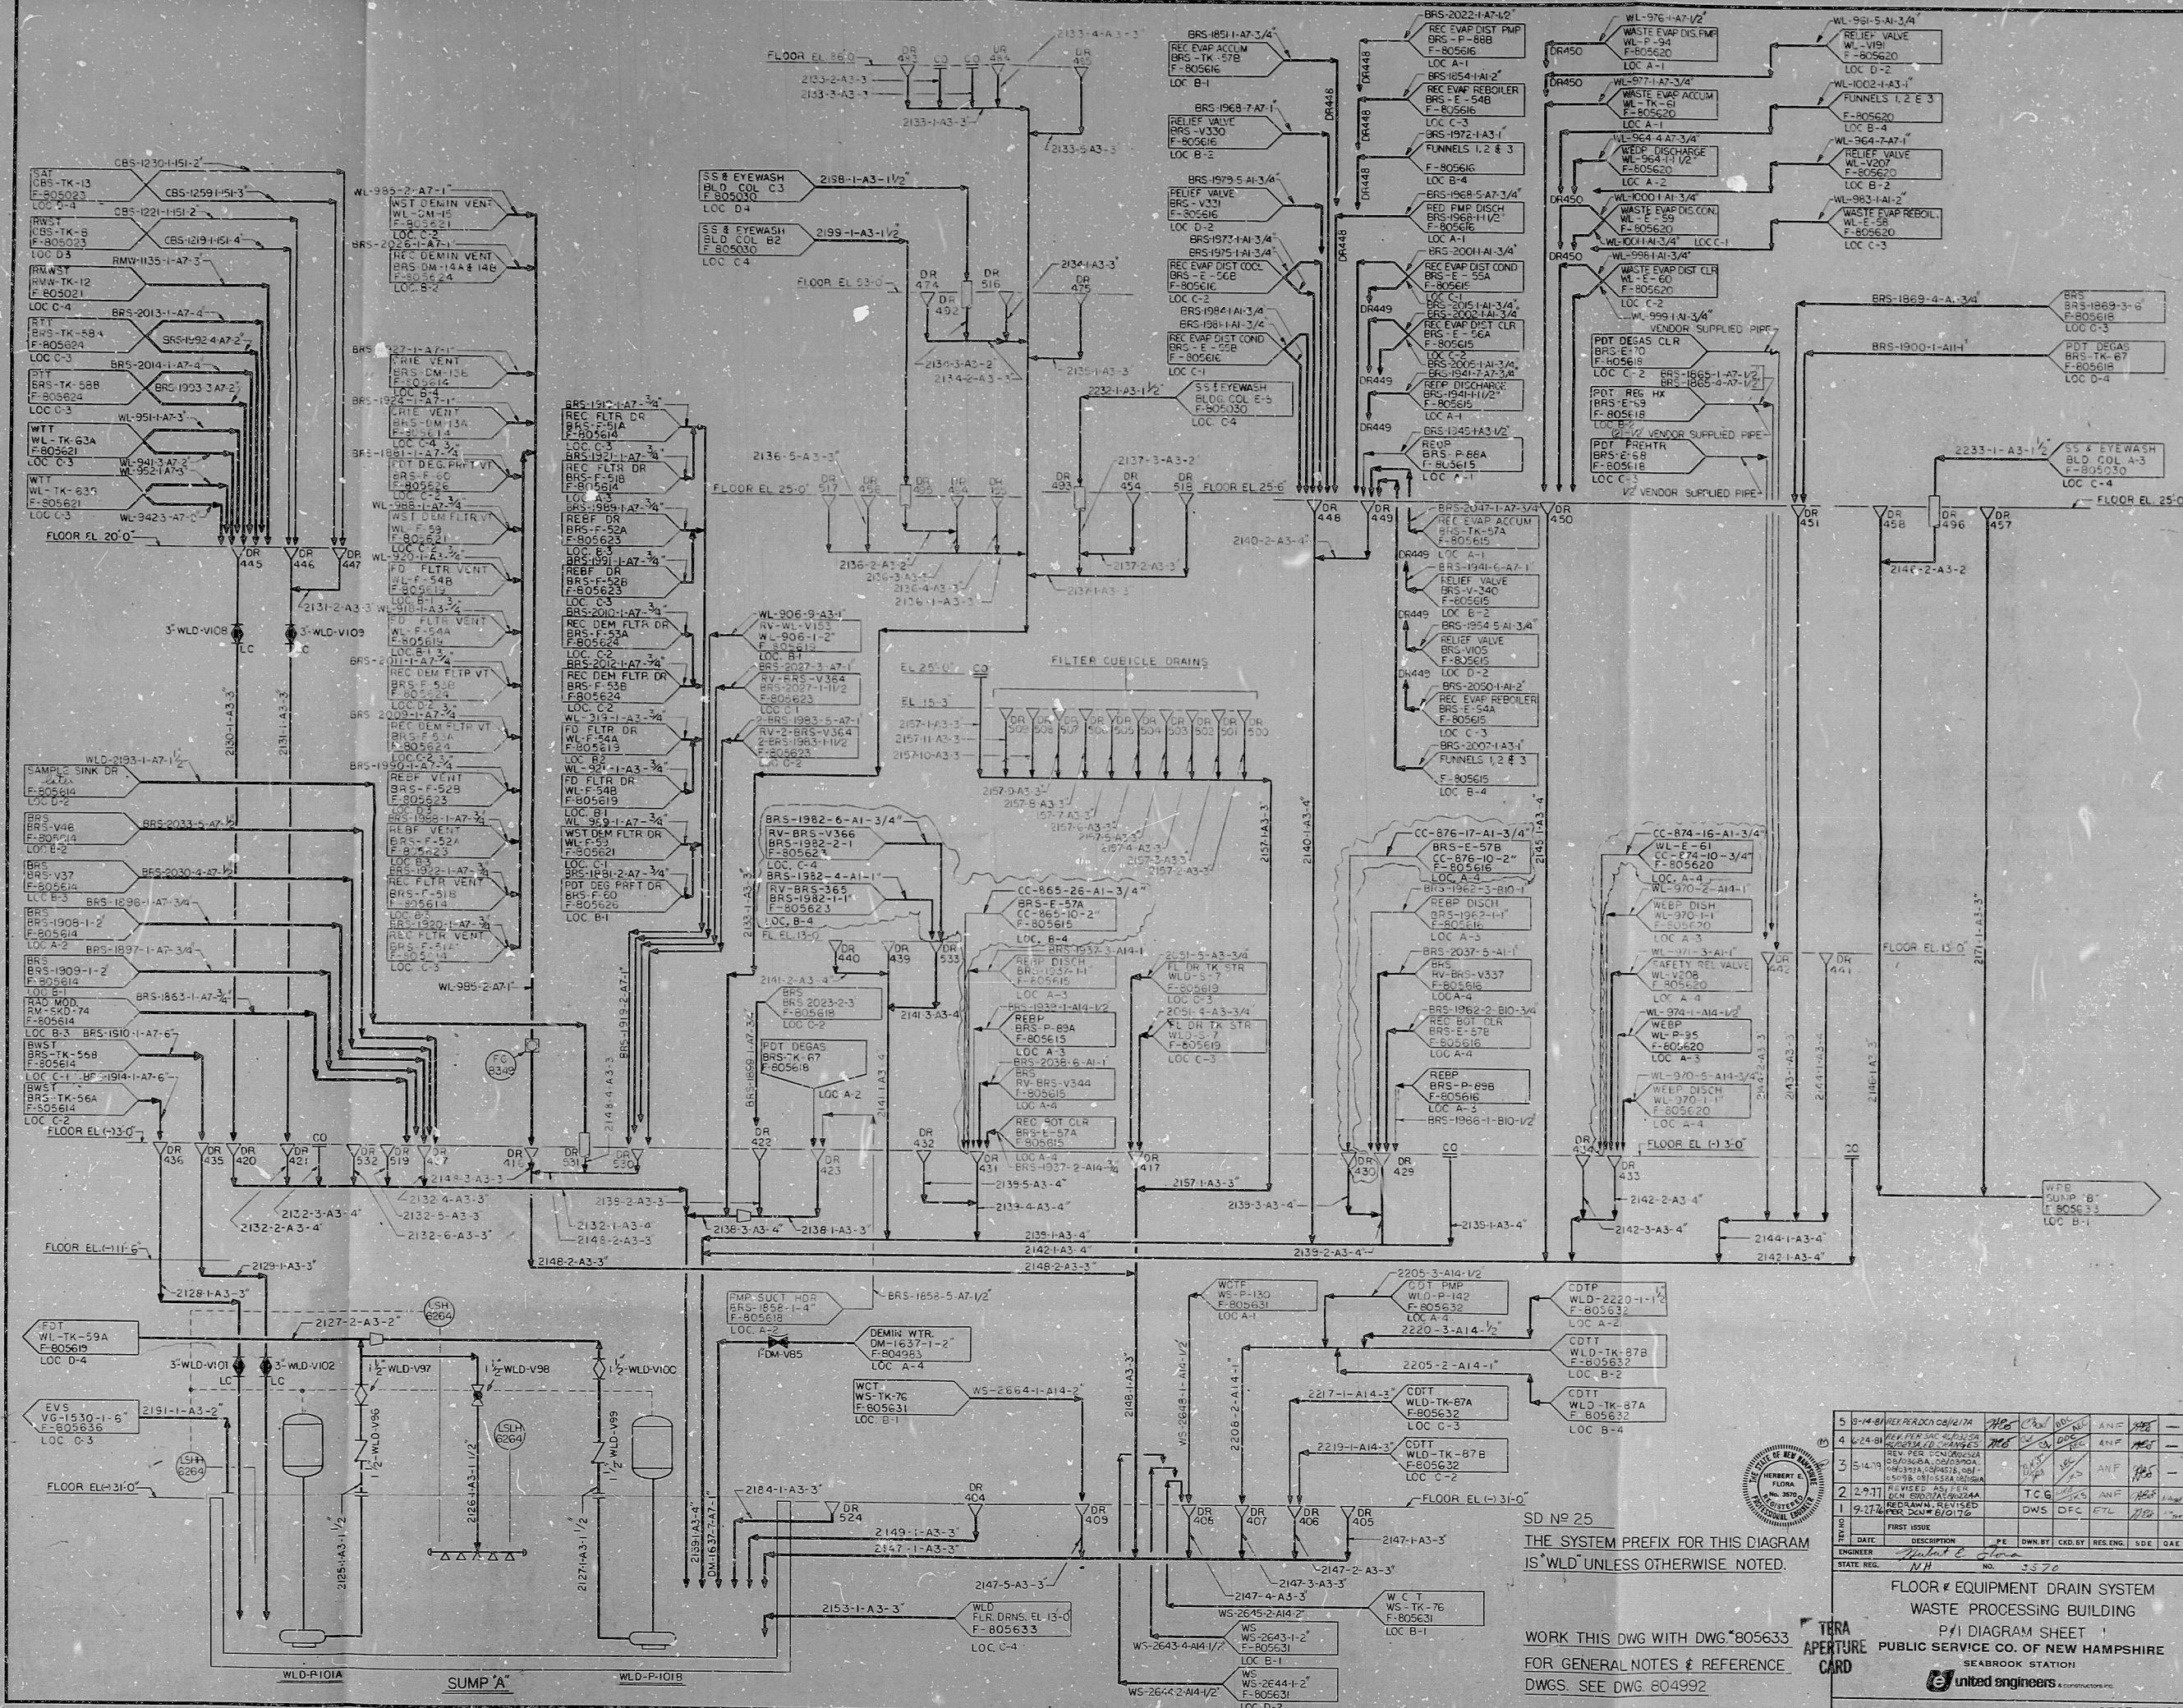

SD N° 25
THE SYSTEM PREFIX FOR THIS DIAGRAM
IS "WLD" UNLESS OTHERWISE NOTED.

WORK THIS DWG WITH DWG. 805633
FOR GENERAL NOTES & REFERENCE
DWGS. SEE DWG. 804992

NO.	DATE	DESCRIPTION	BY	CHKD	APP'D	REV.

FLOOR & EQUIPMENT DRAIN SYSTEM
WASTE PROCESSING BUILDING
P1 DIAGRAM SHEET
PUBLIC SERVICE CO. OF NEW HAMPSHIRE
SEABROOK STATION
United Engineers & Constructors, Inc.
9763-F-805617

PDR

8111180269

