

DETAIL 'A'  
NOTE 34


FLOW RESTRICTION FOR  
SAFETY CLASS 1 TO 2  
TRANSITION TYPICAL  
FLOW RESTRICTOR.



DETAIL 'B'  



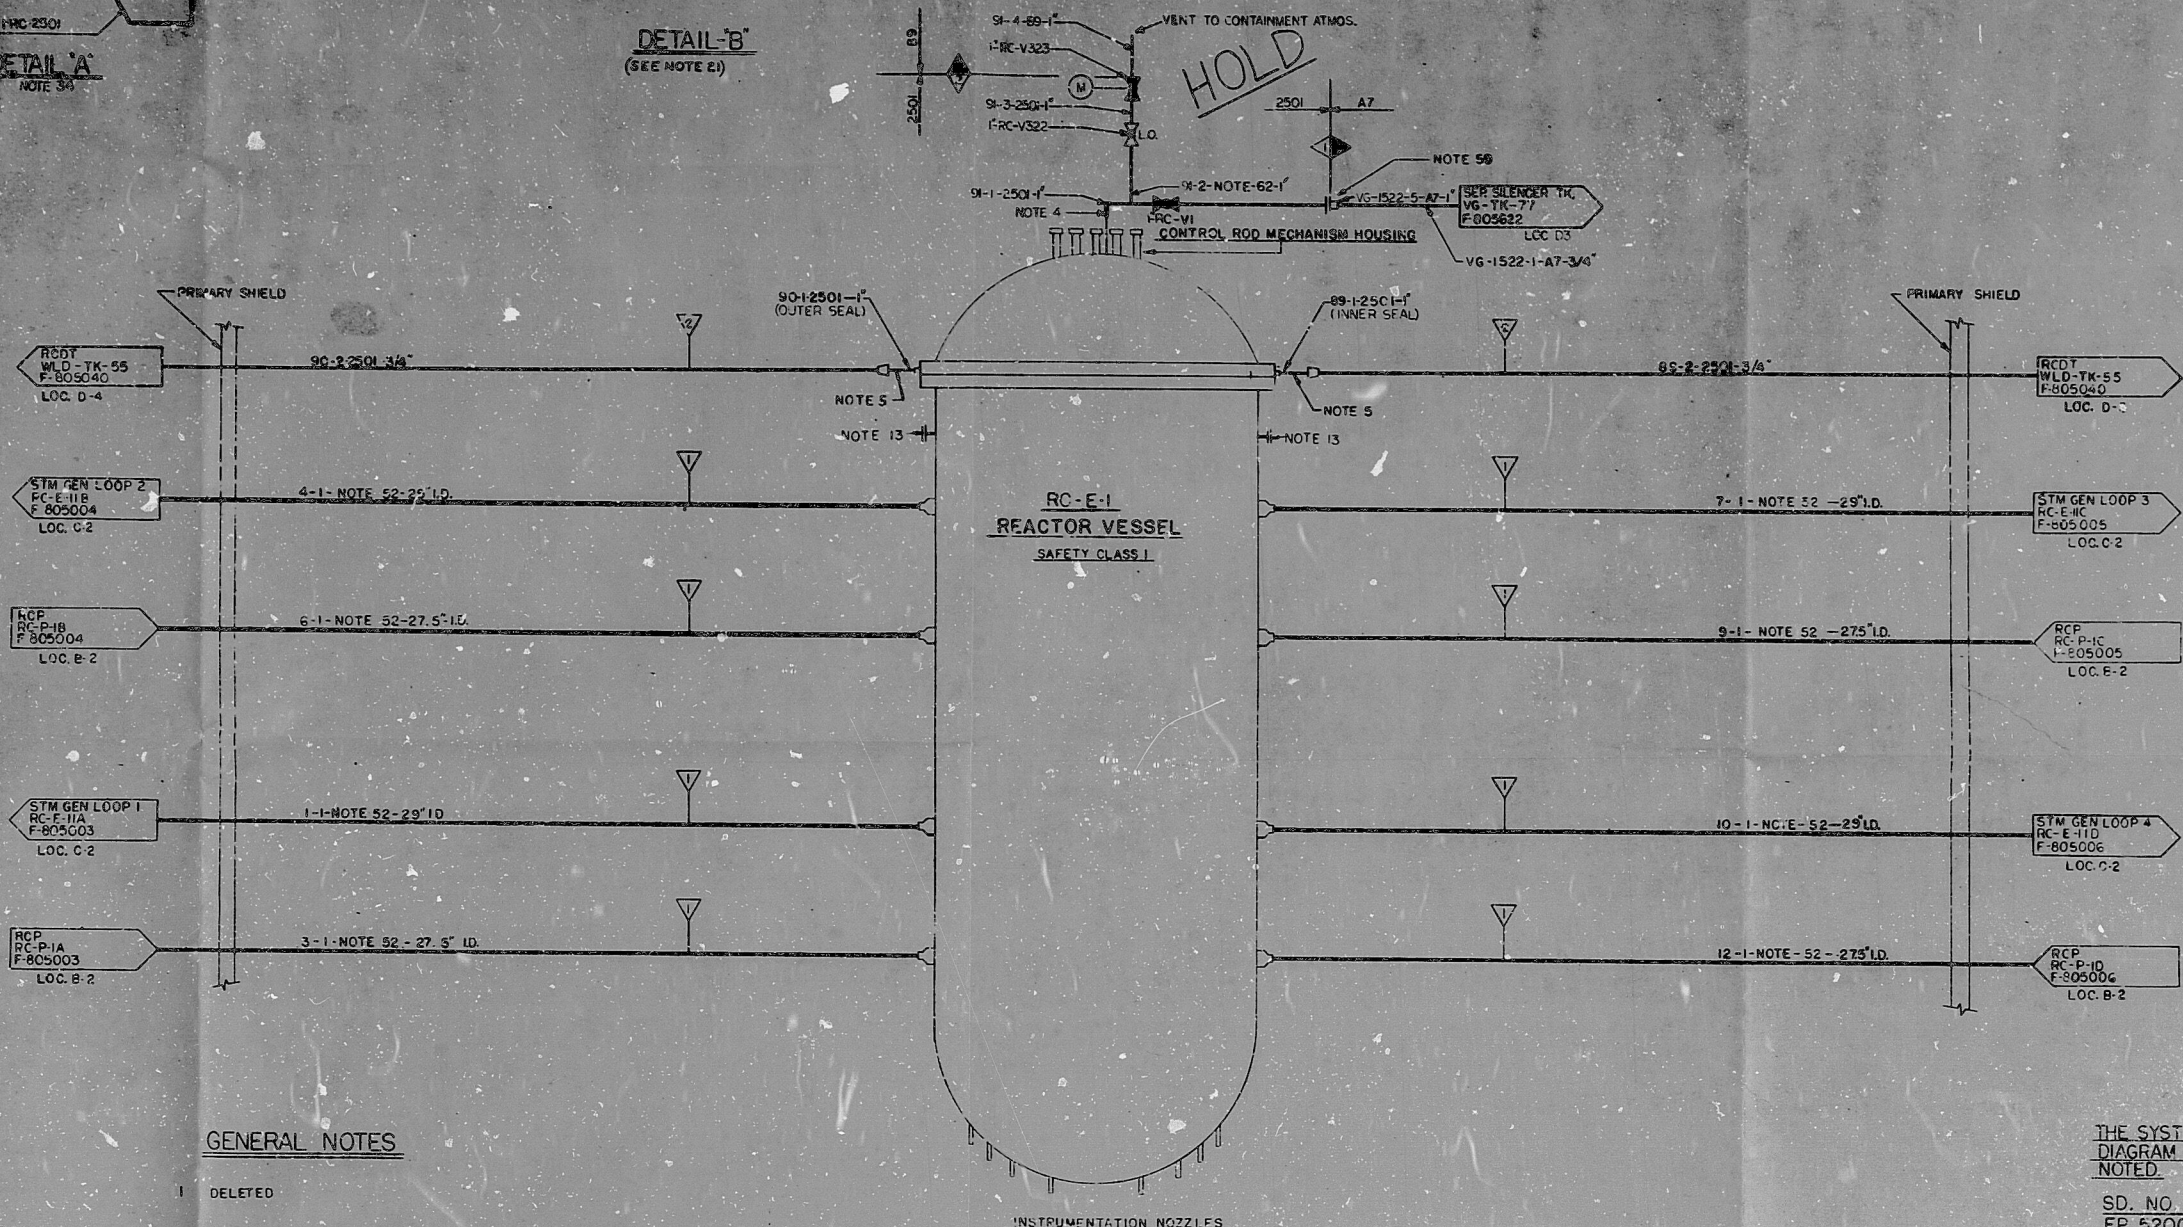

GENERAL NOTES

- 1- DELETED
- 2- SPRAY LINE SCOOP
- 3- ELBOW FLOW METER
- 4- VENT PIPE FURNISHED WITH REACTOR VESSEL HEAD
- 5- HEAD GASKET MONITORING CONNECTIONS FURNISHED WITH REACTOR VESSEL
- 6- RTD INSTALLED IN WELL
- 7- LOCATE CONNECTION IN BOTTOM HALF OF REACTOR COOLANT PIPING ON 45° ANGLE TO VERTICAL
- 8- DELETED
- 9- PLACE AS CLOSE AS POSSIBLE TO REACTOR VESSEL NOZZLE
- 10- LOCATE BELOW LEVEL OF REACTOR VESSEL FLANGE
- 11- VENT HOLE PROVIDED
- 12- SLOPE SPRAY PIPE DOWNWARD TO PROVIDE WATER SEAL BETWEEN PRESSURIZER AND SPRAY VALVES
- 13- FLANGED DOWN FOR HYDROTEST
- 14- PLACE DETECTORS AT BOTTOM OF PIPE SURFACE MOUNT
- 15- SLOPE PIPE DOWNWARD TO PROVIDE WATER SEAL BETWEEN PRESSURIZER AND RELIEF VALVES
- 16- LOCATE APPROXIMATELY MIDWAY BETWEEN LOOP AND PRESSURIZER
- 17- AGE TO FURNISH 600 LB ASA FLANGES. FLANGE END ON A7
- 18- LOCATE AS CLOSE AS POSSIBLE TO PRESSURIZER RELIEF TANK
- 19- DELETED
- 20- DRAIN LINES TO BE SLOPED DOWN FROM LOOP SEALS TO CONNECT WITH FRT HEADER LINE
- 21- SEE DETAIL 'B' THIS DWG.
- 22- DELETED
- 23- HOT LEG BY PASS LINE SCOOPS WHERE APPLICABLE ROTATE CONNECTIONS 90° TO PREVENT ALIGNMENT WITH SURGE LINE CONNECTION
- 24- RTD MANIFOLD PIPE AND RTD'S SUPPLIED AS A PACKAGE MANIFOLD APPROX 20" LONG
- 25- LOCATE RTD MANIFOLD ISOLATION VALVES AS CLOSE AS PRACTICABLE TO THE MANIFOLD
- 26- LOCATE CONNECTION ON UPPER 180° OF PIPE CIRCUMFERENCE
- 27- ALL BYPASS LOOP PIPING AND THE RTD MANIFOLD SHALL HAVE REMOVABLE INSULATION
- 28- LOCATE ROOT VALVE ABOVE ELEVATION OF REACTOR VESSEL NOZZLE
- 29- LENGTH OF HOT LEG 2" PIPE UPSTREAM OF RTD MANIFOLD (A) TO (B) TO BE AS SHORT AS POSSIBLE
- 30- LENGTH OF COLD LEG 2" PIPE UPSTREAM OF RTD MANIFOLD (C) TO (D) TO BE AS SHORT AS POSSIBLE
- 31- FLANGE IS INSTALLED FOR INSERTION OF FLOW LIMITING ORIFICE A/E WILL FURNISH BLANK ORIFICE
- 32- RTD MANIFOLD LOOP PIPING SHOULD HAVE ENOUGH FLEXIBILITY TO COOL DOWN TO 70°F WITH THE REACTOR COOLANT PIPING AT 520°F
- 33- TEMPORARY READOUT FOR SELECTED PUMP MONITORING CONNECT TO VIB. TRANS. AS REQUIRED
- 34- PARALLEL PIPE PATHS SHOULD BE OF APPROXIMATE EQUIVALENT LENGTHS WITH FLOW PATHS NOT EXCEEDING 60' PENETRATIONS SHOULD BE IN THE SAME VERTICAL PLANE
- 35- VALVE INTERLOCKED WITH REACTOR COOLANT PRESSURE
- 36- CONDENSATE TEE AND BELLOW CHAMBER SEE ① I & C 3TD SECT 30 PAGES 22 & 23
- 40- \* INDICATES VALVE SUPPLIED BY WESTINGHOUSE
- 41- BRANCH CONNS TO THE COMMON RELIEF HEADER ARE TO BE IN ACCORDANCE WITH ① STR 1.21
- 42- LOCATE CHECK VALVES CLOSE TO RC PUMP
- 43- LOCATE CHECK VALVE CLOSE TO CONTAINMENT
- 44- LOCK OPEN AT MOTOR CONTROL CENTER
- 45- SPOOL PIECE WITH BLIND FLANGE EXCEPT DURING DRAINING OF CROSSOVER LEG
- 46- BOTTOM OF STANDPIPE TO BE 22±0.5 FT ABOVE CONN TO 3 SEAL
- 47- RCP NEW LINE NOS. TO AND FROM RC PUMPS SEE DWG. F-805008 FOR LOOP B & F-805029 FOR LOOP A
- 48- TOP OF LOOP TO RISE 6" ABOVE 2 SEAL LEA-OFF DOWN SLOPE PIPING DOWNWARD THRU RUN TO RCPT. LOCATE CHECK VALVE AT LEVEL OF RCPT.
- 49- FOR TCS & TV'S PROVIDE 3/8 SWAGelok FITTING. LOCATE TCS OR TV'S ON BOTTOM OF PIPE TO FACILITATE DRAINING (TYP. FOR LOOPS 1,2,3 & 4)
- 50- SPOOL PIECE TO BE INSTALLED ONLY DURING DRAINING OF STEAM GEN. CHANNEL HEAD

REFERENCE DRAWINGS  
9763-F-805003-RC SYS - LOOP 1  
805004 - 2  
805005 - 3  
805006 - 4  
805007 - PRESSURIZER  
FP 50305 - RC SYS DIAG  
FP 50306 -  
FP 50307 -  
9763-M-506620 THRU 9763-M-506640 INSTR  
503740 THRU 503748  
506001 THRU 506009  
503101 THRU 503105  
FP 52009 INSTR  
FP 70001

THE SYSTEM PREFIX FOR THIS  
DIAGRAM IS 'RC' UNLESS OTHERWISE  
NOTED

SD. NO. NAH/MCH 281  
FP 52009 UE & C

FOR FLOW DIAGRAM REF DWGS.  
SYMBOLS & ABBREVIATIONS  
SEE DWG. 9763-F-805001

NOTE  
HOLD IN ZONE D-2

TERA  
APERTURE  
CARD


REACTOR COOLANT SYSTEM  
REACTOR VESSEL  
P & I DIAGRAM  
PUBLIC SERVICE CO. OF NEW HAMPSHIRE  
SEABROOK STATION  
UNITS 1 AND 2 9763-F-805002



PDR

8111190306

