


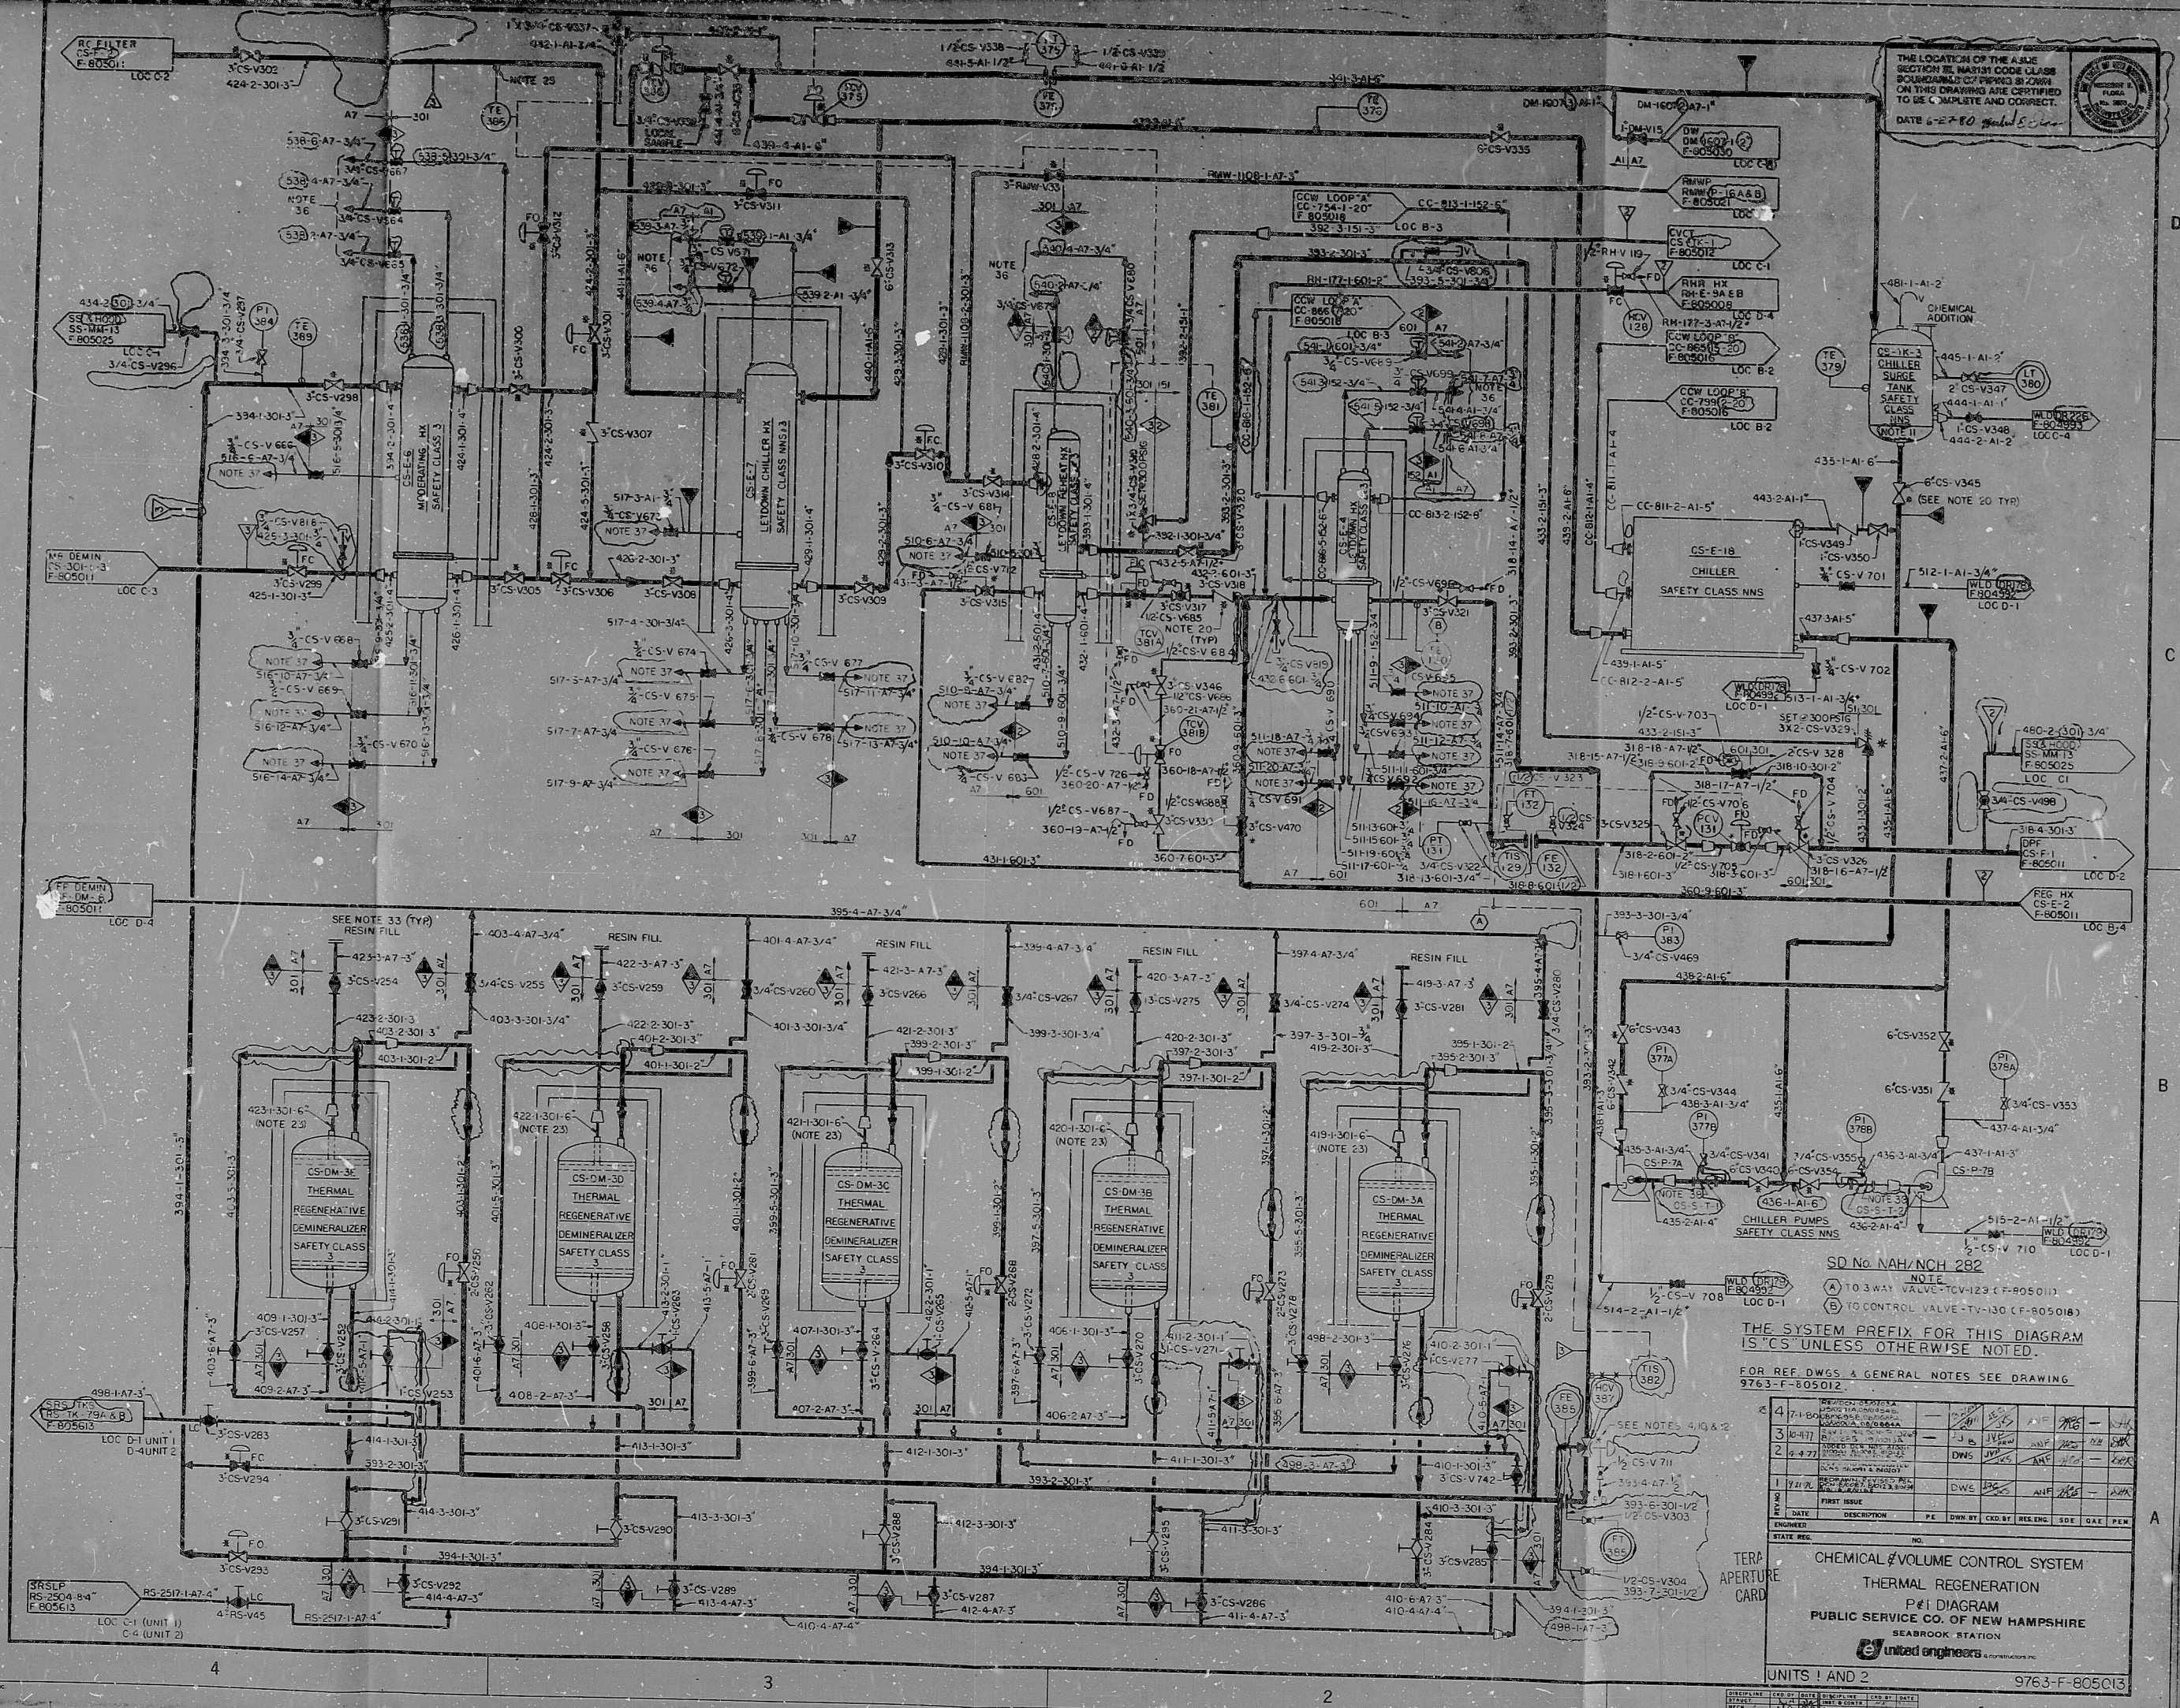

DATE 6-2-80 *Handwritten signature*

THE SYSTEM PREFIX FOR THIS DIAGRAM IS "CS" UNLESS OTHERWISE NOTED.

FOR REF. DWGS & GENERAL NOTES SEE DRAWING 9763-F-805012

REV.	DATE	DESCRIPTION	BY	CHKD.	APP.	DATE

CHEMICAL & VOLUME CONTROL SYSTEM
THERMAL REGENERATION
P&ID DIAGRAM
PUBLIC SERVICE CO. OF NEW HAMPSHIRE
SEABROOK STATION
UNIT 1 AND 2
9763-F-805013

PDR

8111190356

