


DII STANDBY AC POWER SYSTEM BYPASS/INOP STATUS LIGHTS
 SCHEME NO. 11KGA001
 (TYPICAL FOR 1 & 2 UNITS)




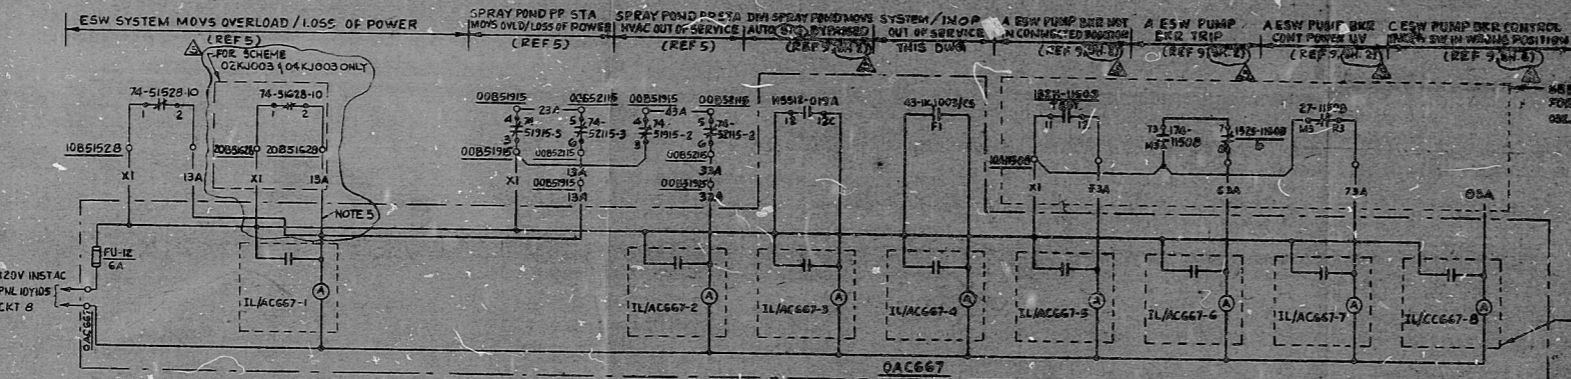


DIII ESW SYSTEM BYPASS/INOP STATUS LIGHTS
 SCHEME NO. 01KJ003




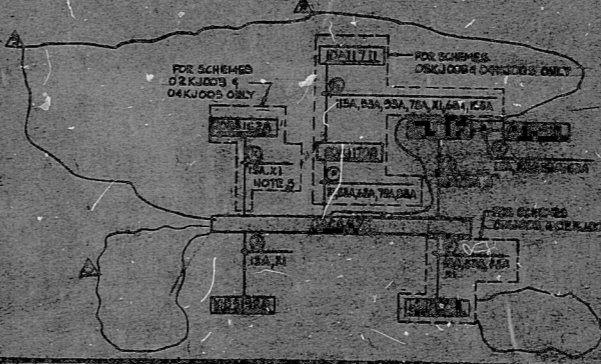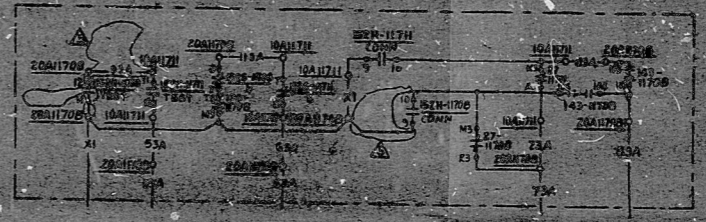

- NOTES**
- LIGHTS IL/AC661-12 & IL/DC661-12 ARE ASSOCIATED WITH THE TURBINE BUILDING EQUIPMENT COMPARTMENT EXHAUST FAN AND LIGHTS IL/CC661-12 & IL/DC661-12 ARE ASSOCIATED WITH THE CRD WATER PUMPS.
 - LIGHTS IL/AC661-13 & IL/DC661-13 AND ASSOCIATED CONTACTS ARE SUPPLIED WITH UNIT 2 ONLY. LIGHTS IL/CC661-13 & IL/DC661-13 AND ASSOCIATED DEVICES ARE SUPPLIED WITH UNIT 1 ONLY.
 - REFERENCE DRAWING 3 IS FOR SCHEMES 11KGA001, 12KGA001, 13KGA001 ONLY. SEE REF DWG 3 FOR SCHEM 14KGA001.
 - DELETED
 - DO NOT TERMINATE WIRES UNTIL UNIT 2 IN OPERATION.
 - DELETED
 - DELETED

REFERENCE DRAWINGS

- 0031-E-160 SH. 1 THRU 3 SCHEMATIC DIAGRAM SAFEGUARD BUSES-101 #201 SAFEGUARD BUS FEEDER BREAKERS, 4KV - 1 & 2 UNITS.
- 0031-E-162 SCHEMATIC DIAGRAM SAFEGUARD BUSES D144 / D244 SAFEGUARD LC XFMR BREAKERS, 4KV - 1 & 2 UNITS.
- 0031-E-163 SCHEMATIC DIAGRAM SAFEGUARD BUSES D14, D174, D134, D24, D224 & D234 SAFEGUARD L.C. TRANSFORMER BREAKERS, 4KV - 1 & 2 UNITS.
- 0031-E-164 SCHEMATIC DIAGRAM SAFEGUARD BUSES D11, D12, D13, D14, D21, D22, D23, D24 GEN BREAKERS, 4KV - 1 & 2 UNITS.
- 0031-E-649 SCHEMATIC DIAGRAM SAFEGUARD SYSTEM ANNUNCIATOR AUXILIARY RELAY CIRCUITS - 1 & 2 UNITS.
- 0031-E-653 SCHEMATIC DIAGRAM TURBINE BUILDING EQUIP COMPT EXHAUST FANS - 1 & 2 UNITS.
- 0031-E-352 SCHEMATIC DIAGRAM CONTROL ROOM DRIVE PUMPS - 1 & 2 UNITS.
- 0031-E-404 SCHEMATIC DIAGRAM DRYWELL CHILLERS - 1 & 2 UNITS.
- 0031-E-321 SCHEMATIC DIAGRAM EMERGENCY SERVICE WATER PUMPS - COMMON.

LEGEND

* DENOTE THAT UNIT 2 DEVICES AND ALARMS ARE NOT CONNECTED FOR UNIT 1 OPERATION/UNIT 2 CONSTRUCTION


PRC APERTURE CARD

RIDS

8304120263

