


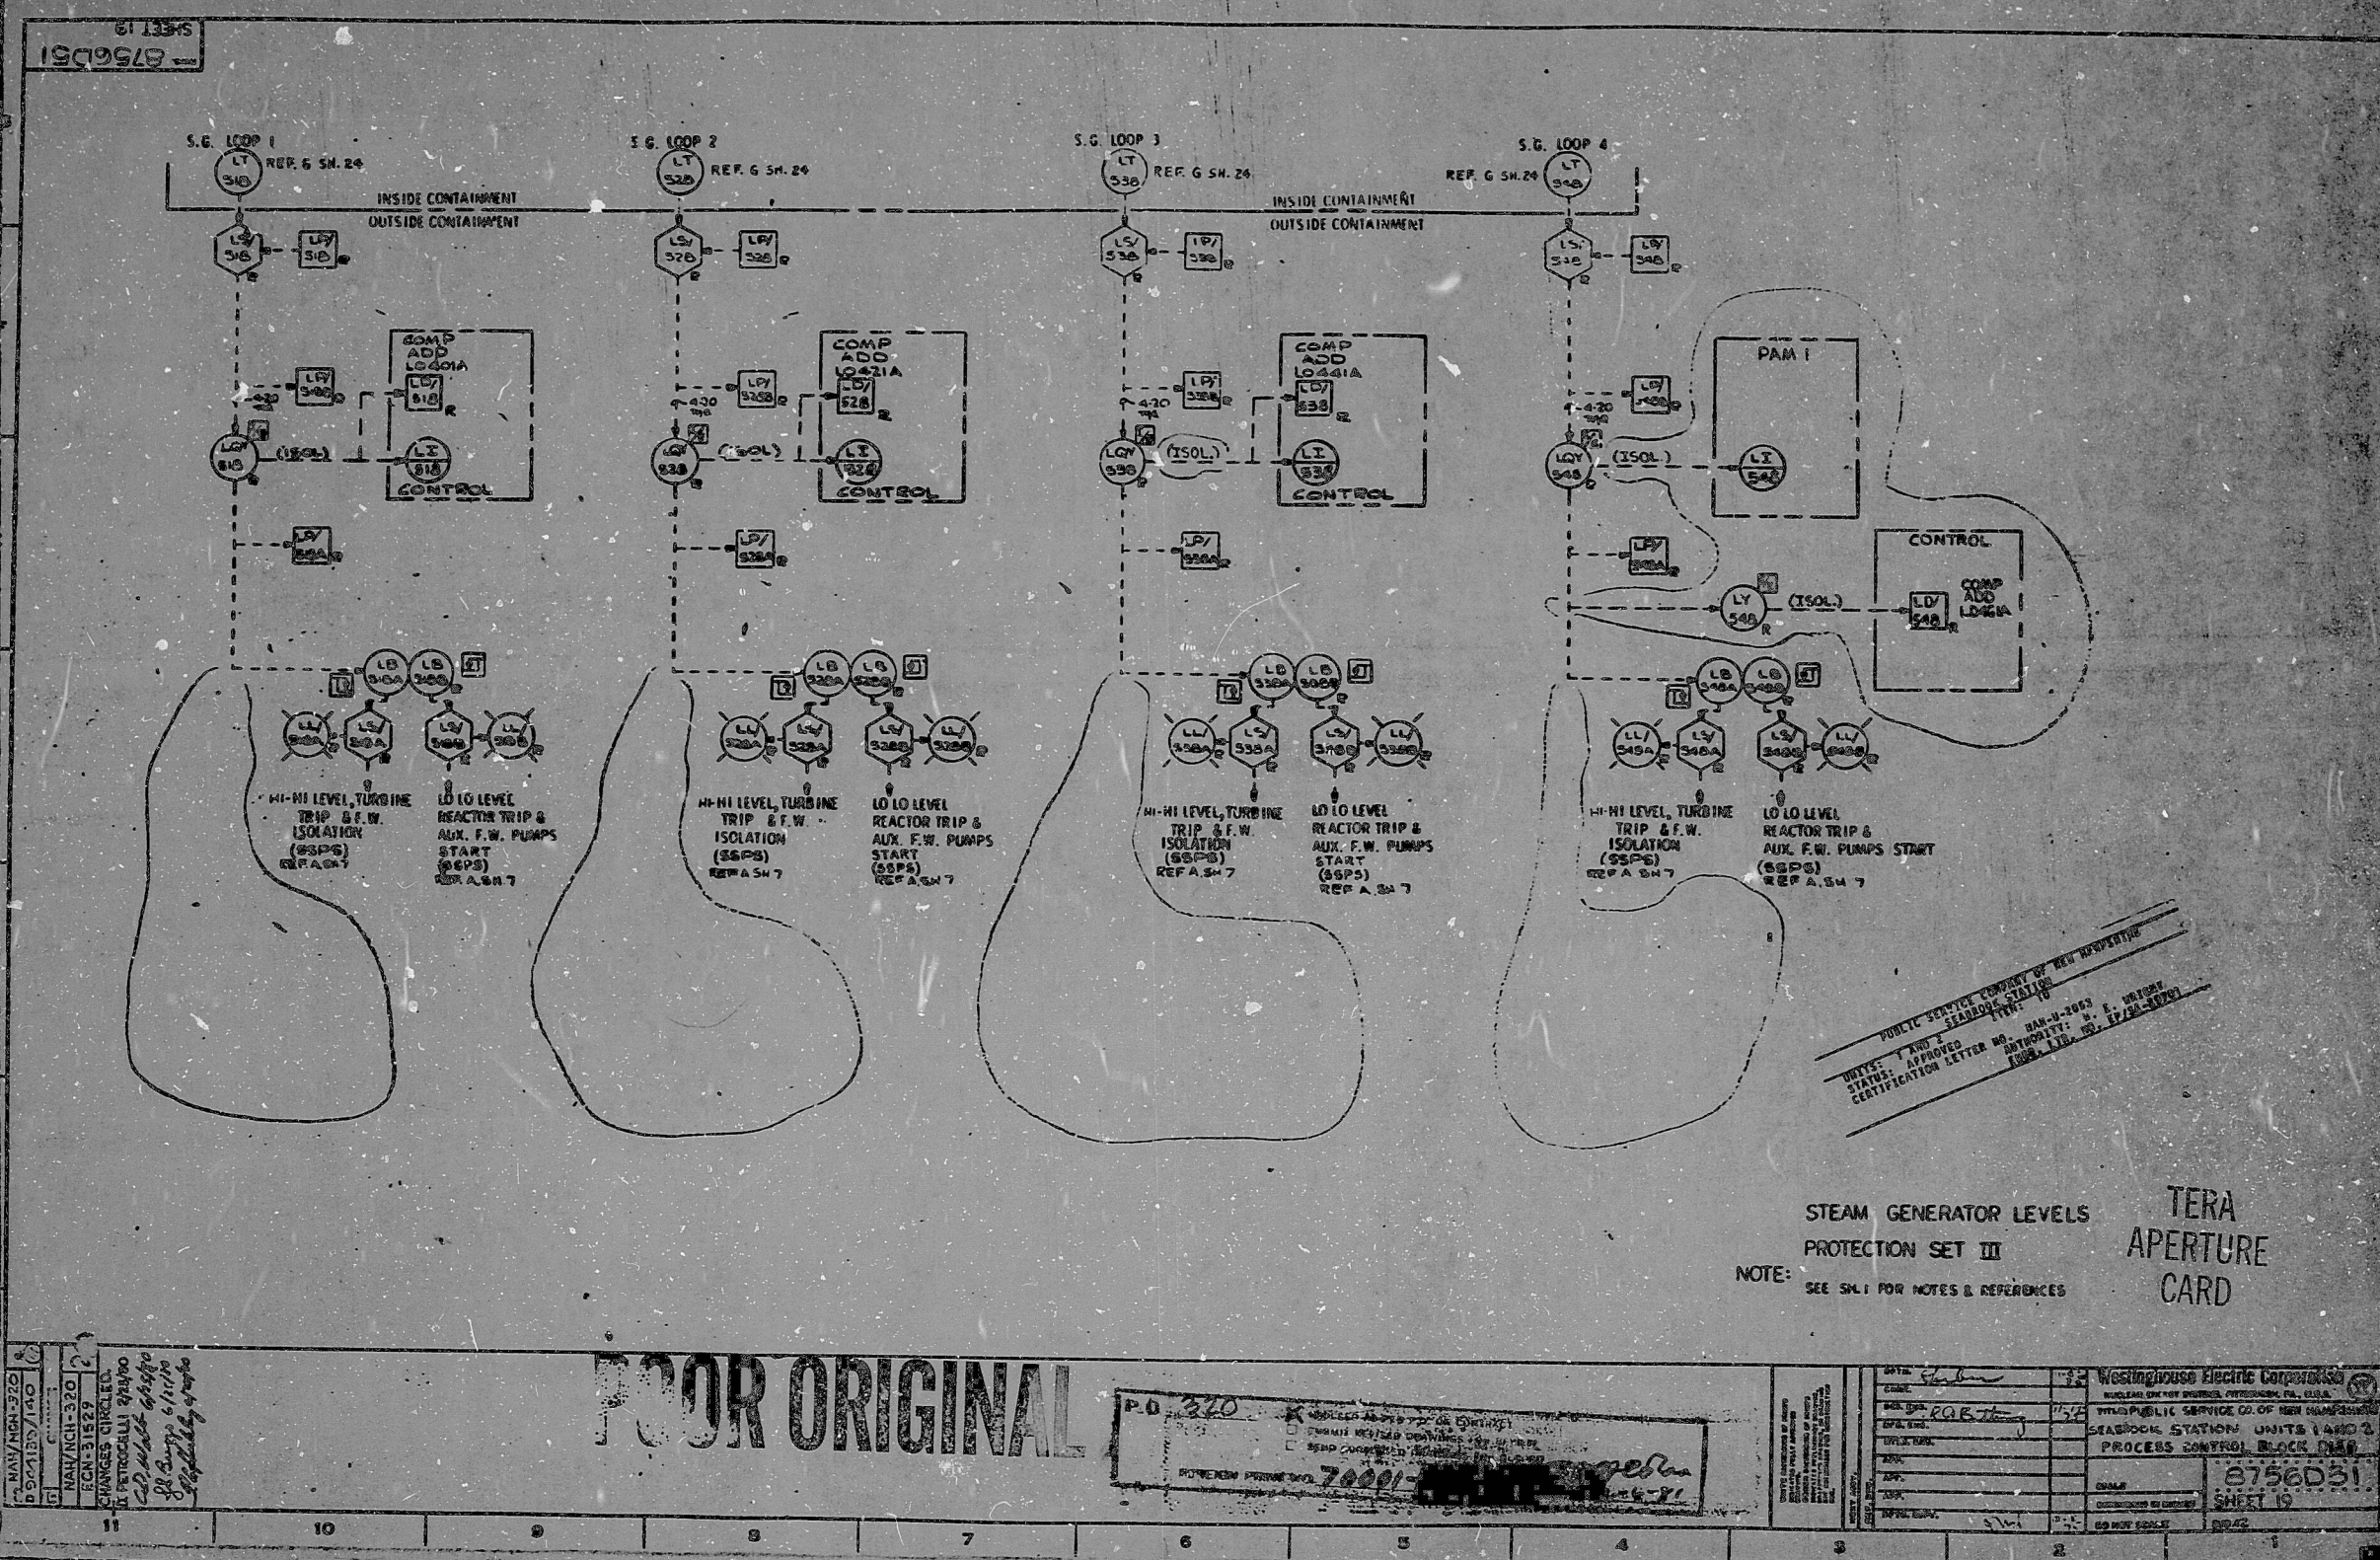

FOR ORIGINAL

P.O. 327

ATTENTION: **70001-100000** 100-4-81

STEAM GENERATOR LEVELS
PROTECTION SET III
SEE SM. I FOR NOTES & REFERENCES

TERA
APERTURE
CARD

DATE		
DATE		NAME
DATE		CONTINUED ON OTHERS
DATE		8756D31
DATE		SHEET 19

PDR

8111190627

