


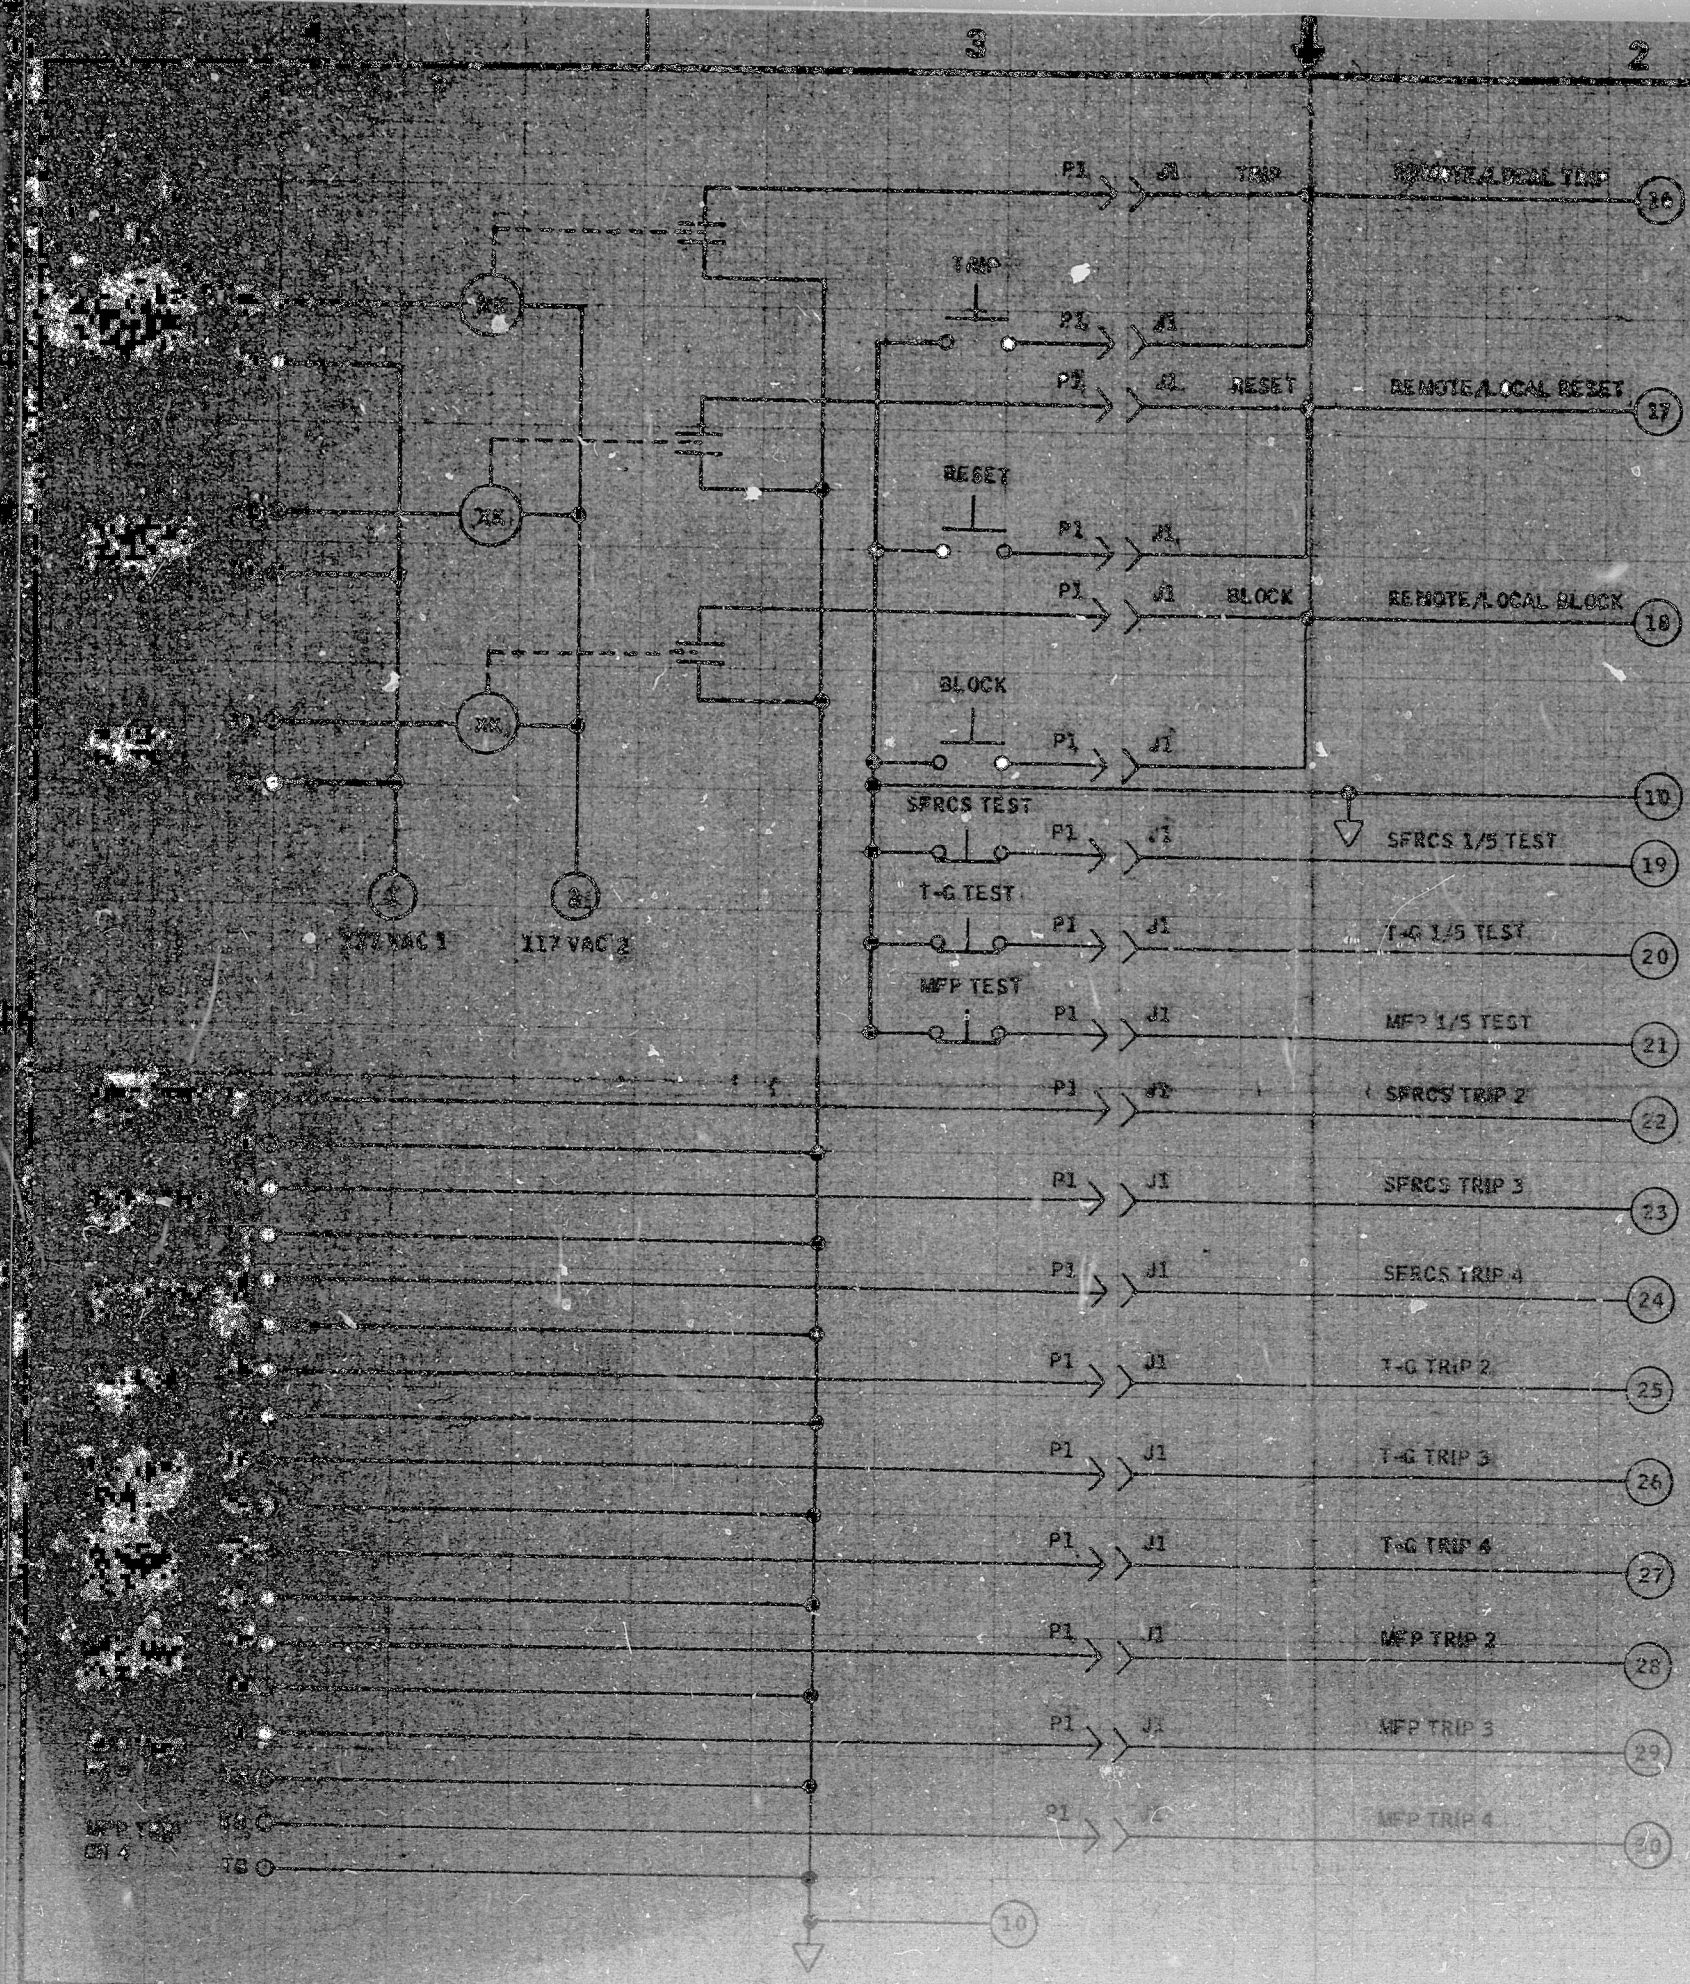

POOR ORIGINAL

RETEL COMPANY		DB NO. 7749
SUPPLIER DOCUMENT REVIEW STATUS		
REVIEW BY:		
☒ Approved for use		
☐ Not approved for use		
☐ Not reviewed		
☐ Not applicable		
REVIEW DATE:		
REVIEWED BY:		

COMMENT
ISSUE

RECEIVED
SEP 25 1981

711-240-707
E-241-19-3

SIZE	FORM NO.	3394-1015
C	99789	8111240707
SCALE		

ATTACH #6 (SC# 756)

TERA
APERTURE
CARD

RIDS

8111240707

