




STONE & WEBSTER ENGINEERING CORPORATION		MANUFACTURER'S DRAWING DATA FORM	
NINE MILE POINT NUCLEAR STATION - UNIT 2 NIAGARA MOHAWK POWER CORPORATION J.D. 11		RESP. ENG. J. CAREY	(E1)
INSTRUCTIONS TO SUPPLIER (E2) ✓ Comments as noted APPROVED AS REVISED SPECIFICATION RELEASED FOR FABRICATION		RESP. DES. ENG. B. RUSSELL	(E1)
RELEASED FOR MATERIAL PURCHASE		INSTRUCTIONS TO DESIGN (E1)	
Q REVISIONS N REVISED PRINTS T REVISED MICROFILM Y APERTURE CARDS		I-O INFORMATION ONLY P-L PRELIMINARY LAYOUT P-S PRODUCTION STUDIES R-G REVIEW AND COMMENT F-D FINAL DETAILS	
TO RESUBMIT FOR REVIEW FOR RECORD NONE REQUIRED		NEW NEW REV. REVISED	
NOTES: (E1) ✓ FOR INFORMATION ONLY RETURN TO SUPPLIER NOT REQUIRED		DATE TO DESIGN (C) 1-9-81	REQUIRED RETURN DATE (E1)
INSTRUCTIONS TO DESIGN (E1) DESIGN ENGINEER'S DATE STAMP (D) OUT: 11/19 JAN 19 1981 5:11 PM		DESIGN ENGINEER'S SIGNATURE (E1) W. J. Carey	DESIGN GROUP ROUTING (D)
INITIALS OF SELECTED REVIEWERS See Sepia		ROUTE	REQUIRED PRINT MAC
RESPONSIBLE ENGINEER'S DATE STAMP (E2) 11/19 JAN 19 1981 12:00 PM		ARCHITECTURE	
SUPERSEDES S.W. FILE NO. (E1) (1213-34) (38-38)		CIVIL	
REMARKS (LIMIT TO 20 CHARACTERS & BLANKS) (1213-34) T-1076 7.213-001-0648		CONCRETE	
S.W. EQUIP. ID. CODE (E1) 1155		STEEL	
AREA DESIGNATION CODES (E1) (1213-34) 801E152TY Rev 3		BUILDING SERVICE	
NPS'S ENG. NO. (LIMIT TO 10 CHARACTERS & BLANKS) (1213-34) 01102781		INSTRUMENT	
NPS'S NAME (LIMIT TO 20 CHARACTERS & BLANKS) (1213-34) GENERAL ELECTRIC		PIPE SUPPORT	
DATE (MM/DD/YY) (E1) (1213-34) 01/02/81		STRESS	
TYPE (E1) (1213-34) NUC STEAM SUPPLY SHUTOFF		MACHINE DESIGN/V. LENSEL	
FUNCTIONALITY (E1) (1213-34) NUC STEAM SUPPLY SHUTOFF		NOTE: ELECTRICAL 1981 6.4 LINE	
S.W. FILE NO. (E1) (1213-34) 12177 00		LIGHTING	
JOB ORDER NO. (E1) (1213-34) 12177 00		MODEL SHOP	
		EXTENSION OFFICE	
		CONTROL	
		(C) PROJECT CLERK (E1) RESP. DESIGN ENGINEER (E2) RESP. ENGINEER - ON DDD RECEIPT (E3) RESP. ENGINEER - AFTER TWO REVIEW MAC - MICROFILM APERTURE CARD R/W - REVIEWER INITIALS	
		ATTACH TO MFR'S DRAWING	

RIDS

8304270474

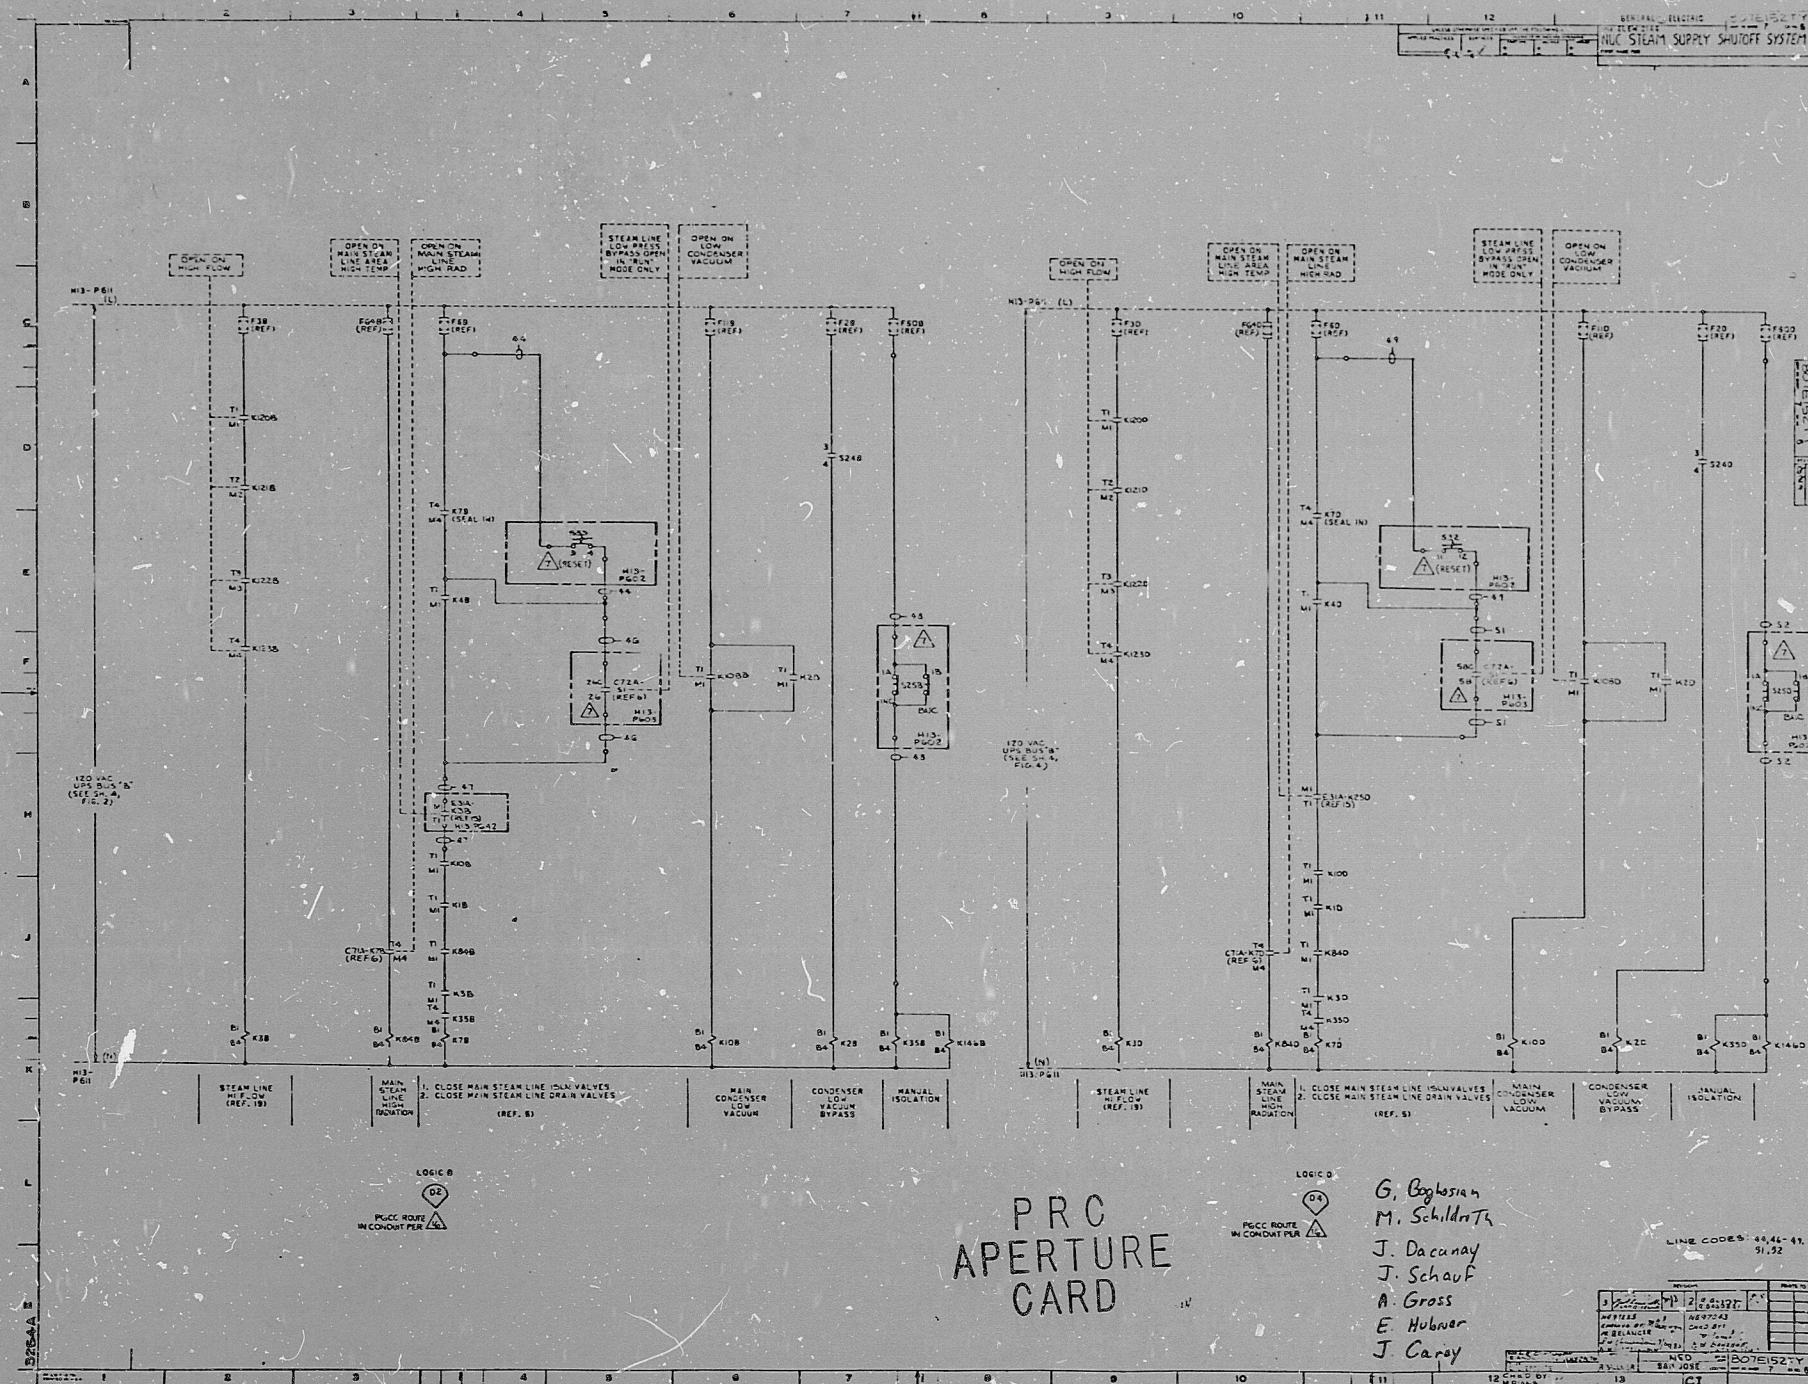