


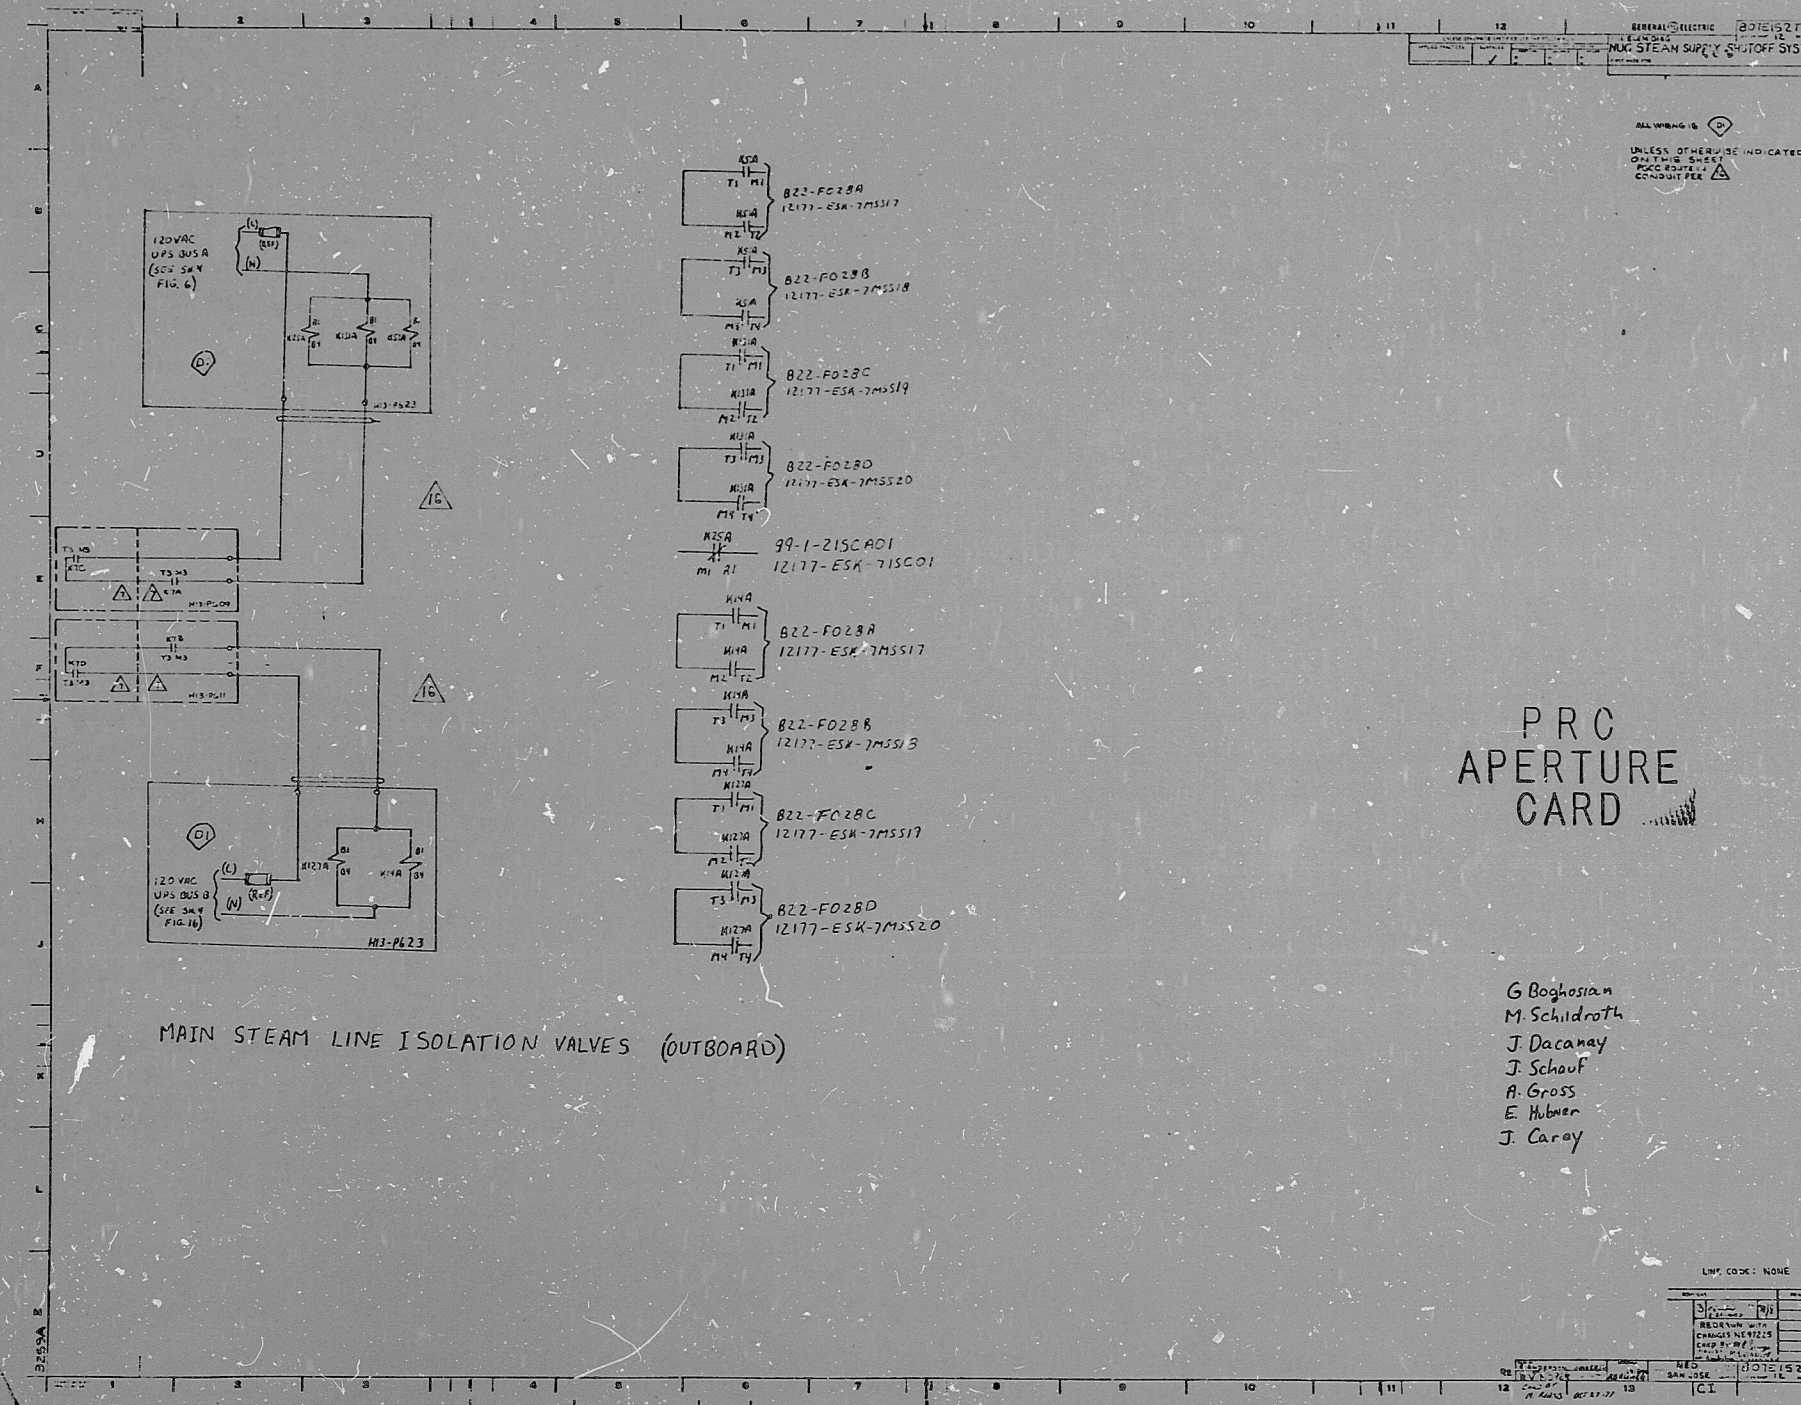

PRC
APERTURE
CARD

G. Boghosian
M. Schildroth
J. Dacanay
J. Schauf
A. Gross
E. Hubner
J. Carey

STONE & WEBSTER ENGINEERING CORPORATION NINE MILE POINT NUCLEAR STATION - UNIT 2 NIAGARA MOHAWK POWER CORPORATION J. O. 1977		MANUFACTURER'S DRAWING DATA FORM	
INSTRUCTIONS TO SUPPLIER (E2) ✓ COMMENTS AS NOTED APPROVED AS REVISED SPECIFICATION RELEASED FOR FABRICATION RELEASED FOR MATERIAL PURCHASE		NAME RESP. ENG. J. CAREY (E1) RESP. DES. ENG. R. RUSSELL (E1) INSTRUCTIONS TO DESIGN (E1)	
SUPPLIER TO RESUBMIT FOR REVIEW FOR RECORD NONE REQUIRED		I-D INFORMATION ONLY P-L PRELIMINARY LAYOUT P-S PRODUCTION STUDIES R-G REVIEW AND COMMENT F-D FINAL DETAILS NEW REV. REVISED	
NOTES: FOR INFORMATION ONLY RETURN TO SUPPLIER NOT REQUIRED		DATE TO DESIGN (C) 1-9-81 REQUIRED RETURN DATE (E1)	
DESIGN ENGINEER'S DATE STAMP (D) OUT. NOTED JAN 1 6 1981 C.A. LANE		DESIGN GROUP ROUTING (D)	
INITIALS OF SELECTED REVIEWERS See SCPIA		ROUTE ✓ ARCHITECTURE CIVIL CONCRETE STEEL BUILDING SERVICE INSTRUMENT MECHANICAL PIPE SUPPORT STRESS MACHINE DESIGN/VESSEL ELECTRICAL LIGHTING MODEL SHOP EXTENSION OFFICE CONTROL	
RESPONSIBILITY ENGINEER'S DATE STAMP (E2) NOTED APR 1 3 1981 J.O. 1977		REQUIRED PRINT MAC	
SUPERSEDES S.S.W. FILE NO. (E1) 12177-ESK-7M5517 (121-80)		S.S.W. FILE NO. (E1) 12177-ESK-7M5517 (121-80)	
MFR'S NAME (LIMIT 20 CHARACTERS & BLANKS) (E1) 12177-ESK-7M5517		MFR'S DWG. NO. (LIMIT 20 CHARACTERS & BLANKS) (E1) 12177-ESK-7M5517	
DATE (MONTH DAY YEAR) (E1) 01 07 81		TIME (HOUR MINUTE) (E1) 14 00	
FUNCTIONAL TITLE (E1) GENERAL ELECTRIC		PROJECT CLERK (E1) 12177-ESK-7M5517	
JOB ORDER NO. 12177-ESK-7M5517		ATTACH TO MFR'S DRAWING	

RIDS

8304270481

