


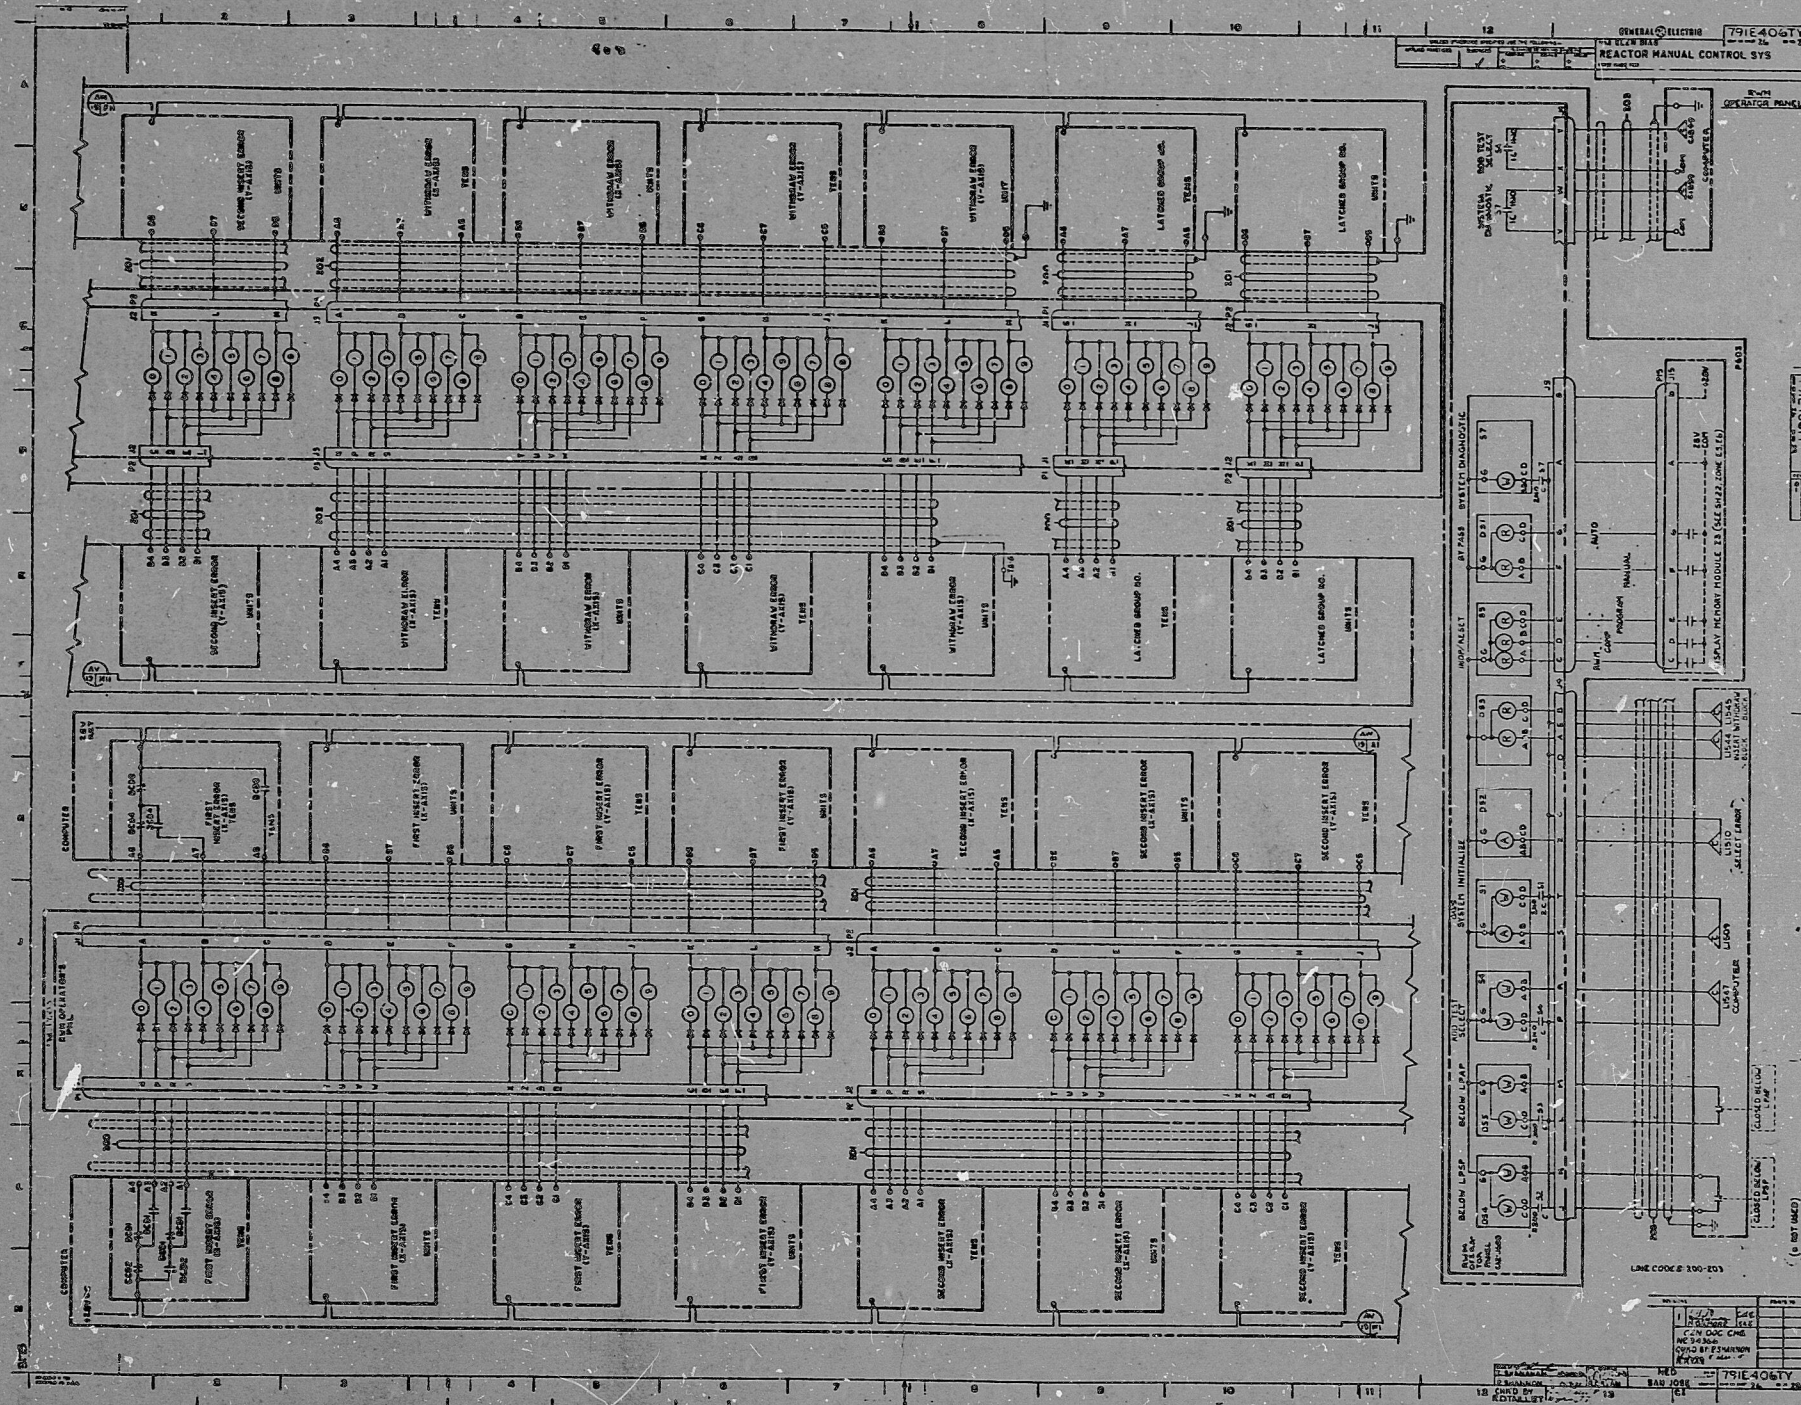

PRC
APERTURE
CARD

STONE & WEBSTER ENGINEERING CORPORATION NINE MILE POINT NUCLEAR STATION - UNIT 2 NIAGARA MOHAWK POWER CORPORATION J.O. 12177		MANUFACTURER'S DRAWING DATA FORM	
INSTRUCTIONS TO SUPPLIER (E2) APPROVED AS REVISED SPECIFICATION RELEASED FOR MATERIAL PURCHASE RELEASED FOR MATERIAL PURCHASE		RESP EN N. SNIPELISHSKAYA (E1) RESP P.S. ENG B. RUSSELL (E1) INSTRUCTIONS TO DESIGN (E1)	
SUPPLIER TO RESUBMIT FOR REVIEW FOR RECORD NONE REQUIRED		I-O INFORMATION ONLY P-L PRELIMINARY LAYOUT P-S PRODUCTION STUDIES R-G REVIEW AND COMMENT F-D FINAL DETAILS NEW NEW REV REVISED	
NOTES Commit as noted		DATE TO DESIGN (C) 4-6-81 REQUIRED RETURN DATE (E1)	
DESIGN GROUP ROUTING (1) DESIGN GROUP ROUTING (1)		DESIGN GROUP ROUTING (1)	
INITIALS OF SELECTED REVIEWERS RESPONSIBLE ENGINEER'S DATE STAMP (E2) NOTED NOV 13 1981 J.O. 12177		ARCHITECTURE CIVIL CONCRETE STEEL BUILDING SERVICE INSTRUMENT MECHANICAL PIPE SUPPORT STRESS MACHINE DESIGN/VESSEL ELECTRICALS 1331 K.L. 1331 LIGHTING MODEL SHOP EXTENSION OFFICE CONTROL	
SUPERSEDES S.W. FILE NO. (E1) (E2) (E3) (E1824)			

8395020153

