


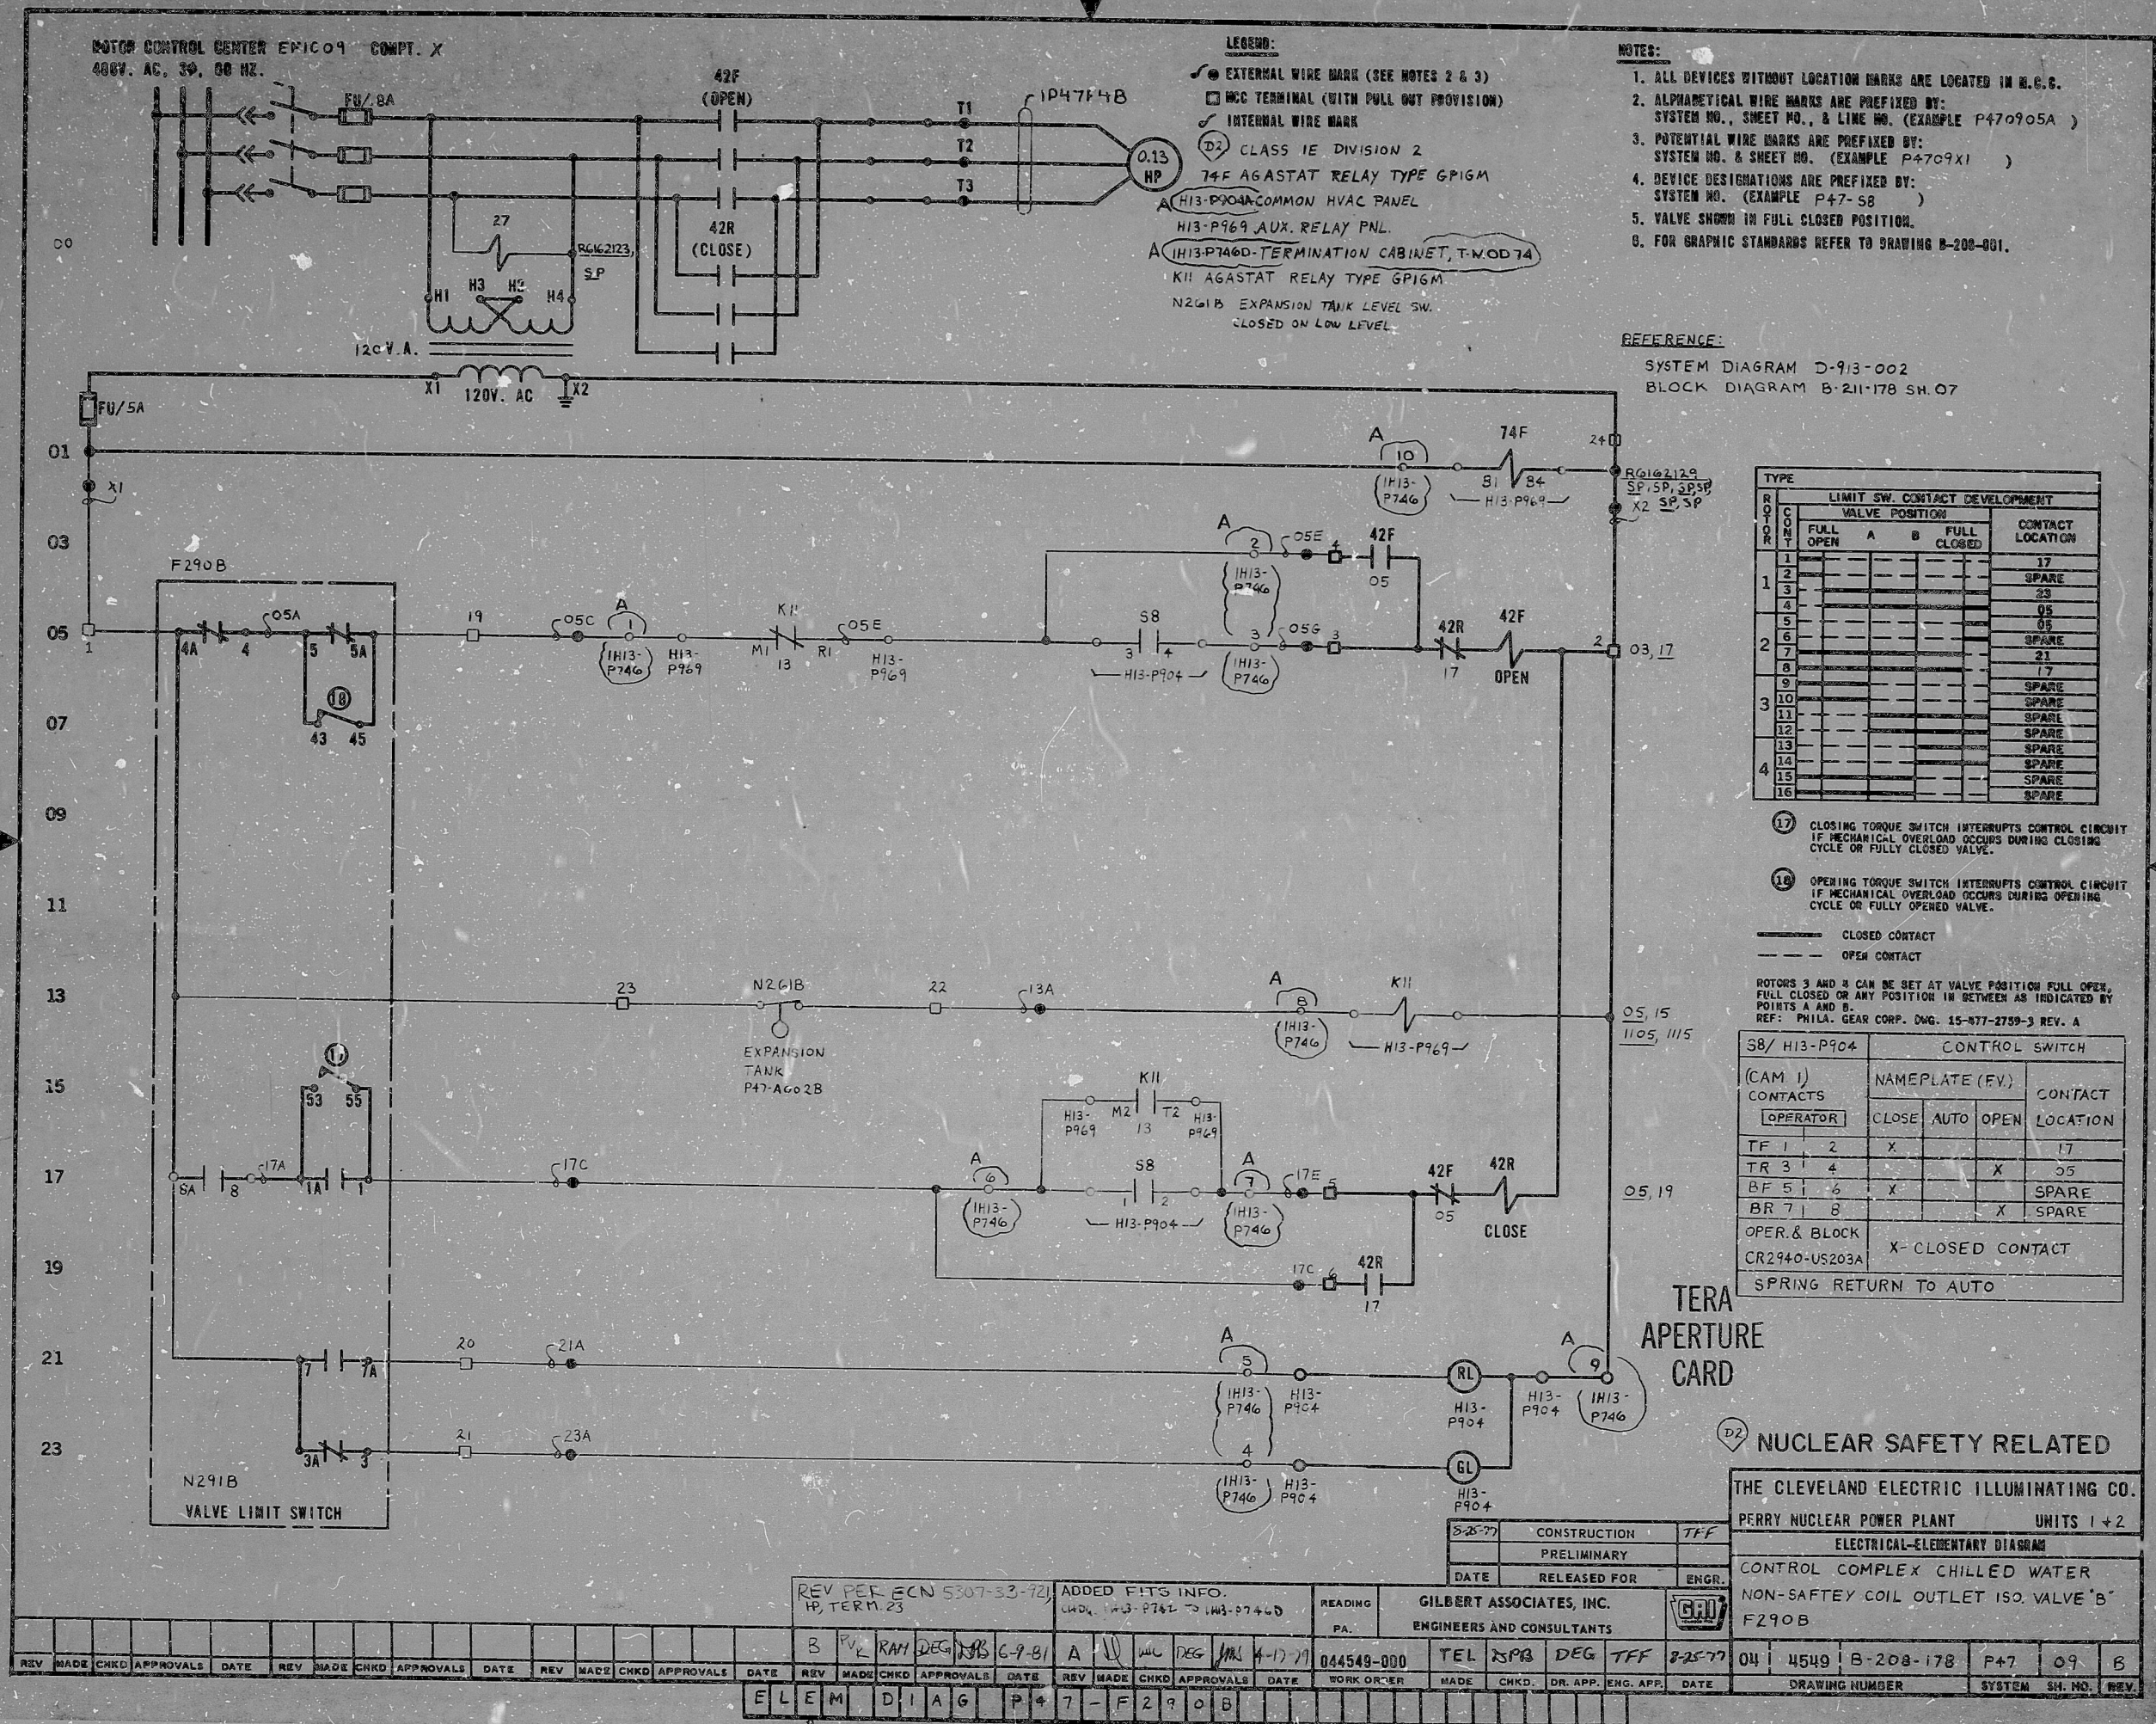



RIDS

812010776

