


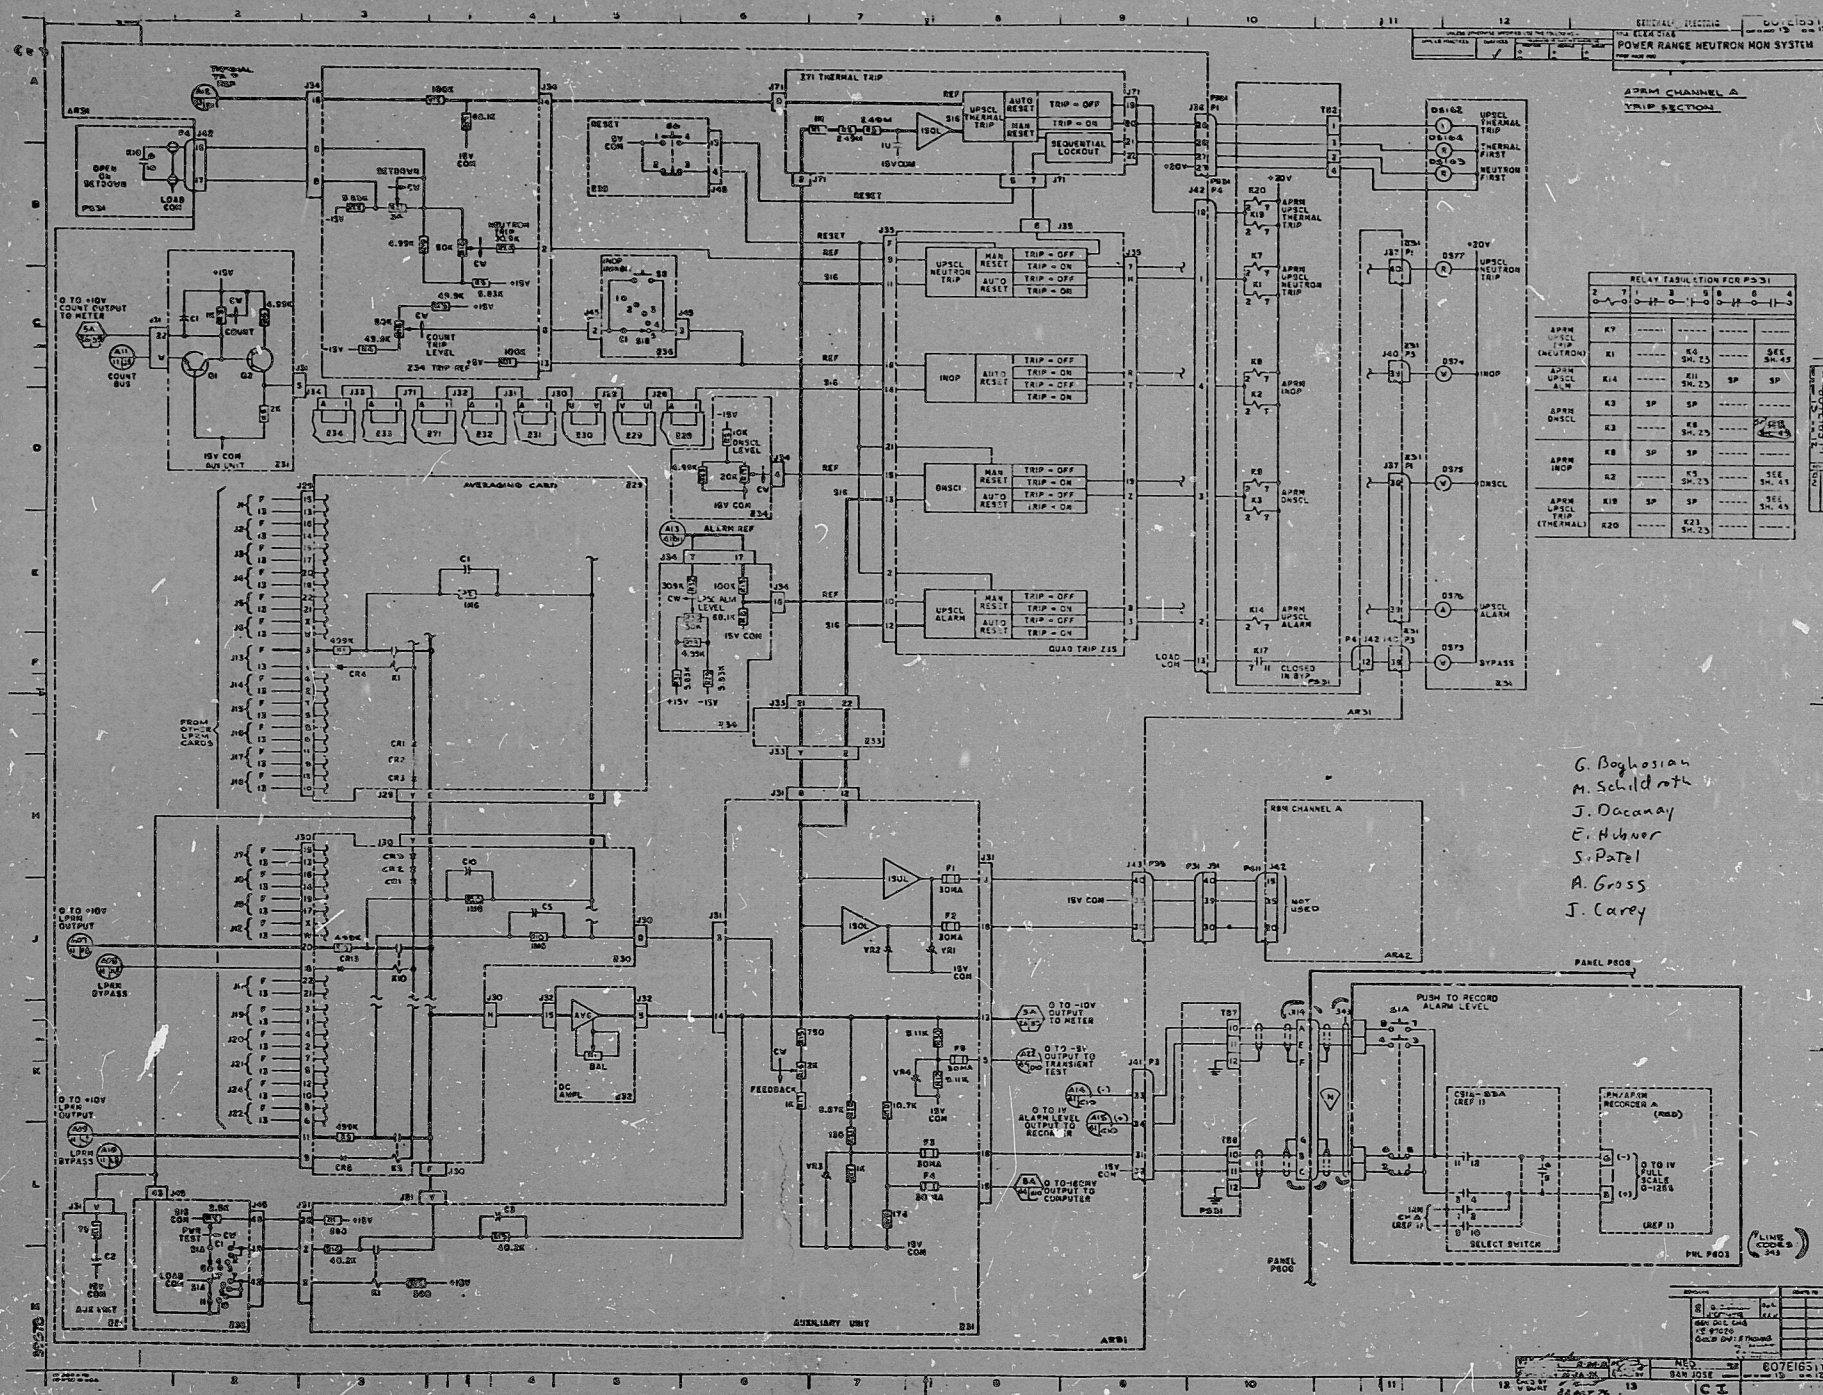

PRC APERTURE CARD

STONE & WEBSTER ENGINEERING CORPORATION NINE MILE POINT NUCLEAR STATION - UNIT 2 NIAGARA MOHAWK POWER CORPORATION J. O. 12177		MANUFACTURER'S DRAWING DATA FORM	
INSTRUCTIONS TO SUPPLIER (E2) APPROVED AS REVISED IN SPECIFICATION RELEASED FOR FABRICATION RELEASED FOR MATERIAL PURCHASE		RESP ENG J. CAREY (E1) RESP DES ENG B. RUSSELL (E1) INSTRUCTIONS TO DESIGN (E1)	
SUPPLIER TO: R. SUBMIT FOR REVIEW FOR RECORD NONE REQUIRED		INFORMATION ONLY PRELIMINARY LAYOUT PRODUCTION STUDIES REVIEW AND COMMENT FINAL DETAILS NEW REVISED	
NOTES: (E1) FOR INFORMATION ONLY RETURN TO SUPPLIER NOT REQUIRED		DATE TO DESIGN 12-1981 REQUIRED RETURN DATE (E1) DESIGN ENGINEER'S DATE STAMP (D) IN: NOTED 12 12 1981 C.A. LANE	
DESIGN ENGINEER'S DATE STAMP (D) NOTED MAR 30 1981 C.A. LANE		DESIGN GROUP ROUTING (D)	
INITIALS OF SELECTED REVIEWERS SEE SEP 19 RESPONSIBLE ENGINEER'S DATE STAMP (E2) NOTED APR 2 6 1981 J.D. CAREY		ARCHITECTURE CIVIL CONCRETE STEEL BUILDING SERVICE INSTRUMENT MECHANICAL PIPE SUPPORT STRESS MACHINE DESIGN/VESSEL LIGHTING MODEL SHOP EXTENSION OFFICE CONTROL	
SUPERSEDES S.G.W. FILE NO. (E1) 12177-101 T-1076 S.G.W. EQUIP. ID. CODE (E1) MFR'S DWG NO. (LIMIT TO 20 CHARACTERS & BLANKS) (E1-101) MFR'S NAME (LIMIT TO 20 CHARACTERS & BLANKS) (E1-101) DATE (MM/DD/YY) 02/11/81 FUNCTIONAL TITLE (E1) POWER RANGE NEUTRON MONITORING SYS		(E1) PRODUCT ENGINEER (E1) RESP. DESIGN ENGINEER (E1) RESP. ENGINEER - ON OWN DECEIT (E1) RESP. ENGINEER - AFTER OWN REVIEW (E1) MICROFILM APERTURE CARD (E1) RET-REVIEWER INITIALS	
D & S FILE NO. (E1) JOB ORDER NO. 12177 00		ATTACH TO MFR'S DRAWING	

G. Boghosian
M. Schilder
J. Dacanay
E. Hubner
S. Patel
A. Gross
J. Carey

RIDS

8305020286

