


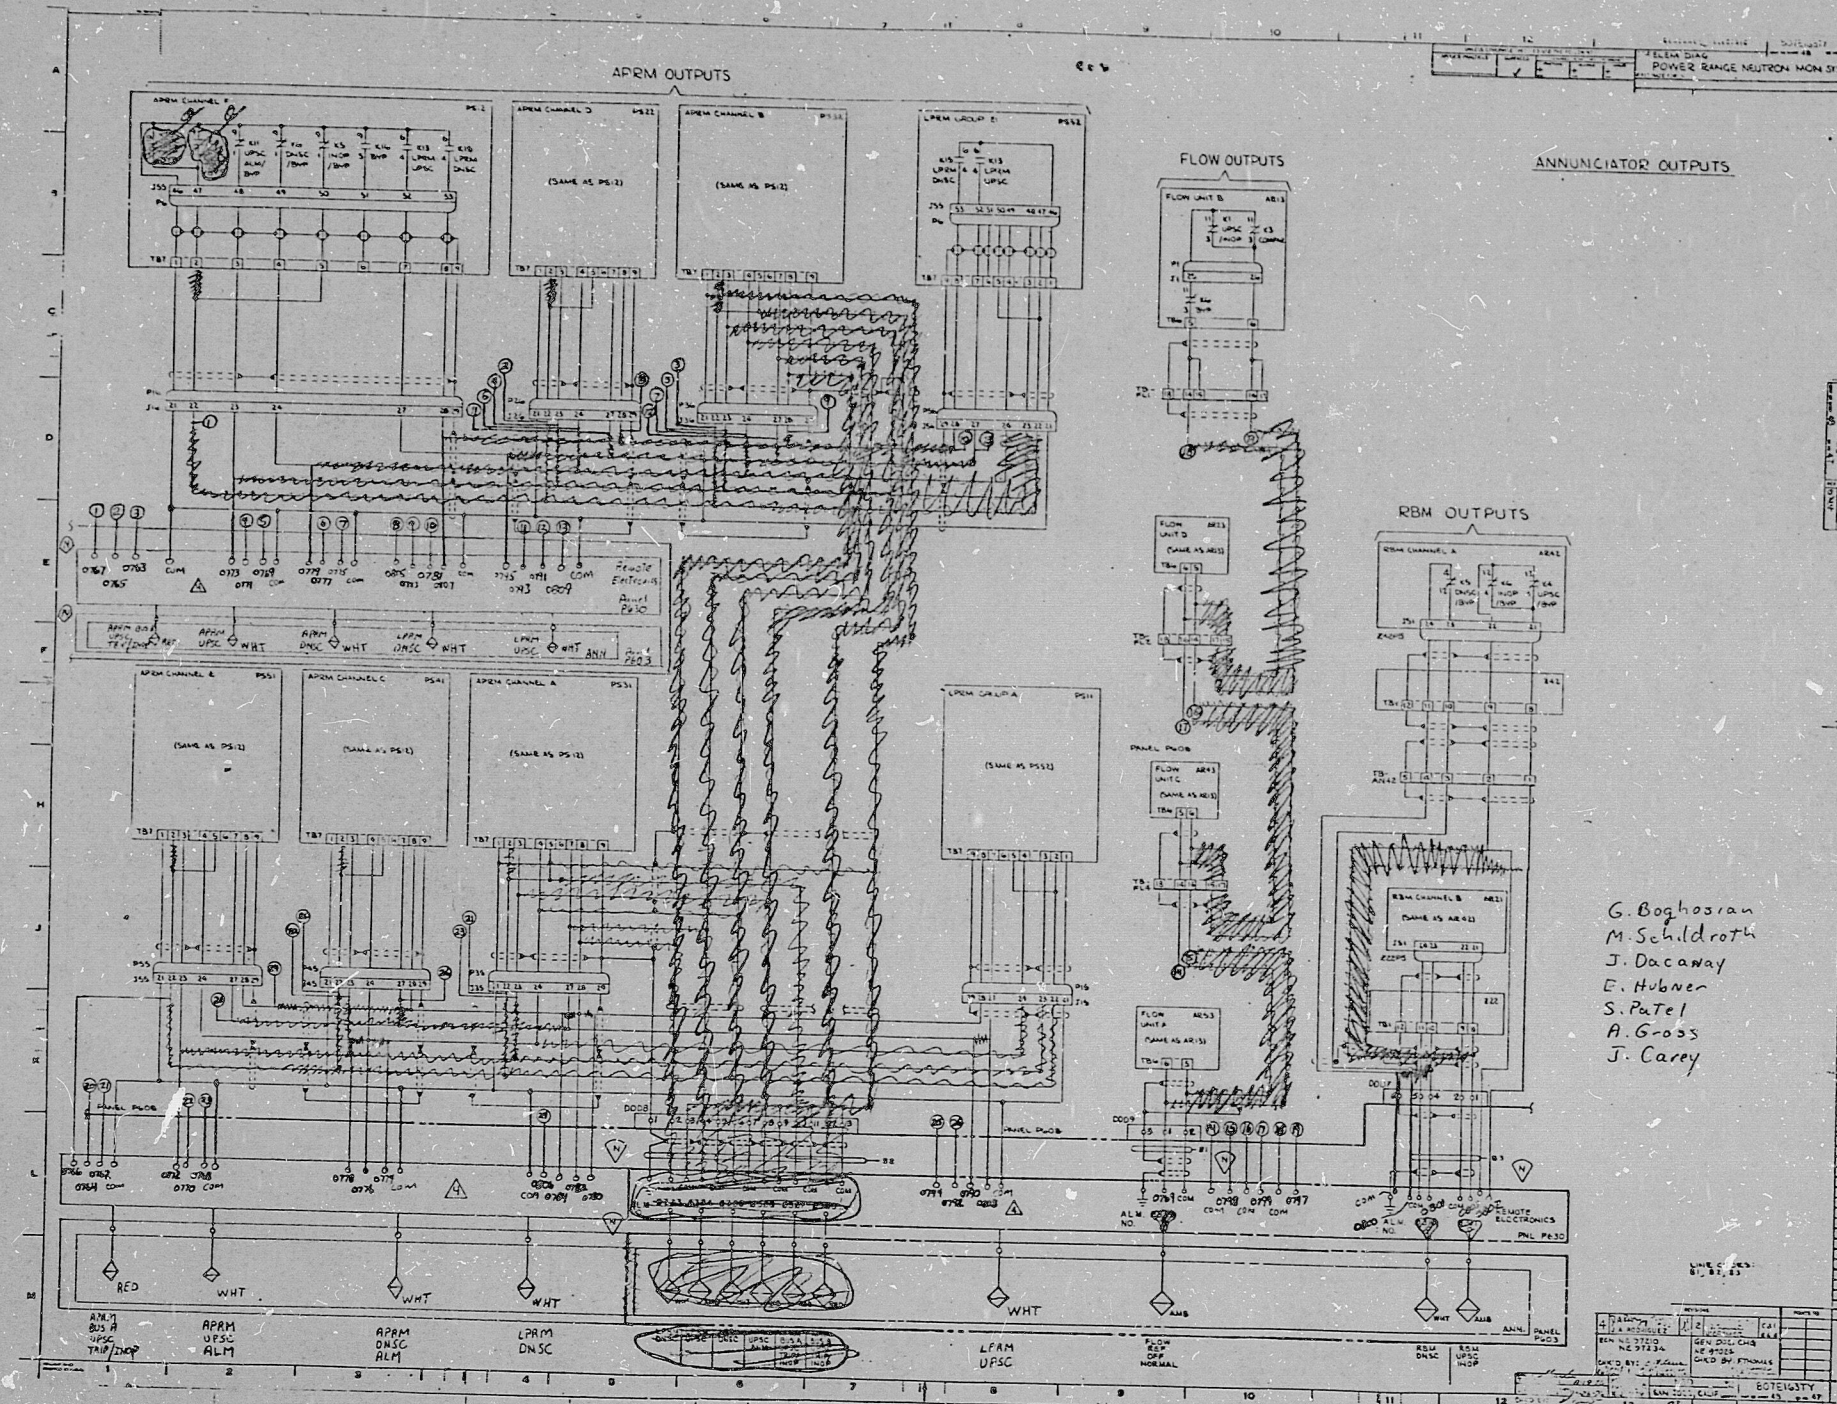

PRC APERTURE CARD

STONE & WEBSTER ENGINEERING CORPORATION NINE MILE POINT NUCLEAR STATION - UNIT 2 NIAGARA MOHAWK POWER CORPORATION 10 10177		MANUFACTURER'S DRAWING DATA FORM	
INSTRUCTIONS TO SUPPLIER (E2) ☒ COMMENTS AS NOTED APPROVED AS DEFINED IN SPECIFICATION APPROVED AS REVISED SPECIFICATION RELEASED FOR FABRICATION RELEASED FOR MATERIAL PURCHASE		RESP. ENG. J. CAREY (E1) RESP. DES. ENG. B. RUSSELL (E1) INSTRUCTIONS TO DESIGN (E1) P.O. INFORMATION ONLY P.L. PRELIMINARY LAYOUT P.S. PRODUCTION STUDIES P.R.C. REVIEW AND COMMENT P.D. FINAL DETAILS NEW: NEW REV: REVISED	
NOTES: (E1) FOR INFORMATION ONLY RETURN TO SUPPLIER NOT REQUIRED		DATE TO DESIGN (C) 1-13-81 REQUIRED RETURN DATE (E1) DESIGN ENGINEER'S DATE STAMP (D) IN 10177 1-2 1981 C.A. LANE DESIGN GROUP ROUTING (D)	
DESIGN ENGINEER'S DATE STAMP (E2) NOTED APR 26 1981 J.D. CAREY SUPERSEDES S.G.W. FILE NO. (E1) 10177-1 (10177-1) REMARKS (C) LIMIT TO 20 CHARACTERS & BLANKS (10177-1) 1-1076 S.G.W. EQUIP. I.D. CODE (E1) 21415 11 1111 M.P.R. S.G.W. NO. (C) LIMIT TO 24 CHARACTERS & BLANKS (10177-1) 8071637Y REV 4 2647 M.P.R. NAME (C) LIMIT TO 20 CHARACTERS & BLANKS (10177-1) GENERAL ELECTRIC DATE MONTH DAY YEAR (E1) 10177 1 1 1981 M.P.R. NO. (E1) 10177 1 1 1981 FUNCTIONAL TITLE (E1) POWER RANGE NEUTRON MONITORING S.G.W. FILE NO. (E1) JOB ORDER NO. 12177 100		ARCHITECTURE CIVIL CONCRETE STEEL BUILDING SERVICE INSTRUMENT MECHANICAL PIPE SUPPORT STRESS MACHINE DESIGN/VESSEL LIGHTING MODEL SHOP EXTENSION OFFICE CONTROL (C) PROJECT CLERK (E1) RESP. ENGINEER - ON OWN RECEIPT (E2) RESP. ENGINEER - AFTER OWN REVIEW M.P.R. MICROFILM APERTURE CARD S.G.W. REVIEWER INITIALS	

ATTACH TO M.P.R. DRAWING

RIDS

8305030058

