




RIDS

8112020356

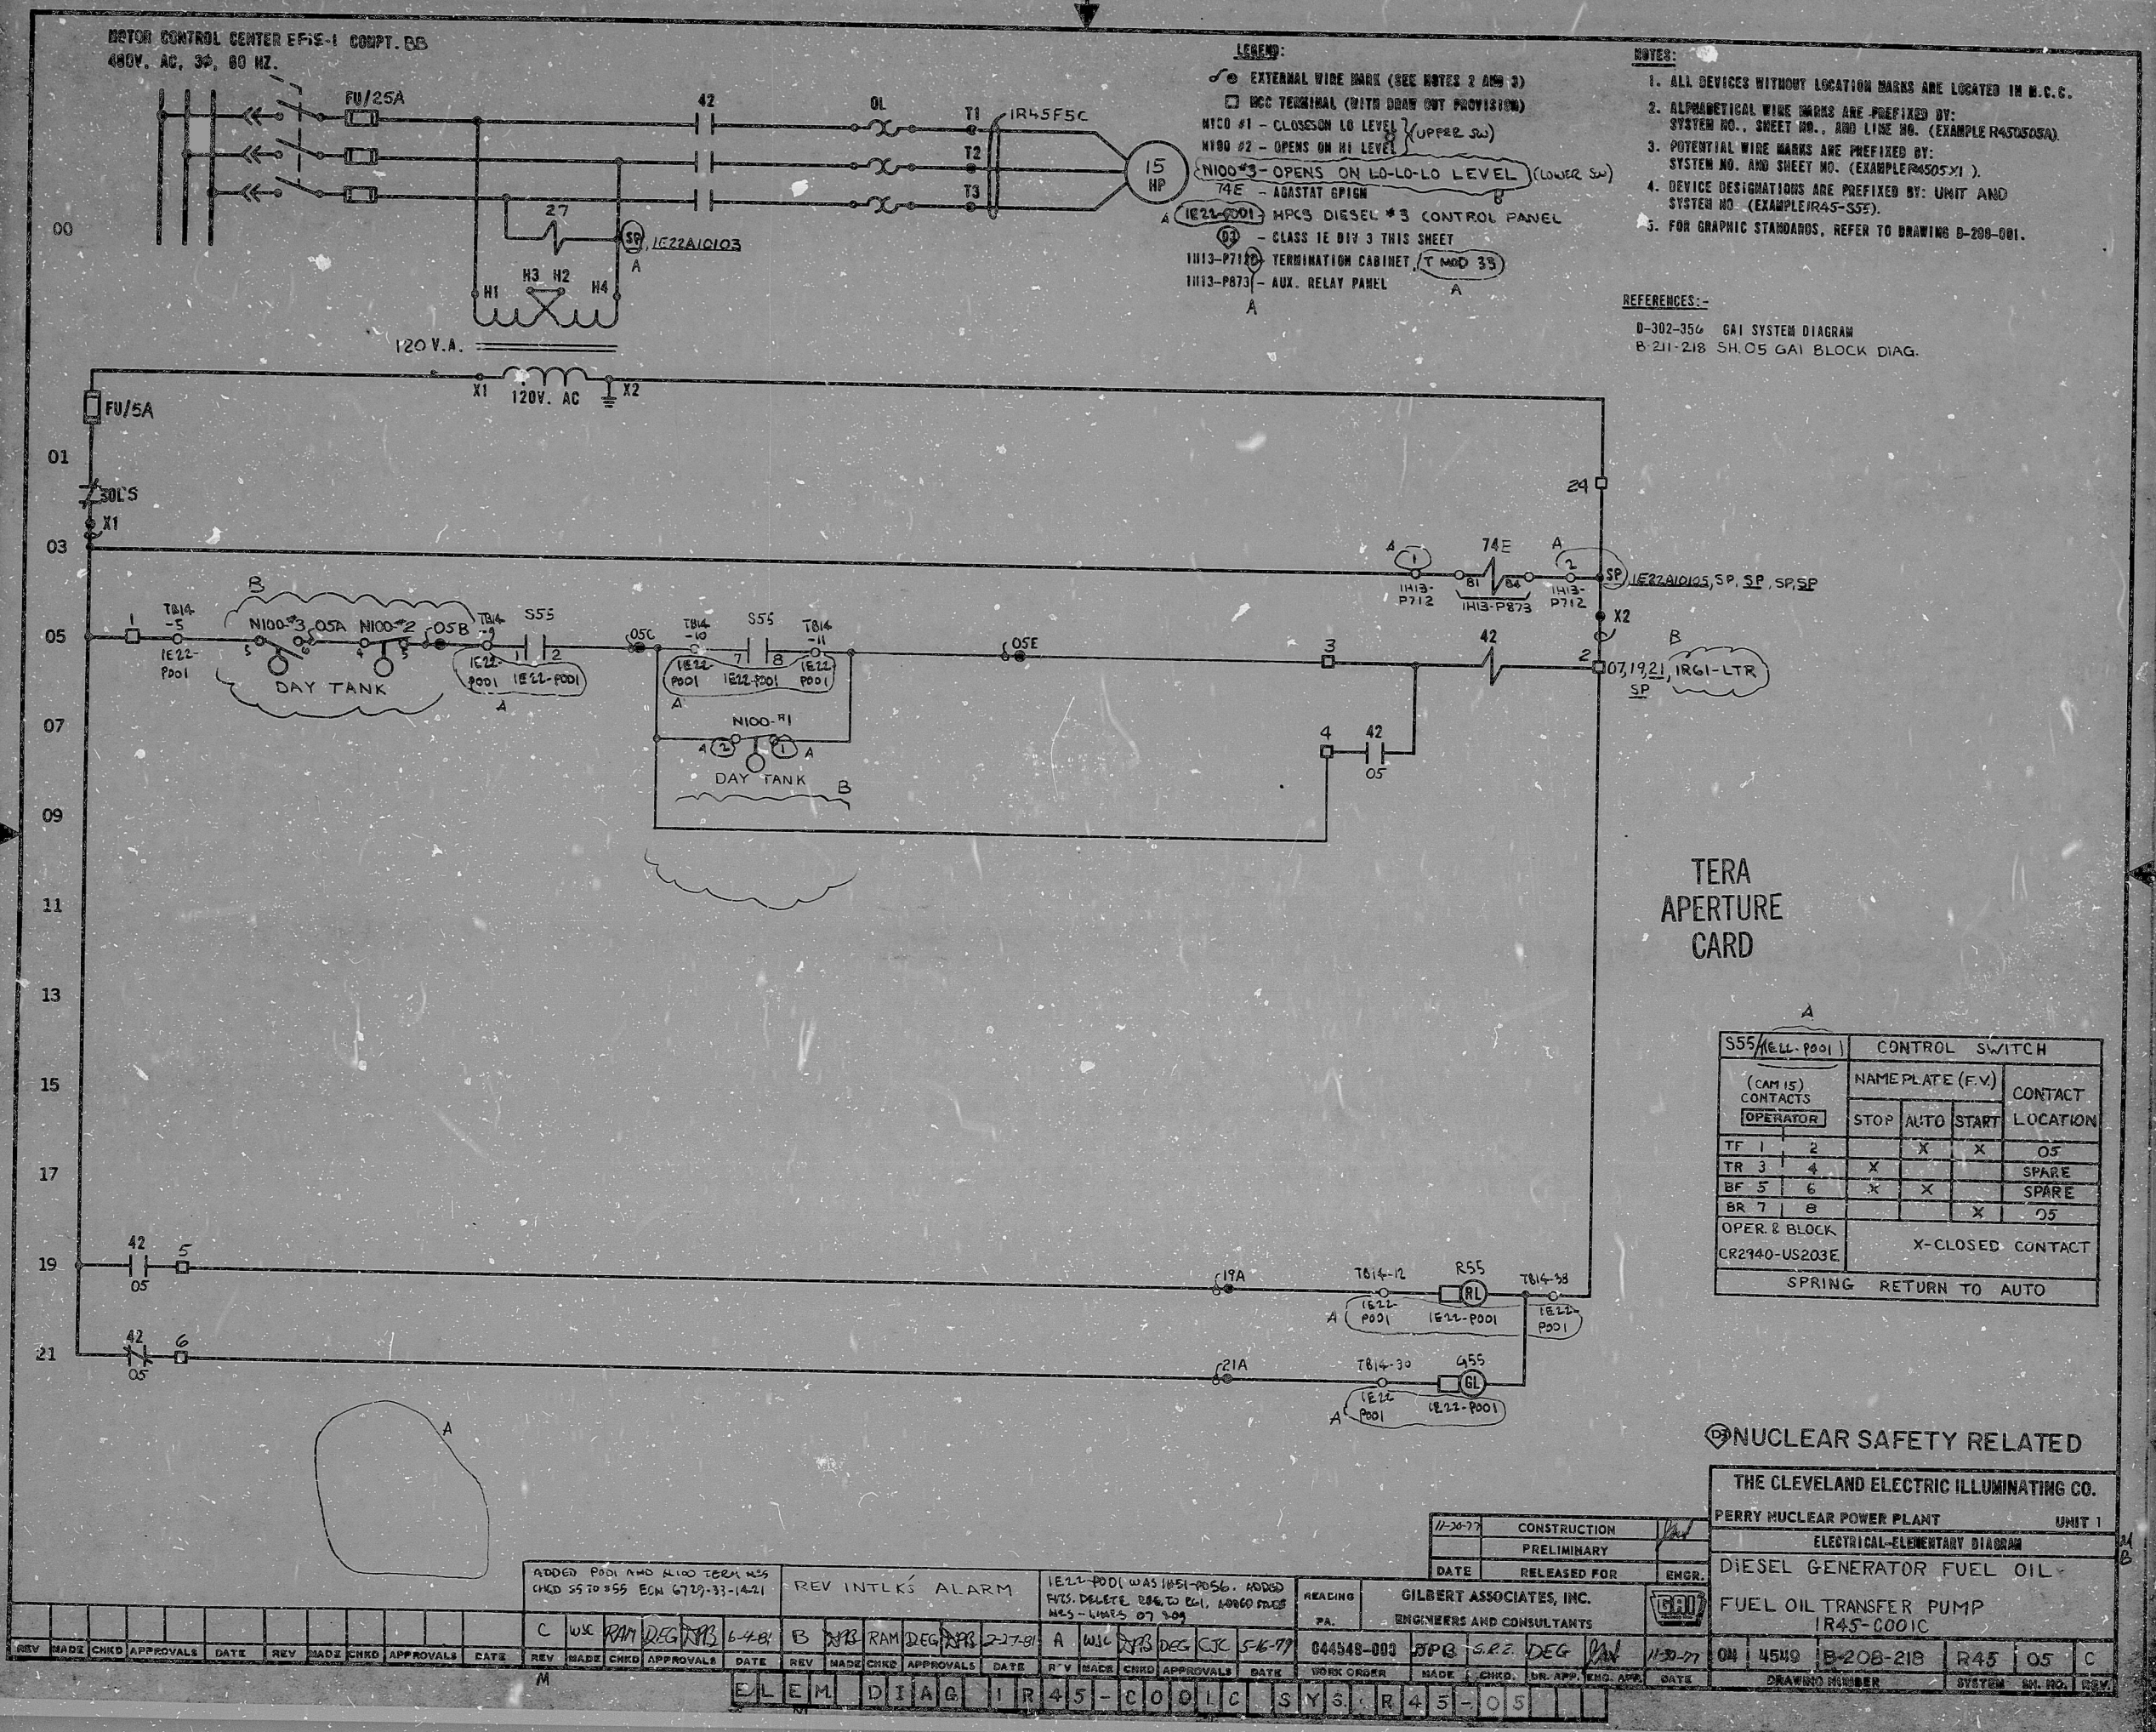